



DATE	
BY	
FINAL SURVEY	
SURVEYED	
PLOTTED	
NOTED	
AREAS	
CHECKED	
NO.	

DATE	
BY	
ORIGINAL SURVEY	
SURVEYED	
PLOTTED	
NOTED	
AREAS	
CHECKED	
NO.	

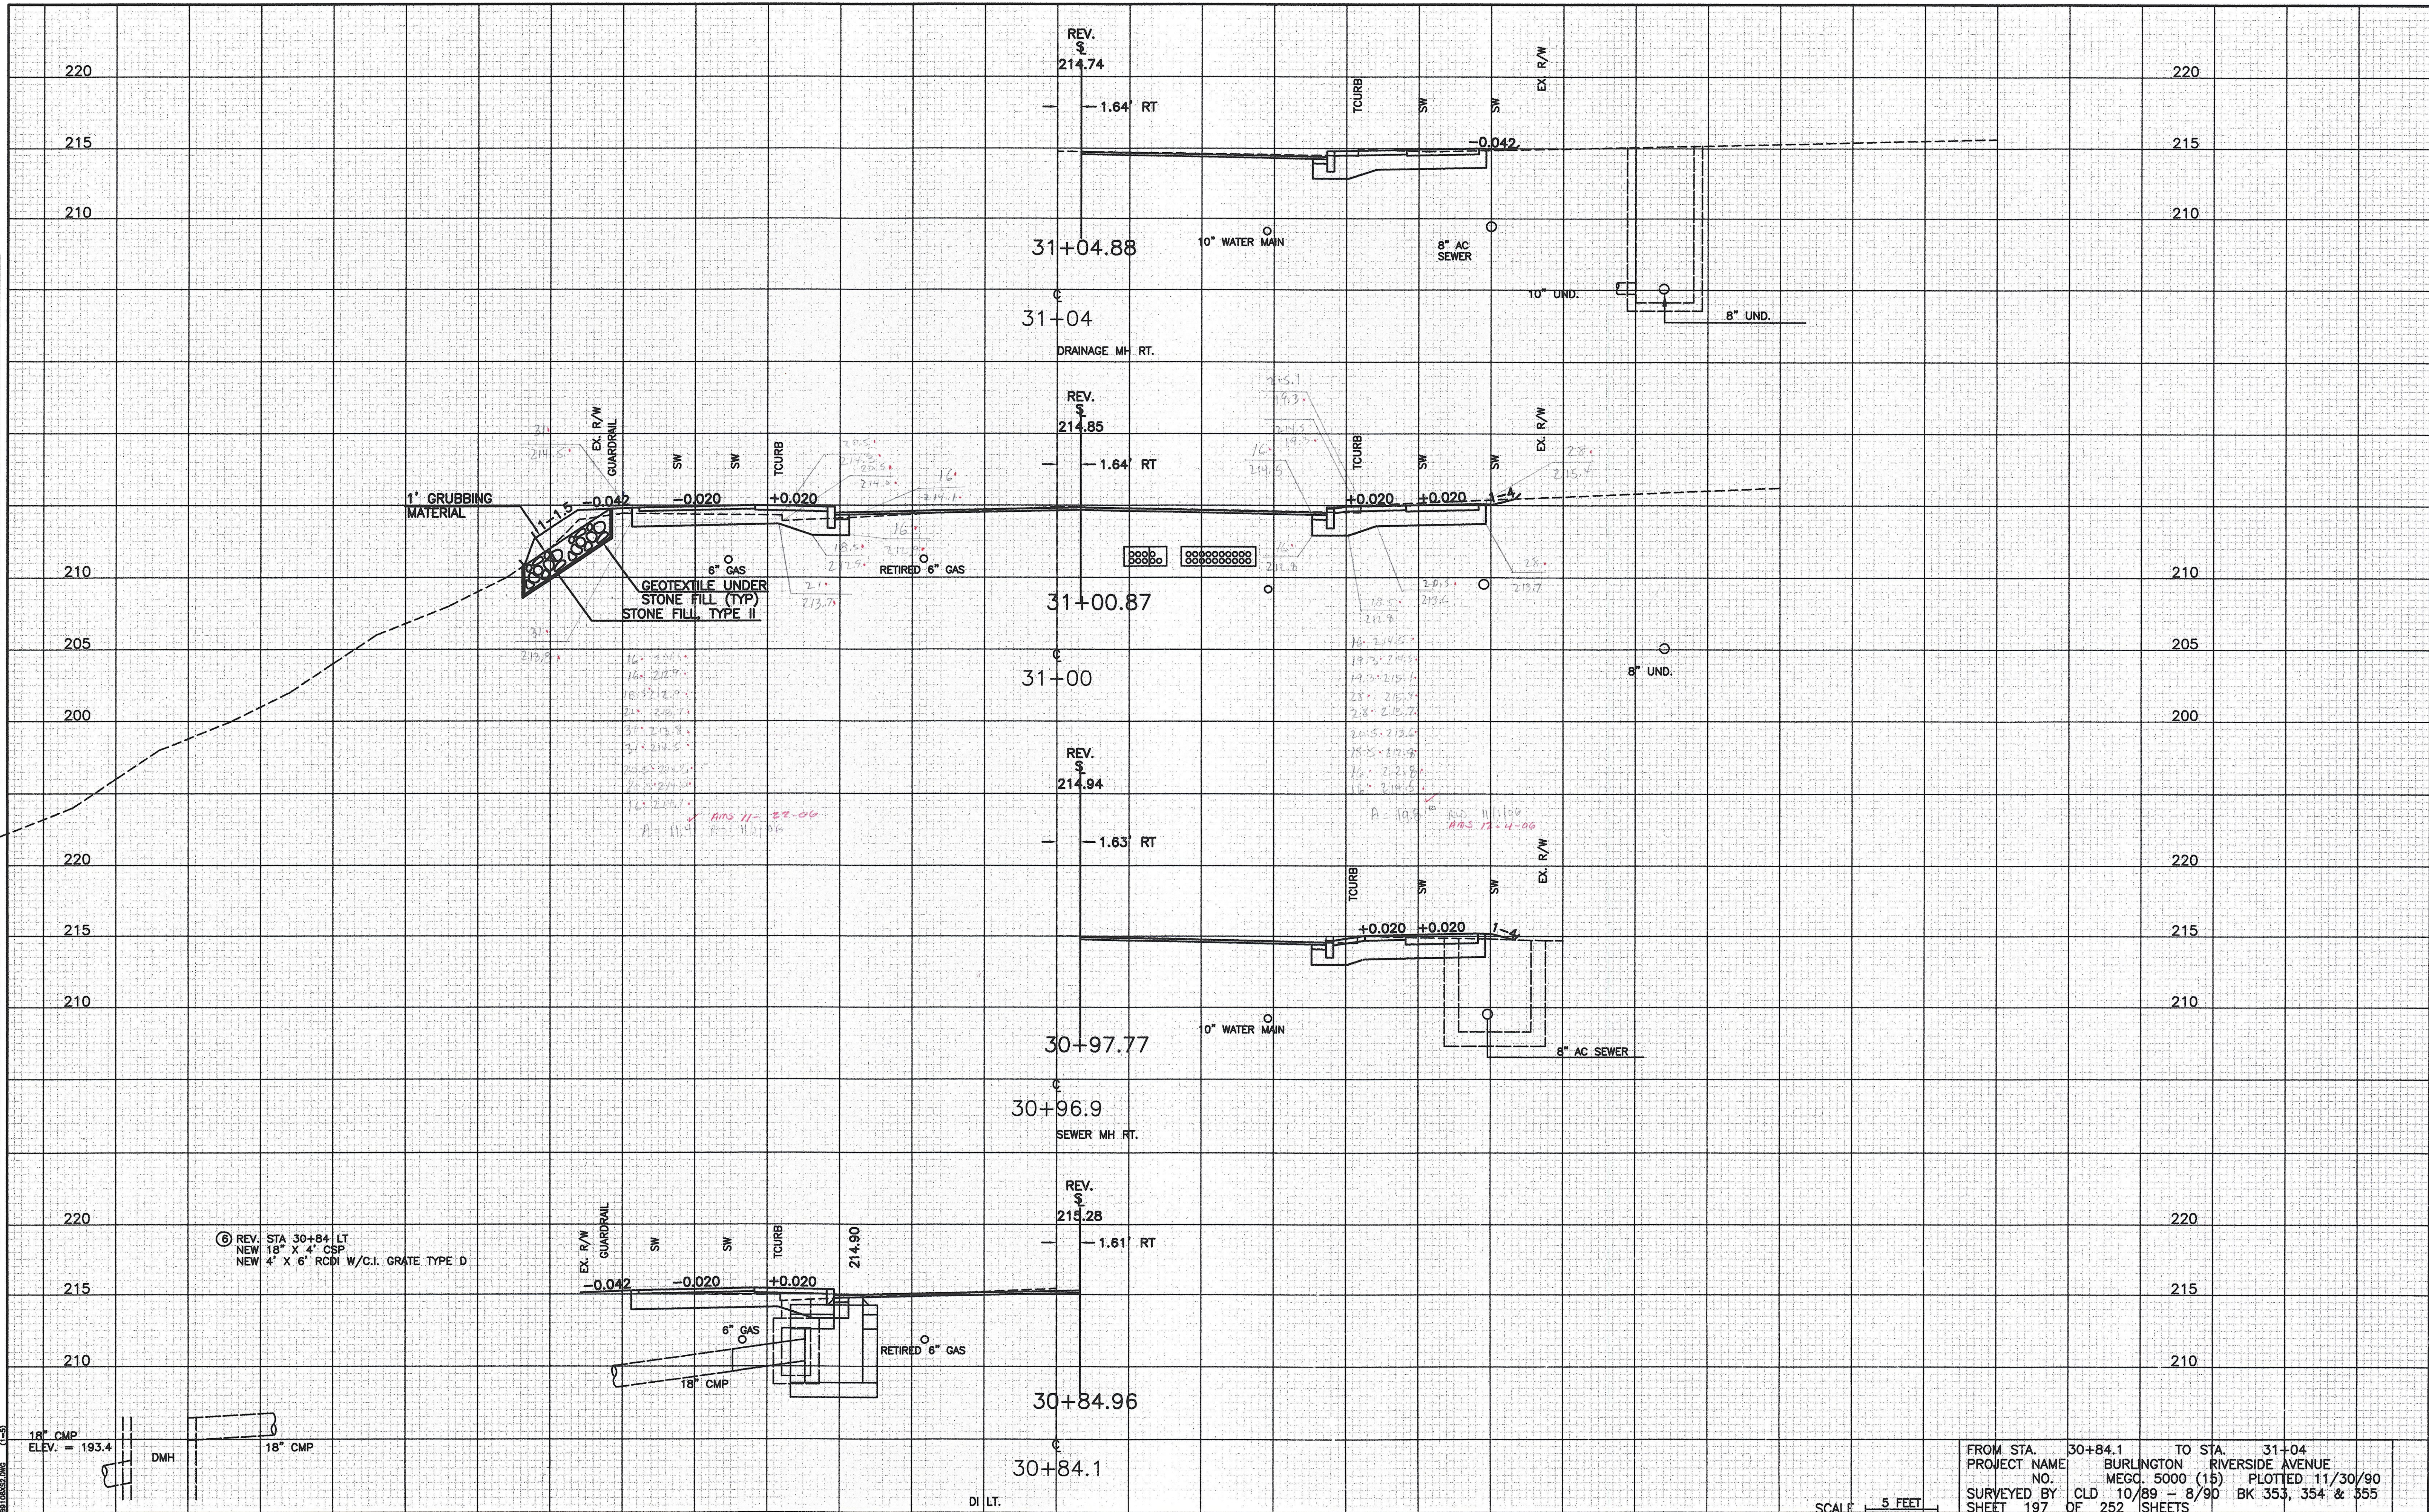

⑤ REV. STA 30+84 LT  
 NEW 18" X 4" CSP  
 NEW 4" X 6" RCDI W/C.I. GRATE TYPE D

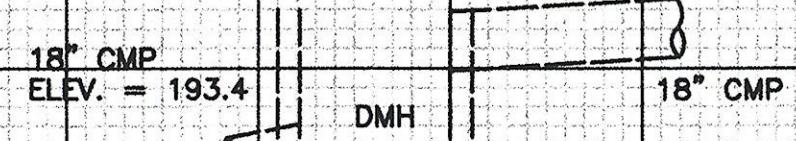

FROM STA. 30+84.1 TO STA. 31+04  
 PROJECT NAME BURLINGTON RIVERSIDE AVENUE  
 NO. MEGC. 5000 (15) PLOTTED 11/30/90  
 SURVEYED BY CLD 10/89 - 8/90 BK 353, 354 & 355  
 SHEET 197 OF 252 SHEETS

SCALE 5 FEET

DI LT.