


DATE	
BY	
ORIGINAL SURVEY	
NOTED	
TEMPLATE	
AREAS	
CHECKED	
NO.	

DATE	
BY	
ORIGINAL SURVEY	
NOTED	
TEMPLATE	
AREAS	
CHECKED	
NO.	

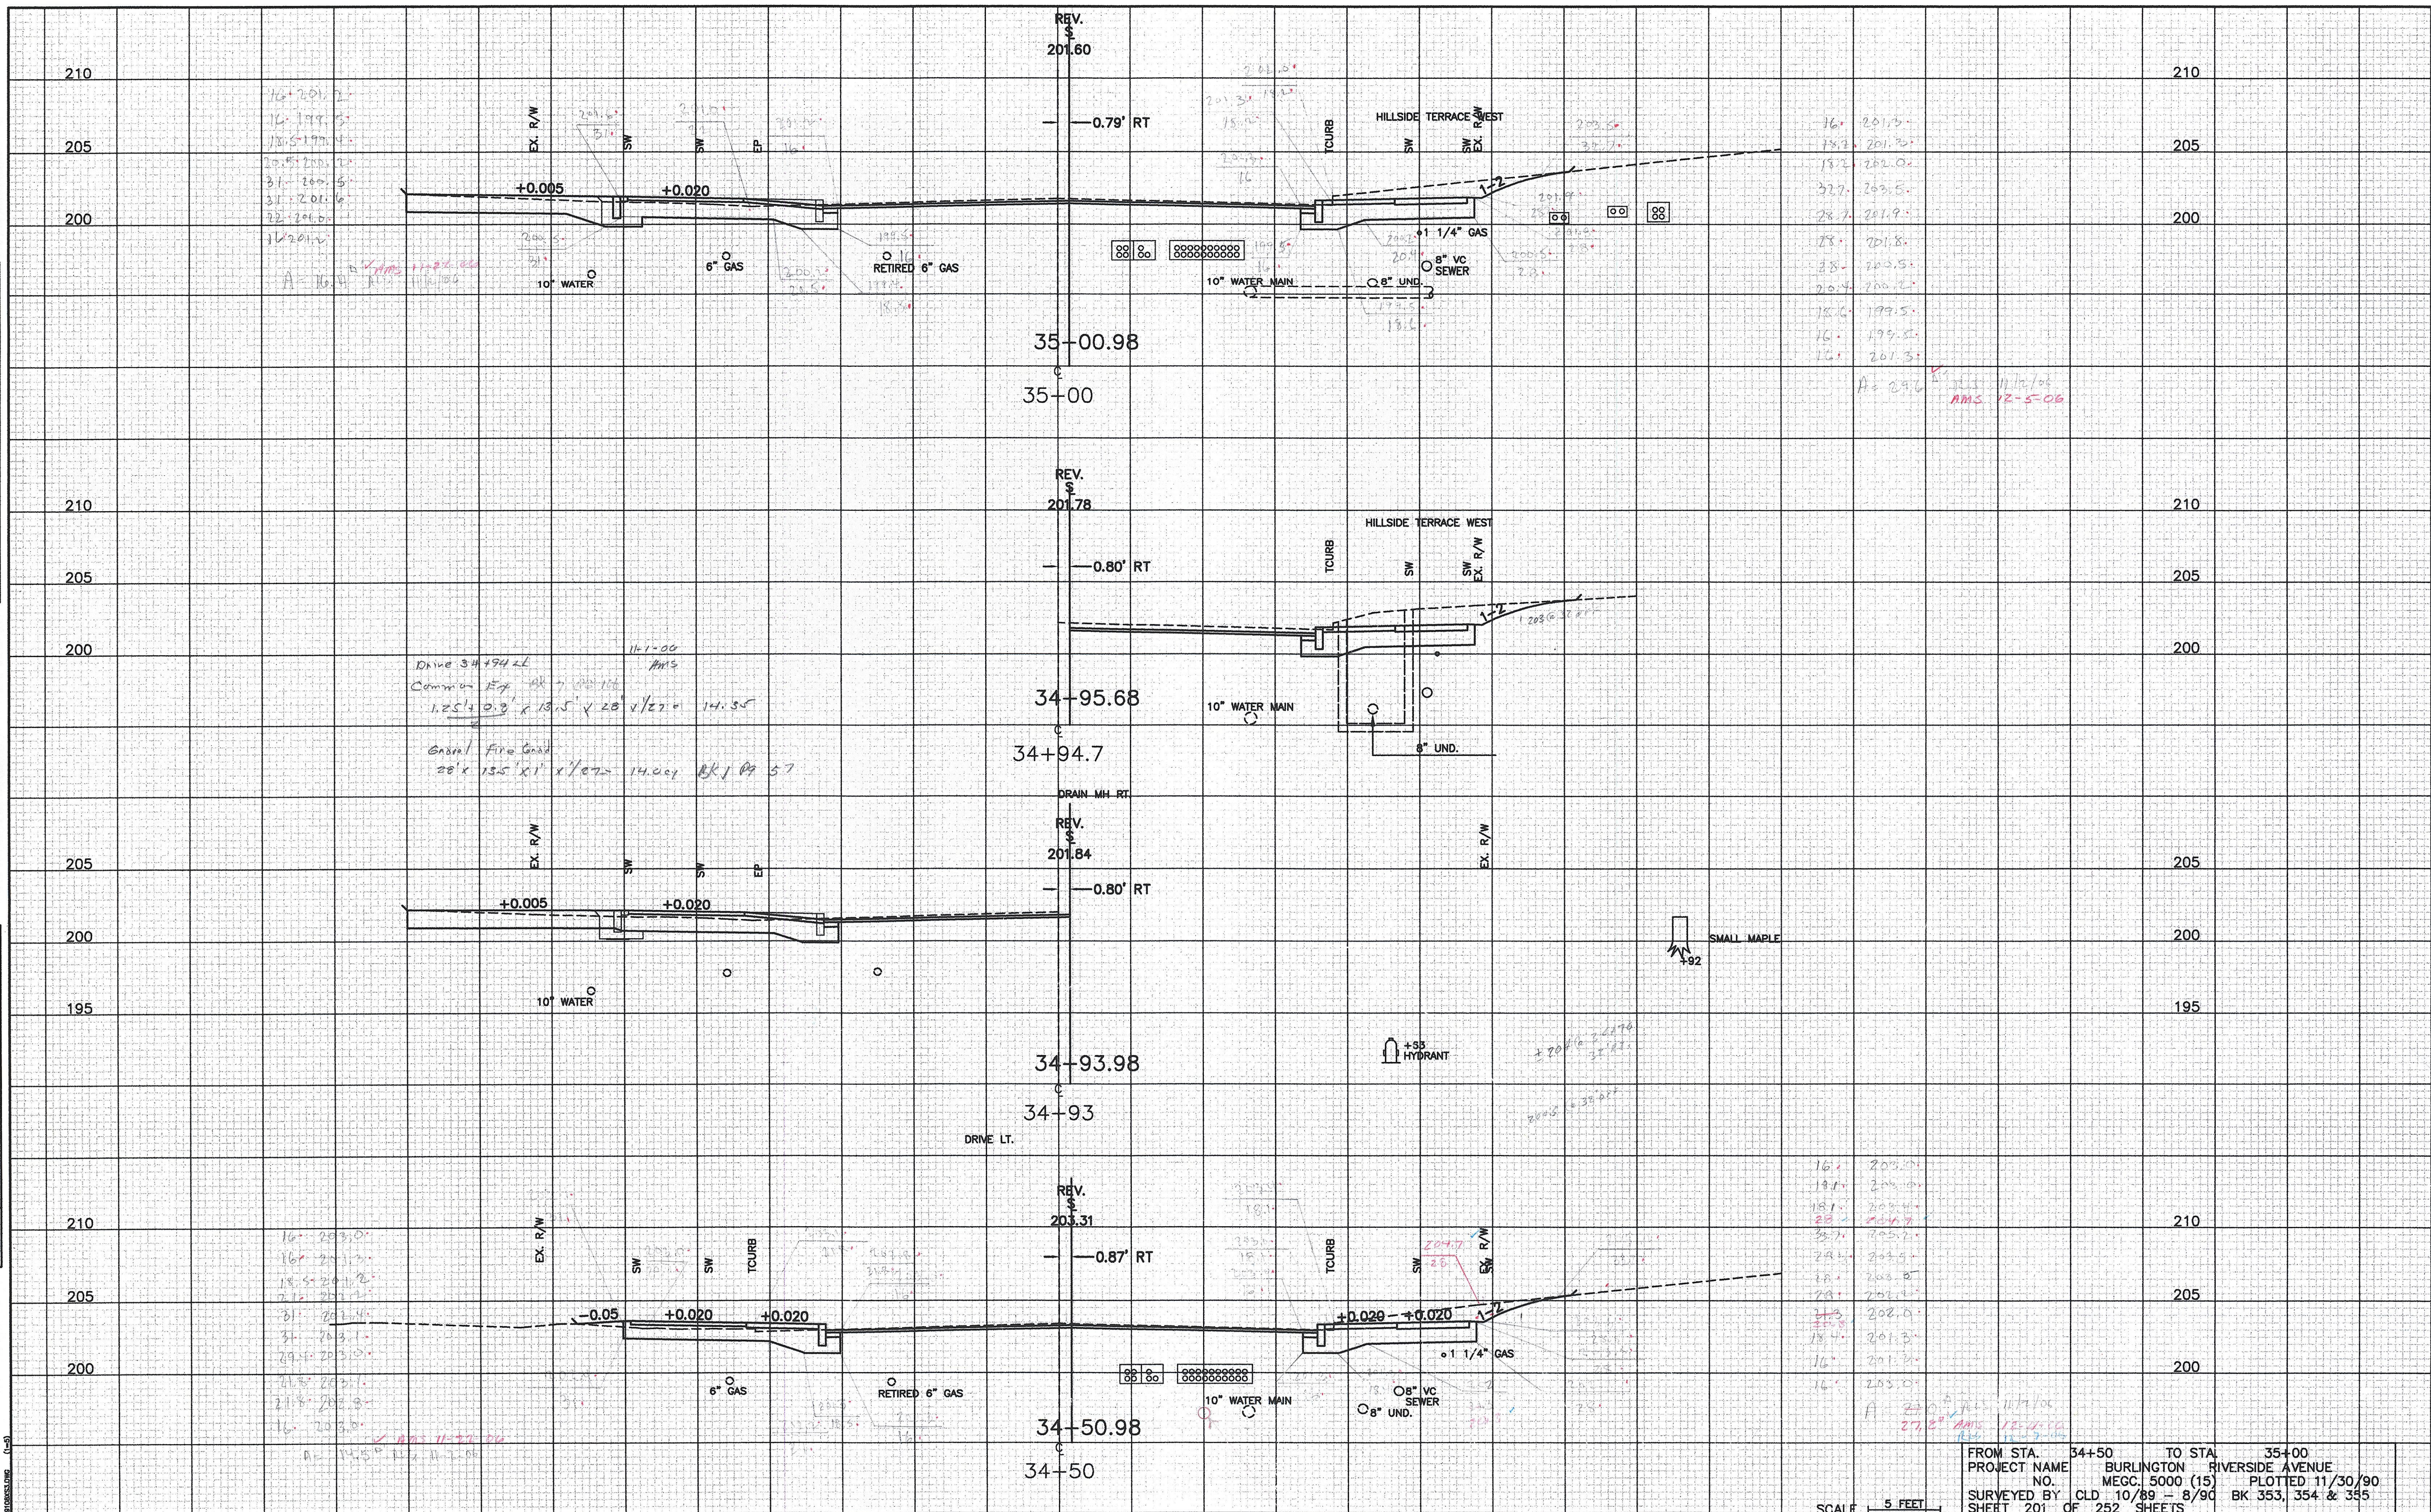

16+20.0
16+19.5
17+5+19.5
18+5+20.5
19+20.1
20+20.0
21+20.0
22+20.0

EX. R/W
SW
SW
EP
10" WATER
6" GAS
RETIRED 6" GAS

REV. \$ 201.60
-0.79' RT

35+00.98
35+00

16+ 201.3
18+ 201.2
19+ 202.0
20+ 202.5
21+ 201.9
22+ 201.8
23+ 200.5
24+ 200.2
25+ 199.5
26+ 201.3

Drive 34+94.2L
Common Eq. 11-1-00
1.25' x 0.9' x 19.5' x 28' x 14.35' AM'S
General Fire Good
28' x 13.5' x 1' x 14.02' BK 1 Pg 57

EX. R/W
SW
SW
EP
10" WATER

REV. \$ 201.78
-0.80' RT

34+95.68
34+94.7

REV. \$ 201.84
-0.80' RT

34+93.98
34+93
DRIVE LT.

+53 HYDRANT

SMALL MAPLE
4.92

16+ 203.0
16+ 201.2
18+ 201.2
19+ 201.2
20+ 201.4
21+ 203.1
22+ 203.0
23+ 203.0
24+ 203.0
25+ 203.0
26+ 203.0

EX. R/W
SW
SW
TCURB
6" GAS
RETIRED 6" GAS

REV. \$ 203.31
-0.87' RT

34+50.98
34+50

16+ 203.0
18+ 203.0
19+ 203.4
20+ 203.7
21+ 203.2
22+ 203.2
23+ 203.2
24+ 203.2
25+ 203.2
26+ 203.2
27+ 203.2

FROM STA. 34+50 TO STA. 35+00
PROJECT NAME BURLINGTON RIVERSIDE AVENUE
NO. MEGC. 5000 (15) PLOTTED 11/30/90
SURVEYED BY CLD 10/89 - 8/90 BK 353, 354 & 355
SHEET 201 OF 252 SHEETS

SCALE 5 FEET

WARNING: AS LOCATED BY THIS PLAN
NO EXISTING UTILITIES SHOWN
BEFORE CONSTRUCTION BEGINS