


DATE	
BY	
SURVEYED	
PLOTTED	
TEMPLATE	
AREAS	
CHECKED	
NO.	

DATE	
BY	
ORIGINAL	
SURVEY	
PLOTTED	
TEMPLATE	
AREAS	
CHECKED	
NO.	

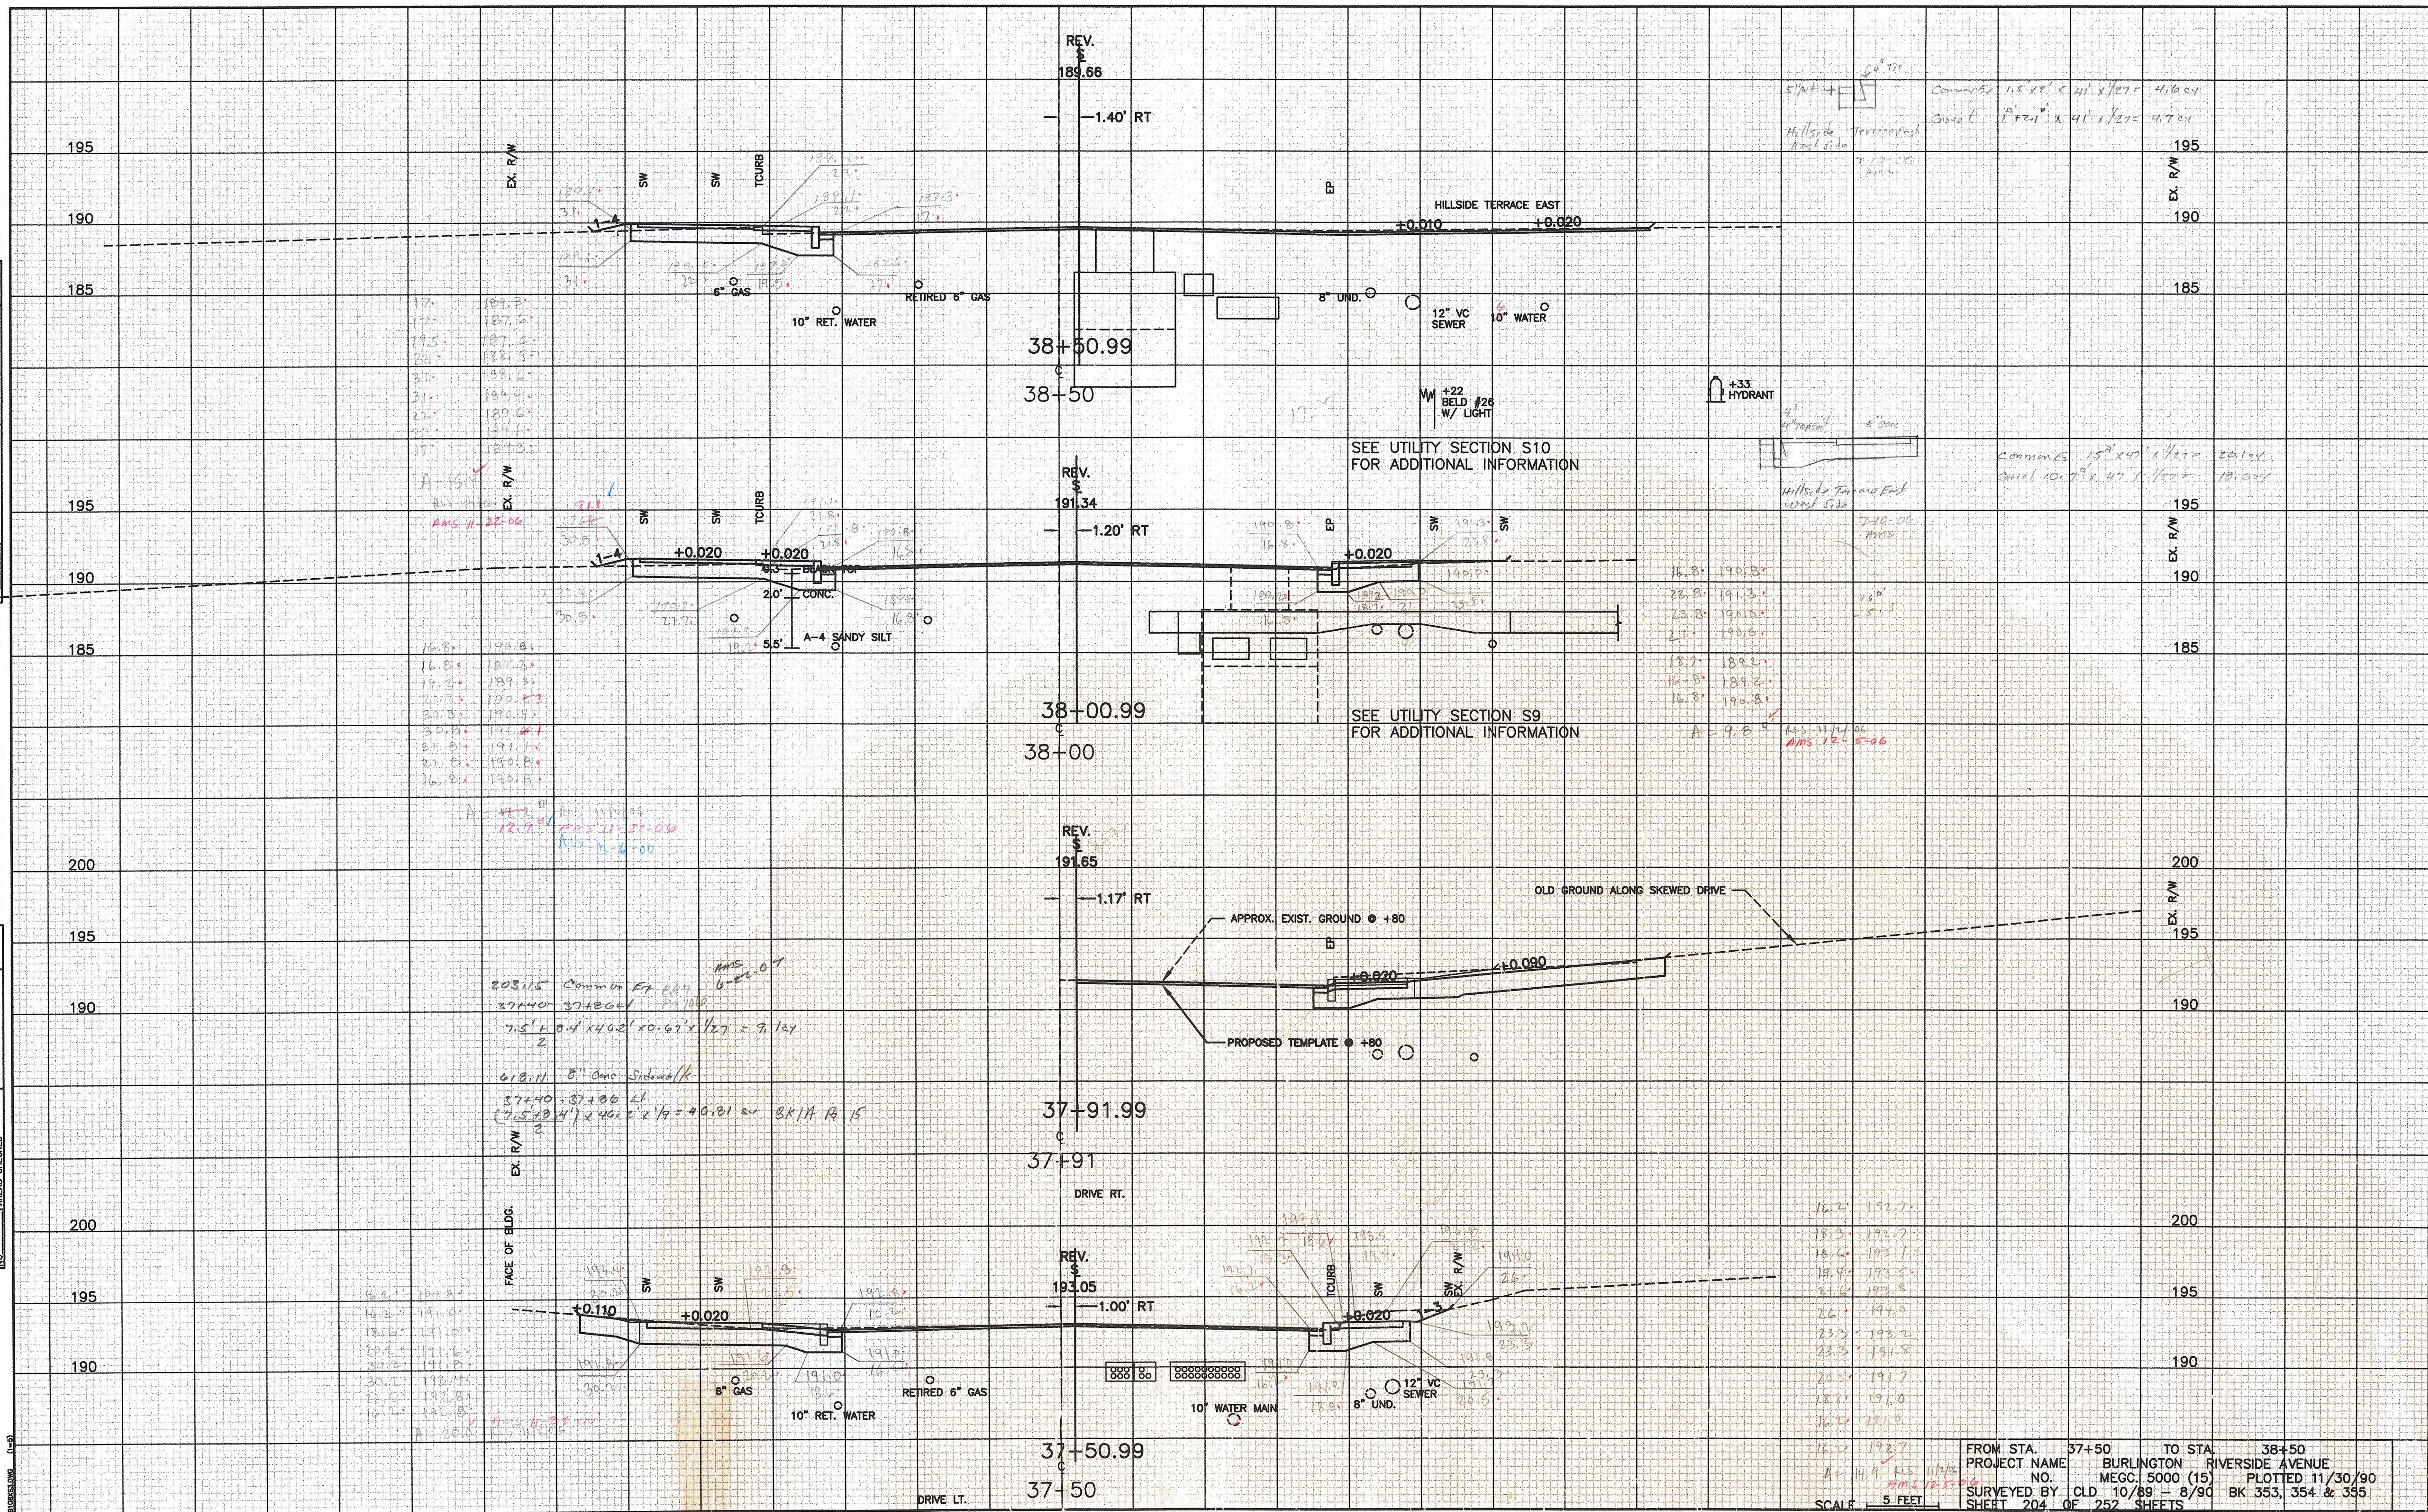

FROM STA. 37+50 TO STA. 38+50
 PROJECT NAME BURLINGTON RIVERSIDE AVENUE
 NO. MECC 5000 (15) PLOTTED 11/30/90
 SURVEYED BY CLD 10/89 - 8/90 BK 353, 354 & 355
 SHEET 204 OF 252 SHEETS

SCALE 5 FEET