


DATE	
BY	
FINAL SURVEY	SURVEYED
NOTED	PLOTTED
NO.	DATE
	AREAS CHECKED

DATE	
BY	
ORIGINAL SURVEY	SURVEYED
NOTED	PLOTTED
NO.	DATE
	AREAS CHECKED

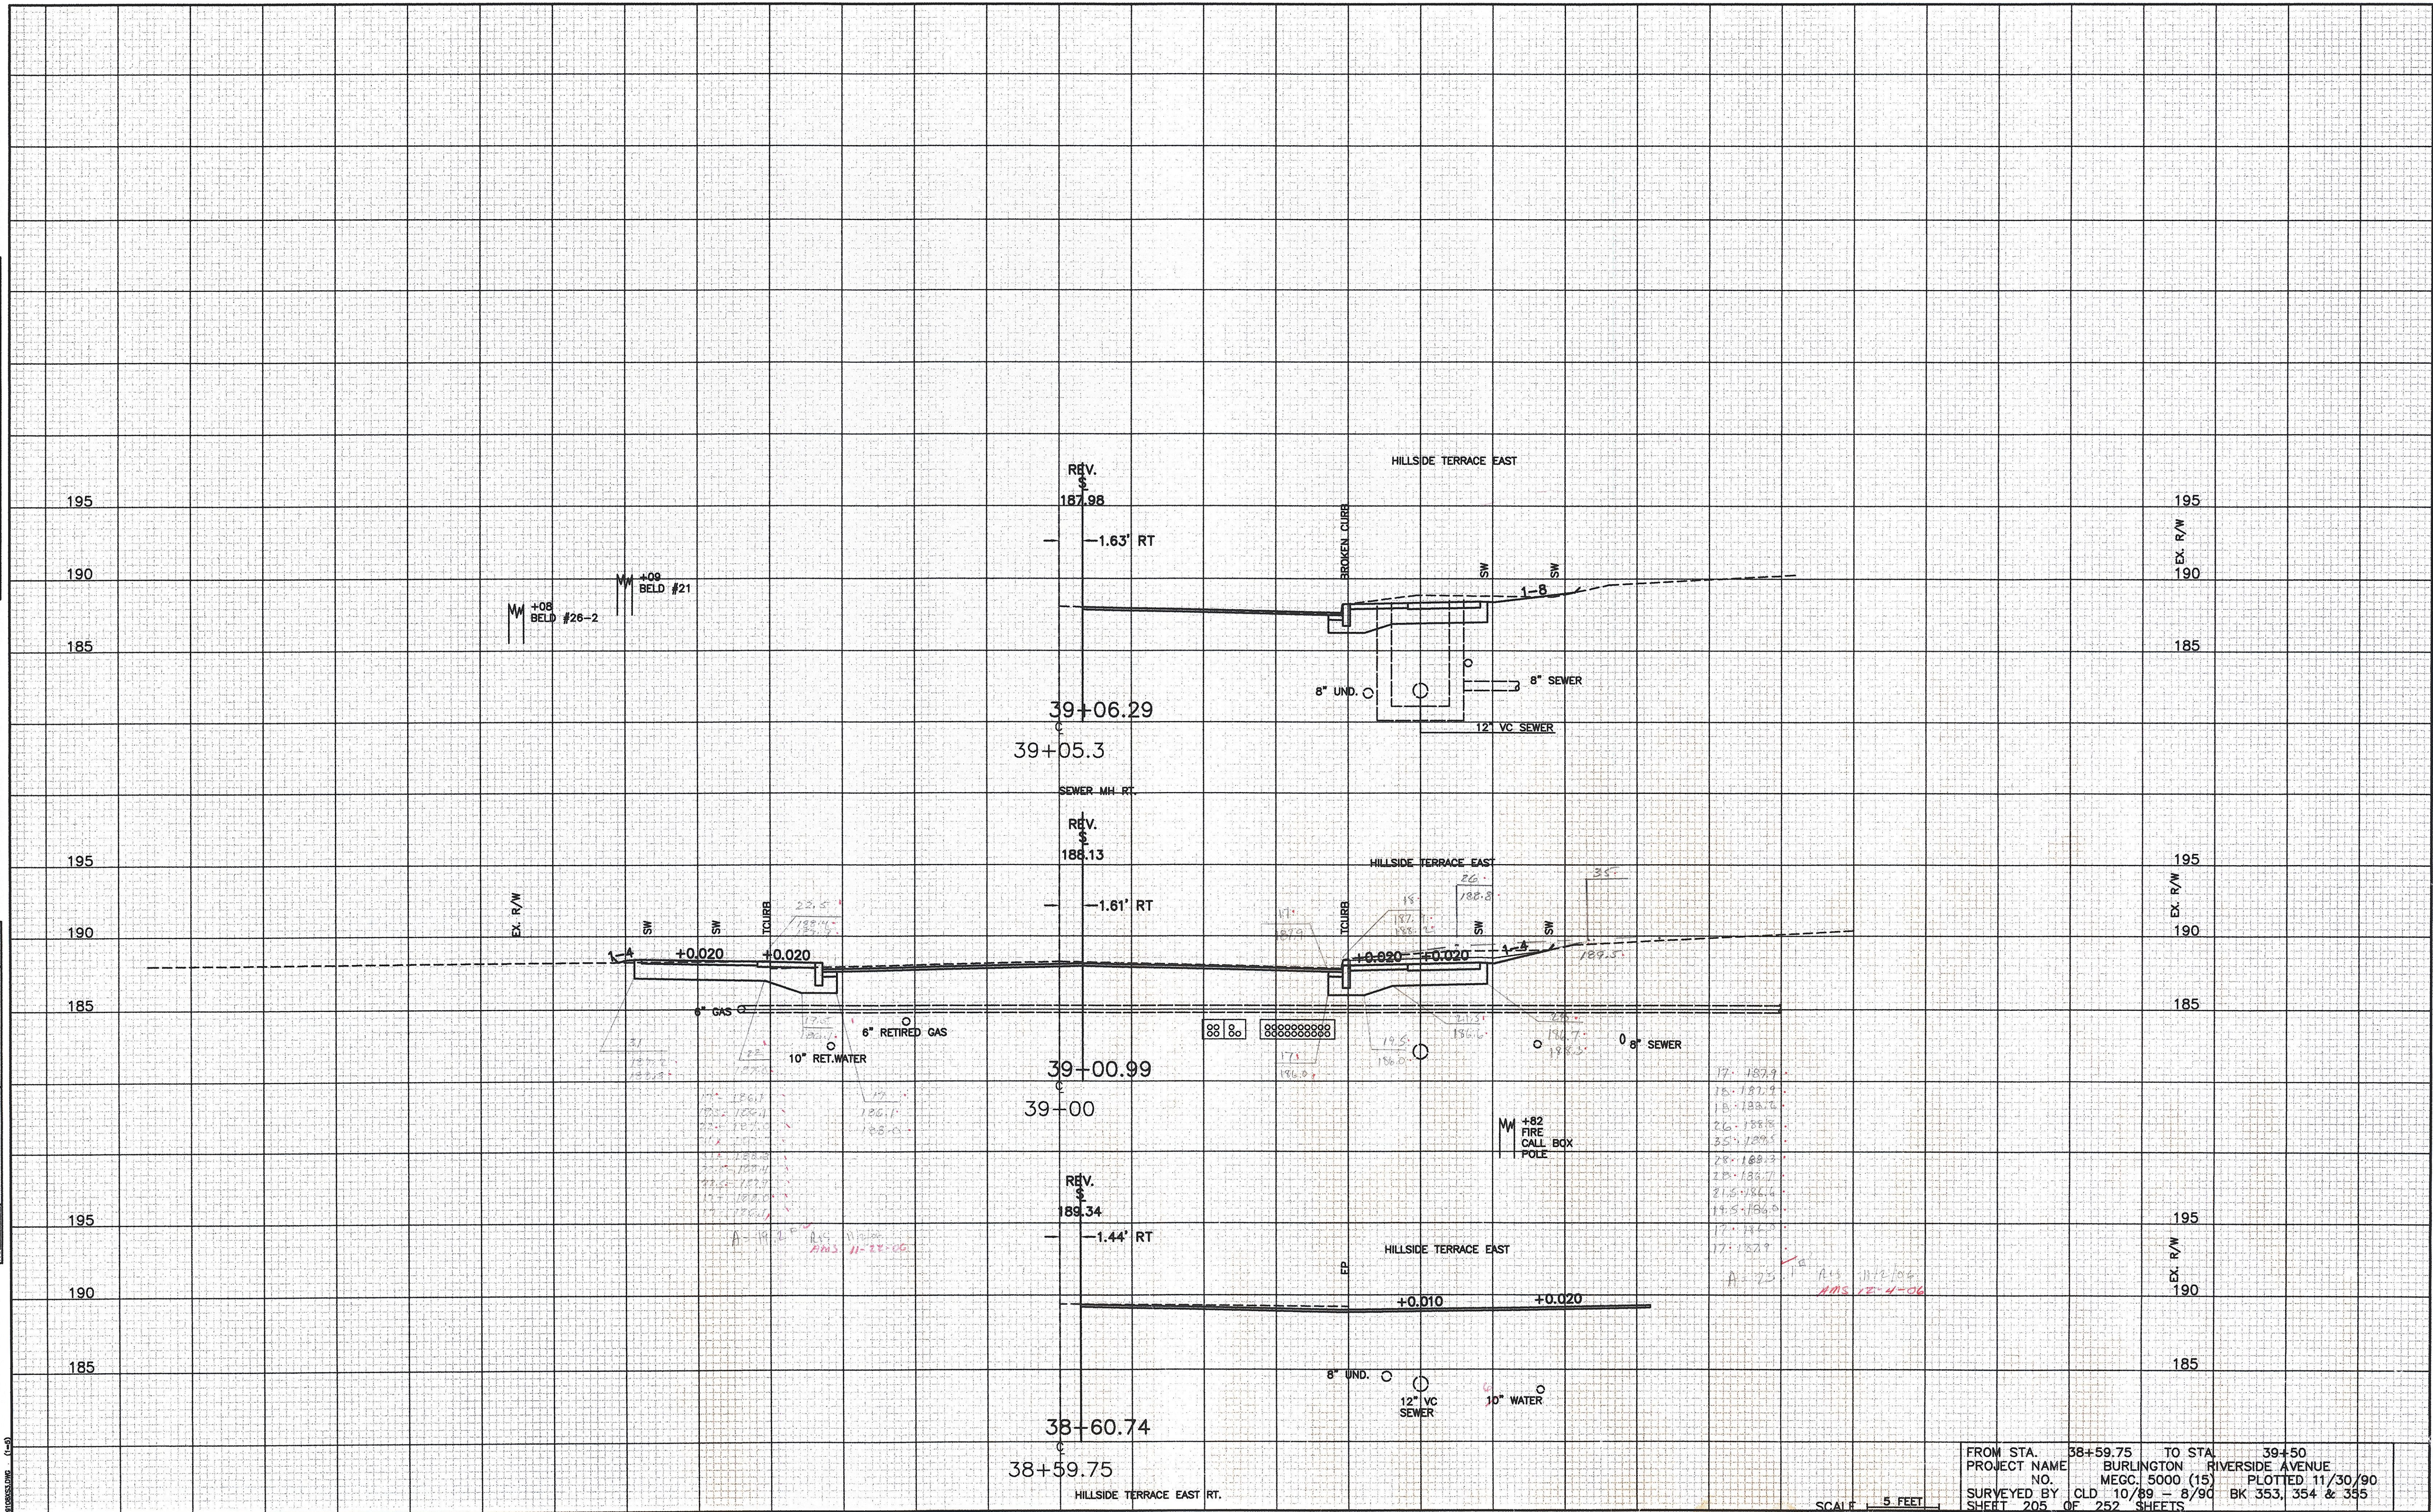

FROM STA. 38+59.75 TO STA. 39+50  
 PROJECT NAME BURLINGTON RIVERSIDE AVENUE  
 NO. MECC. 5000 (15) PLOTTED 11/30/90  
 SURVEYED BY CLD 10/89 - 8/90 BK 353, 354 & 355  
 SHEET 205 OF 252 SHEETS

SCALE 1" = 5 FEET

DRAWING (1-9)