


DATE	
BY	
FINAL SURVEY PLOTTED	
TEMPLATE	
NO. OF SHEETS	
NO. OF SHEETS CHECKED	

DATE	
BY	
ORIGINAL SURVEY PLOTTED	
TEMPLATE	
NO. OF SHEETS	
NO. OF SHEETS CHECKED	

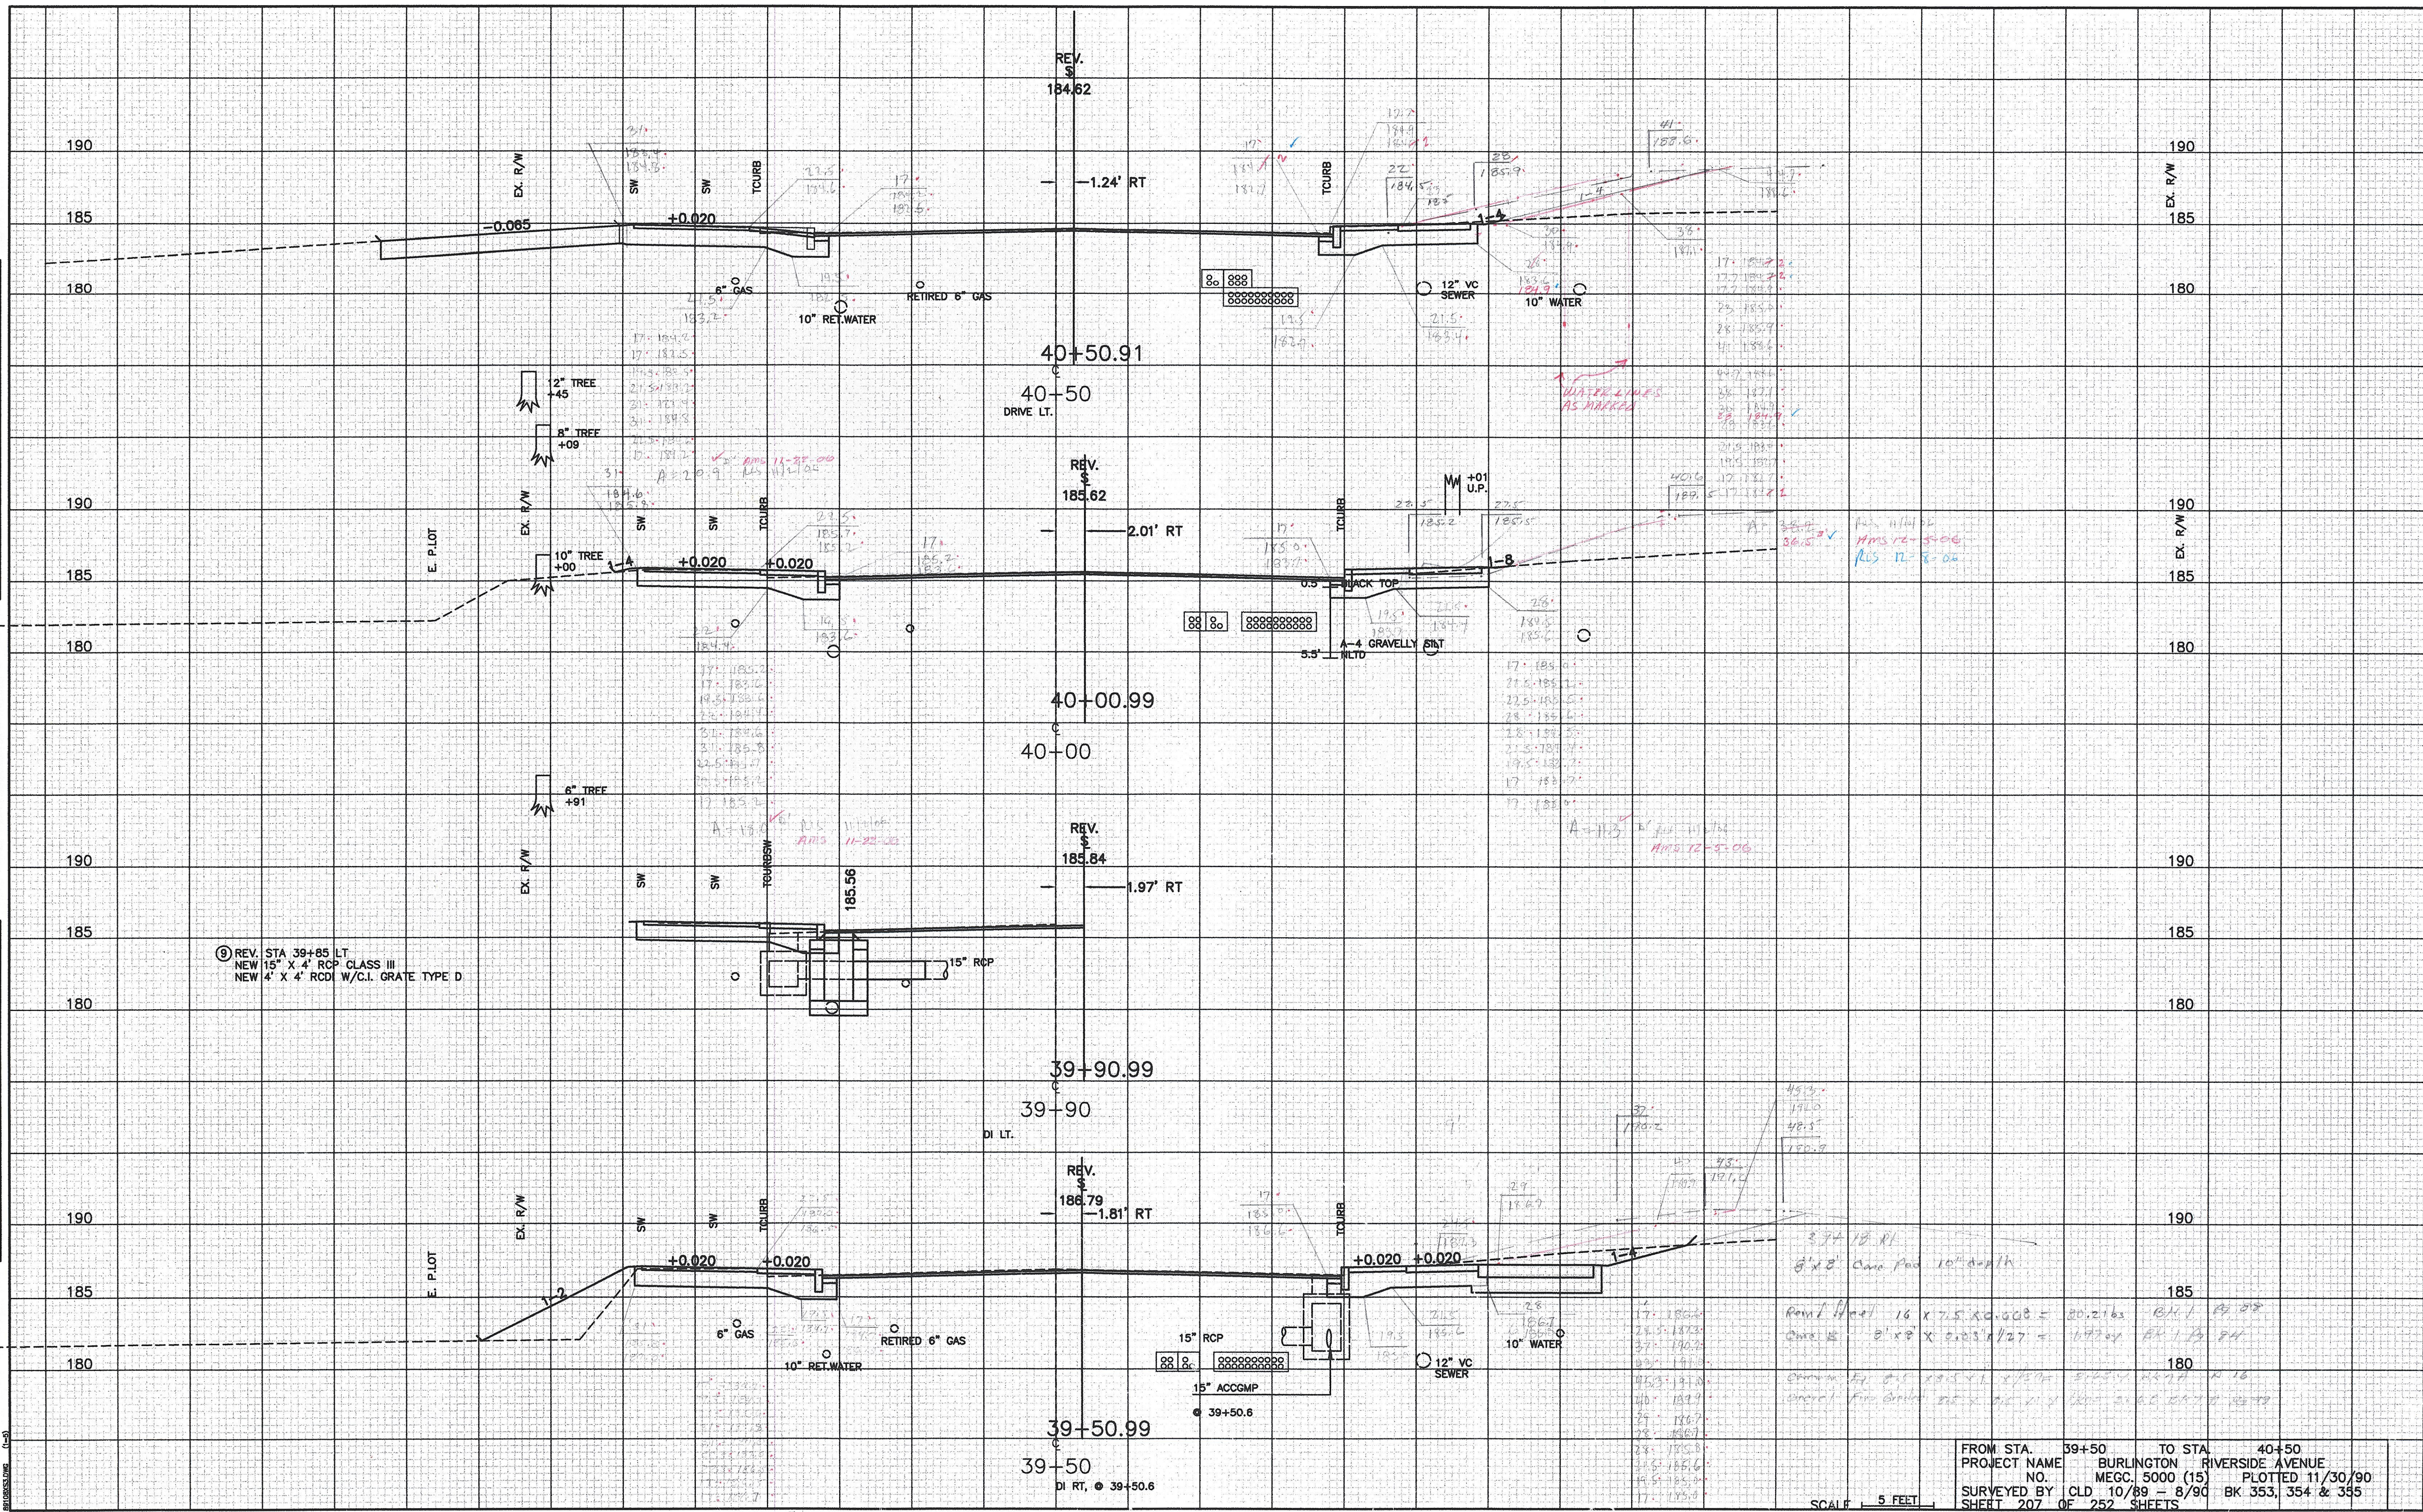

FROM STA. 39+50 TO STA. 40+50  
 PROJECT NAME BURLINGTON RIVERSIDE AVENUE  
 NO. MEGC. 5000 (15) PLOTTED 11/30/90  
 SURVEYED BY CLD 10/89 - 8/90 BK 353, 354 & 355  
 SHEET 207 OF 252 SHEETS

SCALE 5 FEET

A-178.5' MMS 11-22-00  
 17.3' MMS 11-22-00

A-36.9' MMS 11/11/00  
 MMS 12-5-00