


DATE	
BY	
NO.	
FINAL SURVEY	STRIPPED
NOTEBOOK	PLOTTED
	TEMPLATE
	AREAS CHECKED

DATE	
BY	
NO.	
ORIGINAL SURVEY	STRIPPED
NOTEBOOK	PLOTTED
	TEMPLATE
	AREAS CHECKED

DATE	
BY	
NO.	
ORIGINAL SURVEY	STRIPPED
NOTEBOOK	PLOTTED
	TEMPLATE
	AREAS CHECKED

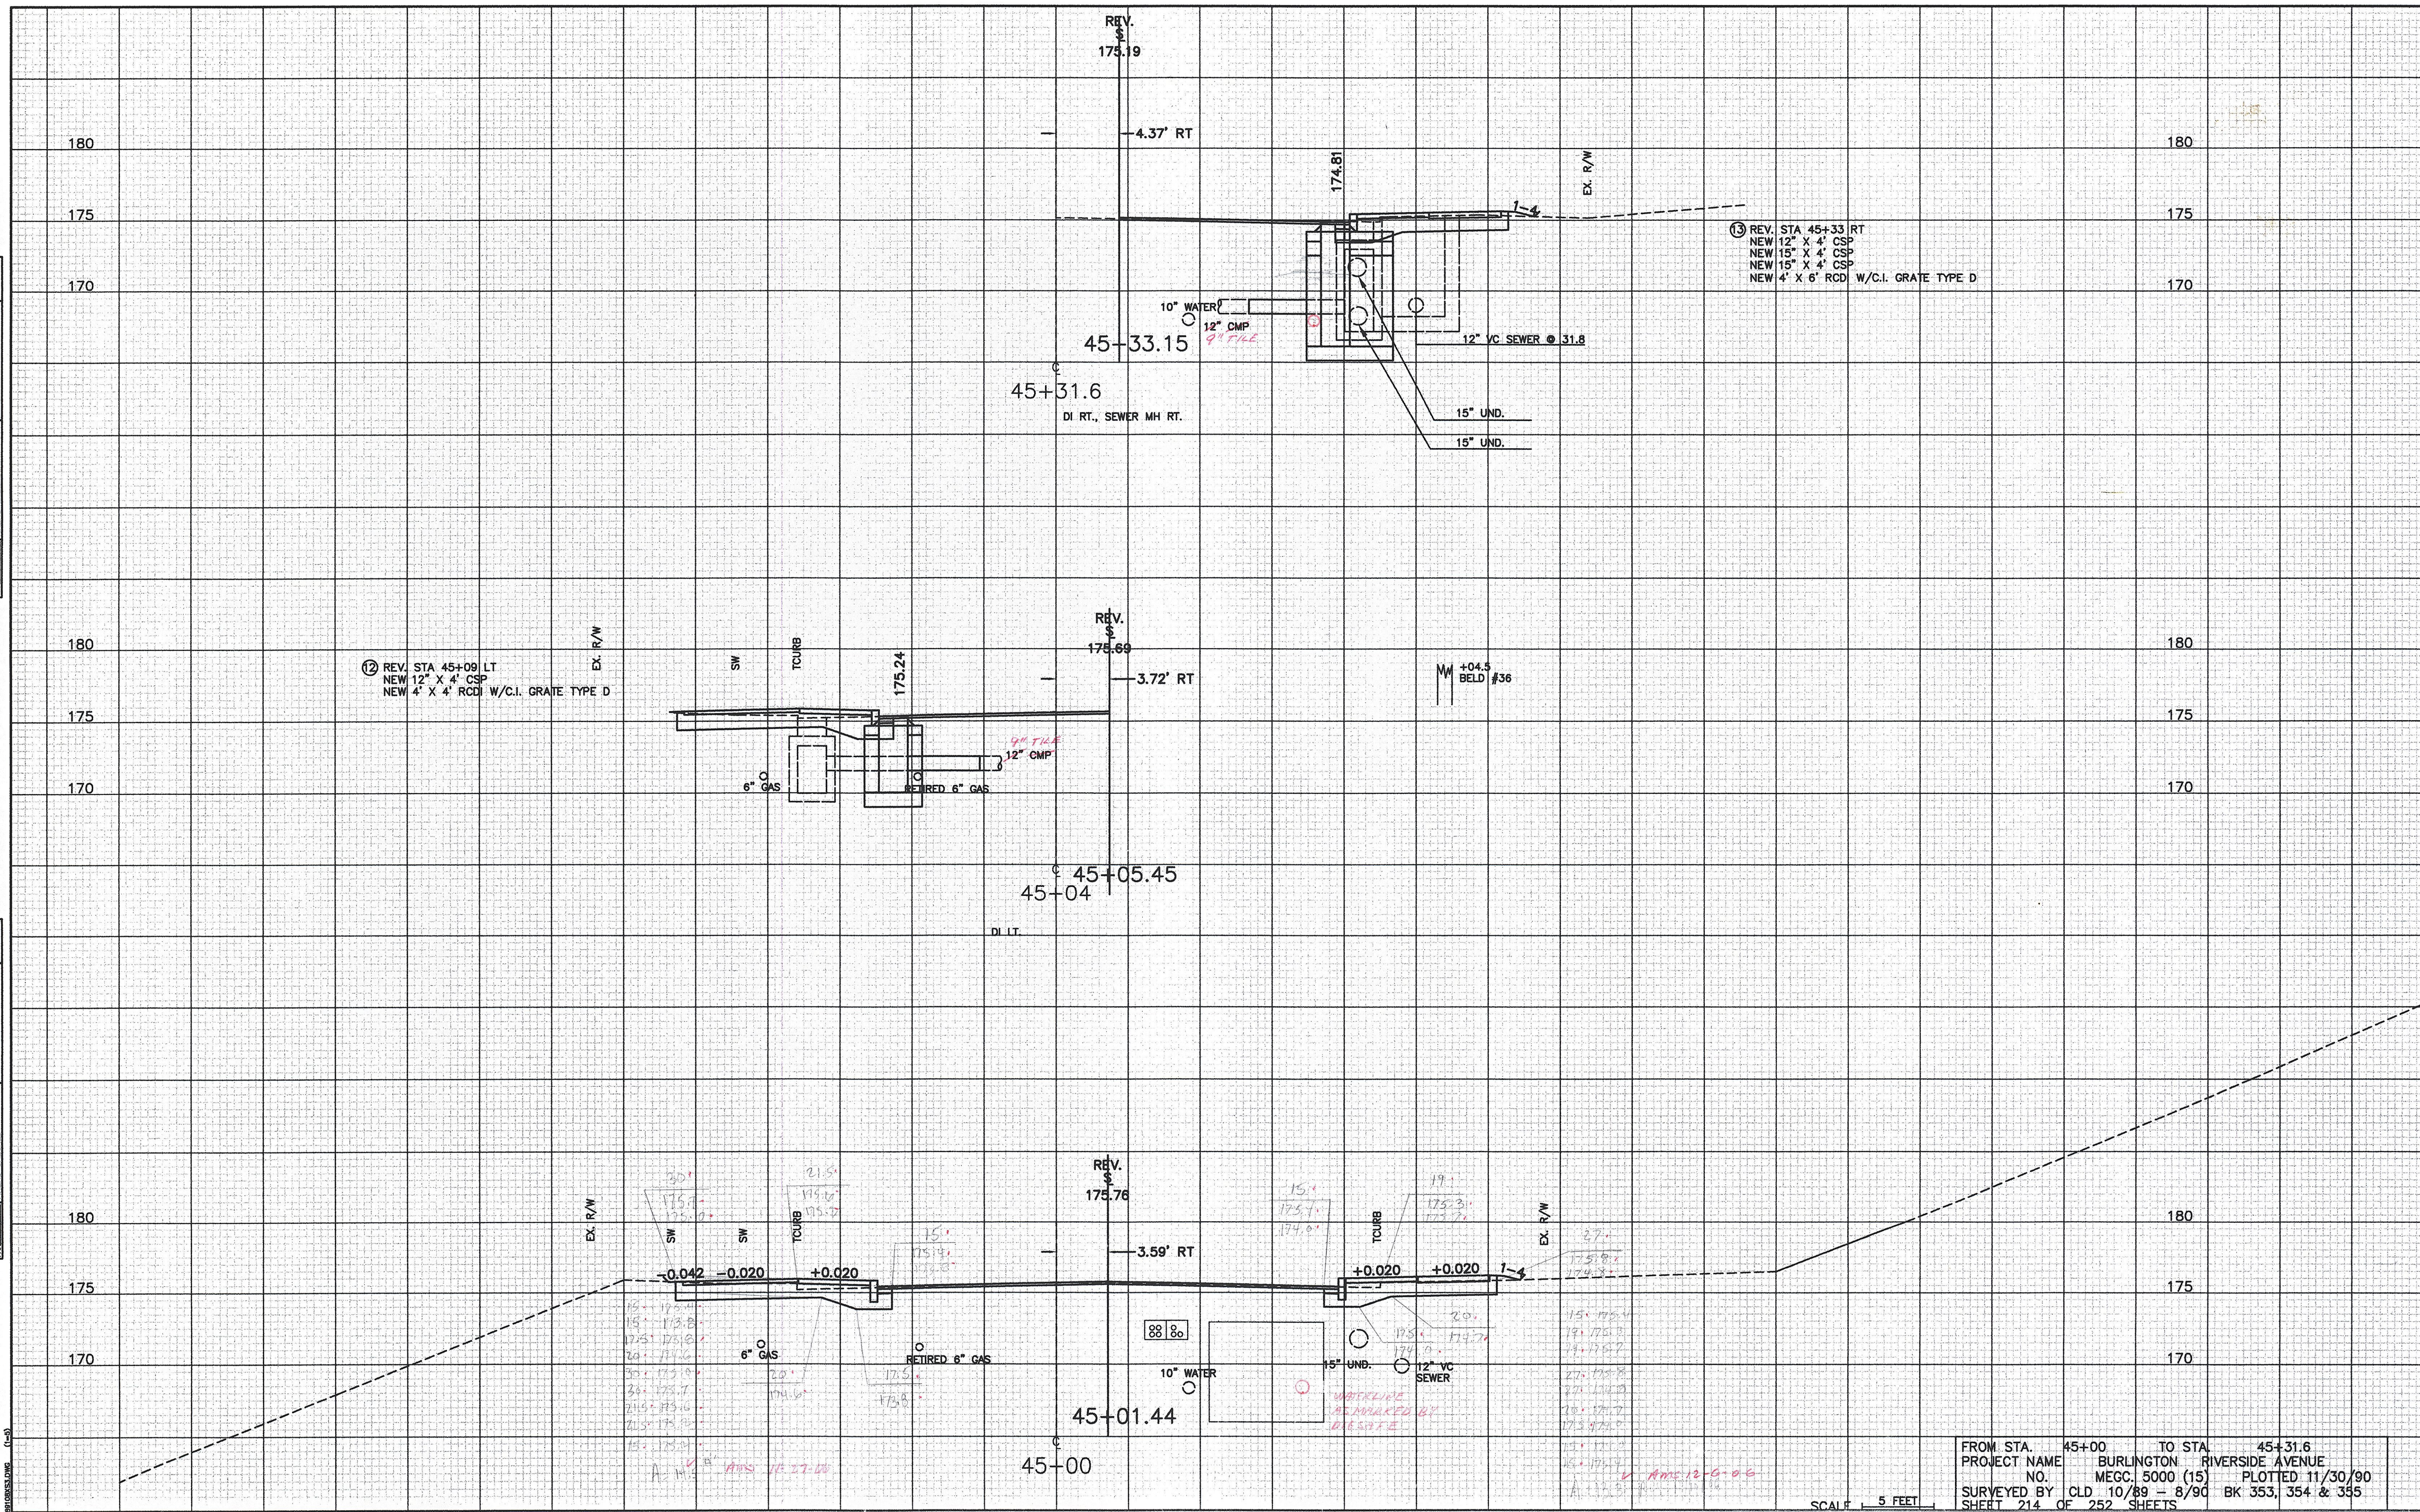

FROM STA. 45+00 TO STA. 45+31.6
 PROJECT NAME BURLINGTON RIVERSIDE AVENUE
 NO. MEGC. 5000 (15) PLOTTED 11/30/90
 SURVEYED BY CLD 10/89 - 8/90 BK 353, 354 & 355
 SHEET 214 OF 252 SHEETS

SCALE 5 FEET

AMS 12-6-06

WORKLINE RE-MARKED BY BRESNIZE

AMS 11-27-05