


DATE	
BY	
FINAL SURVEY	
PLOTTED	
NO. DATE	
NO. DATE	
AREAS CHECKED	

DATE	
BY	
ORIGINAL SURVEY	
PLOTTED	
NO. DATE	
NO. DATE	
AREAS CHECKED	

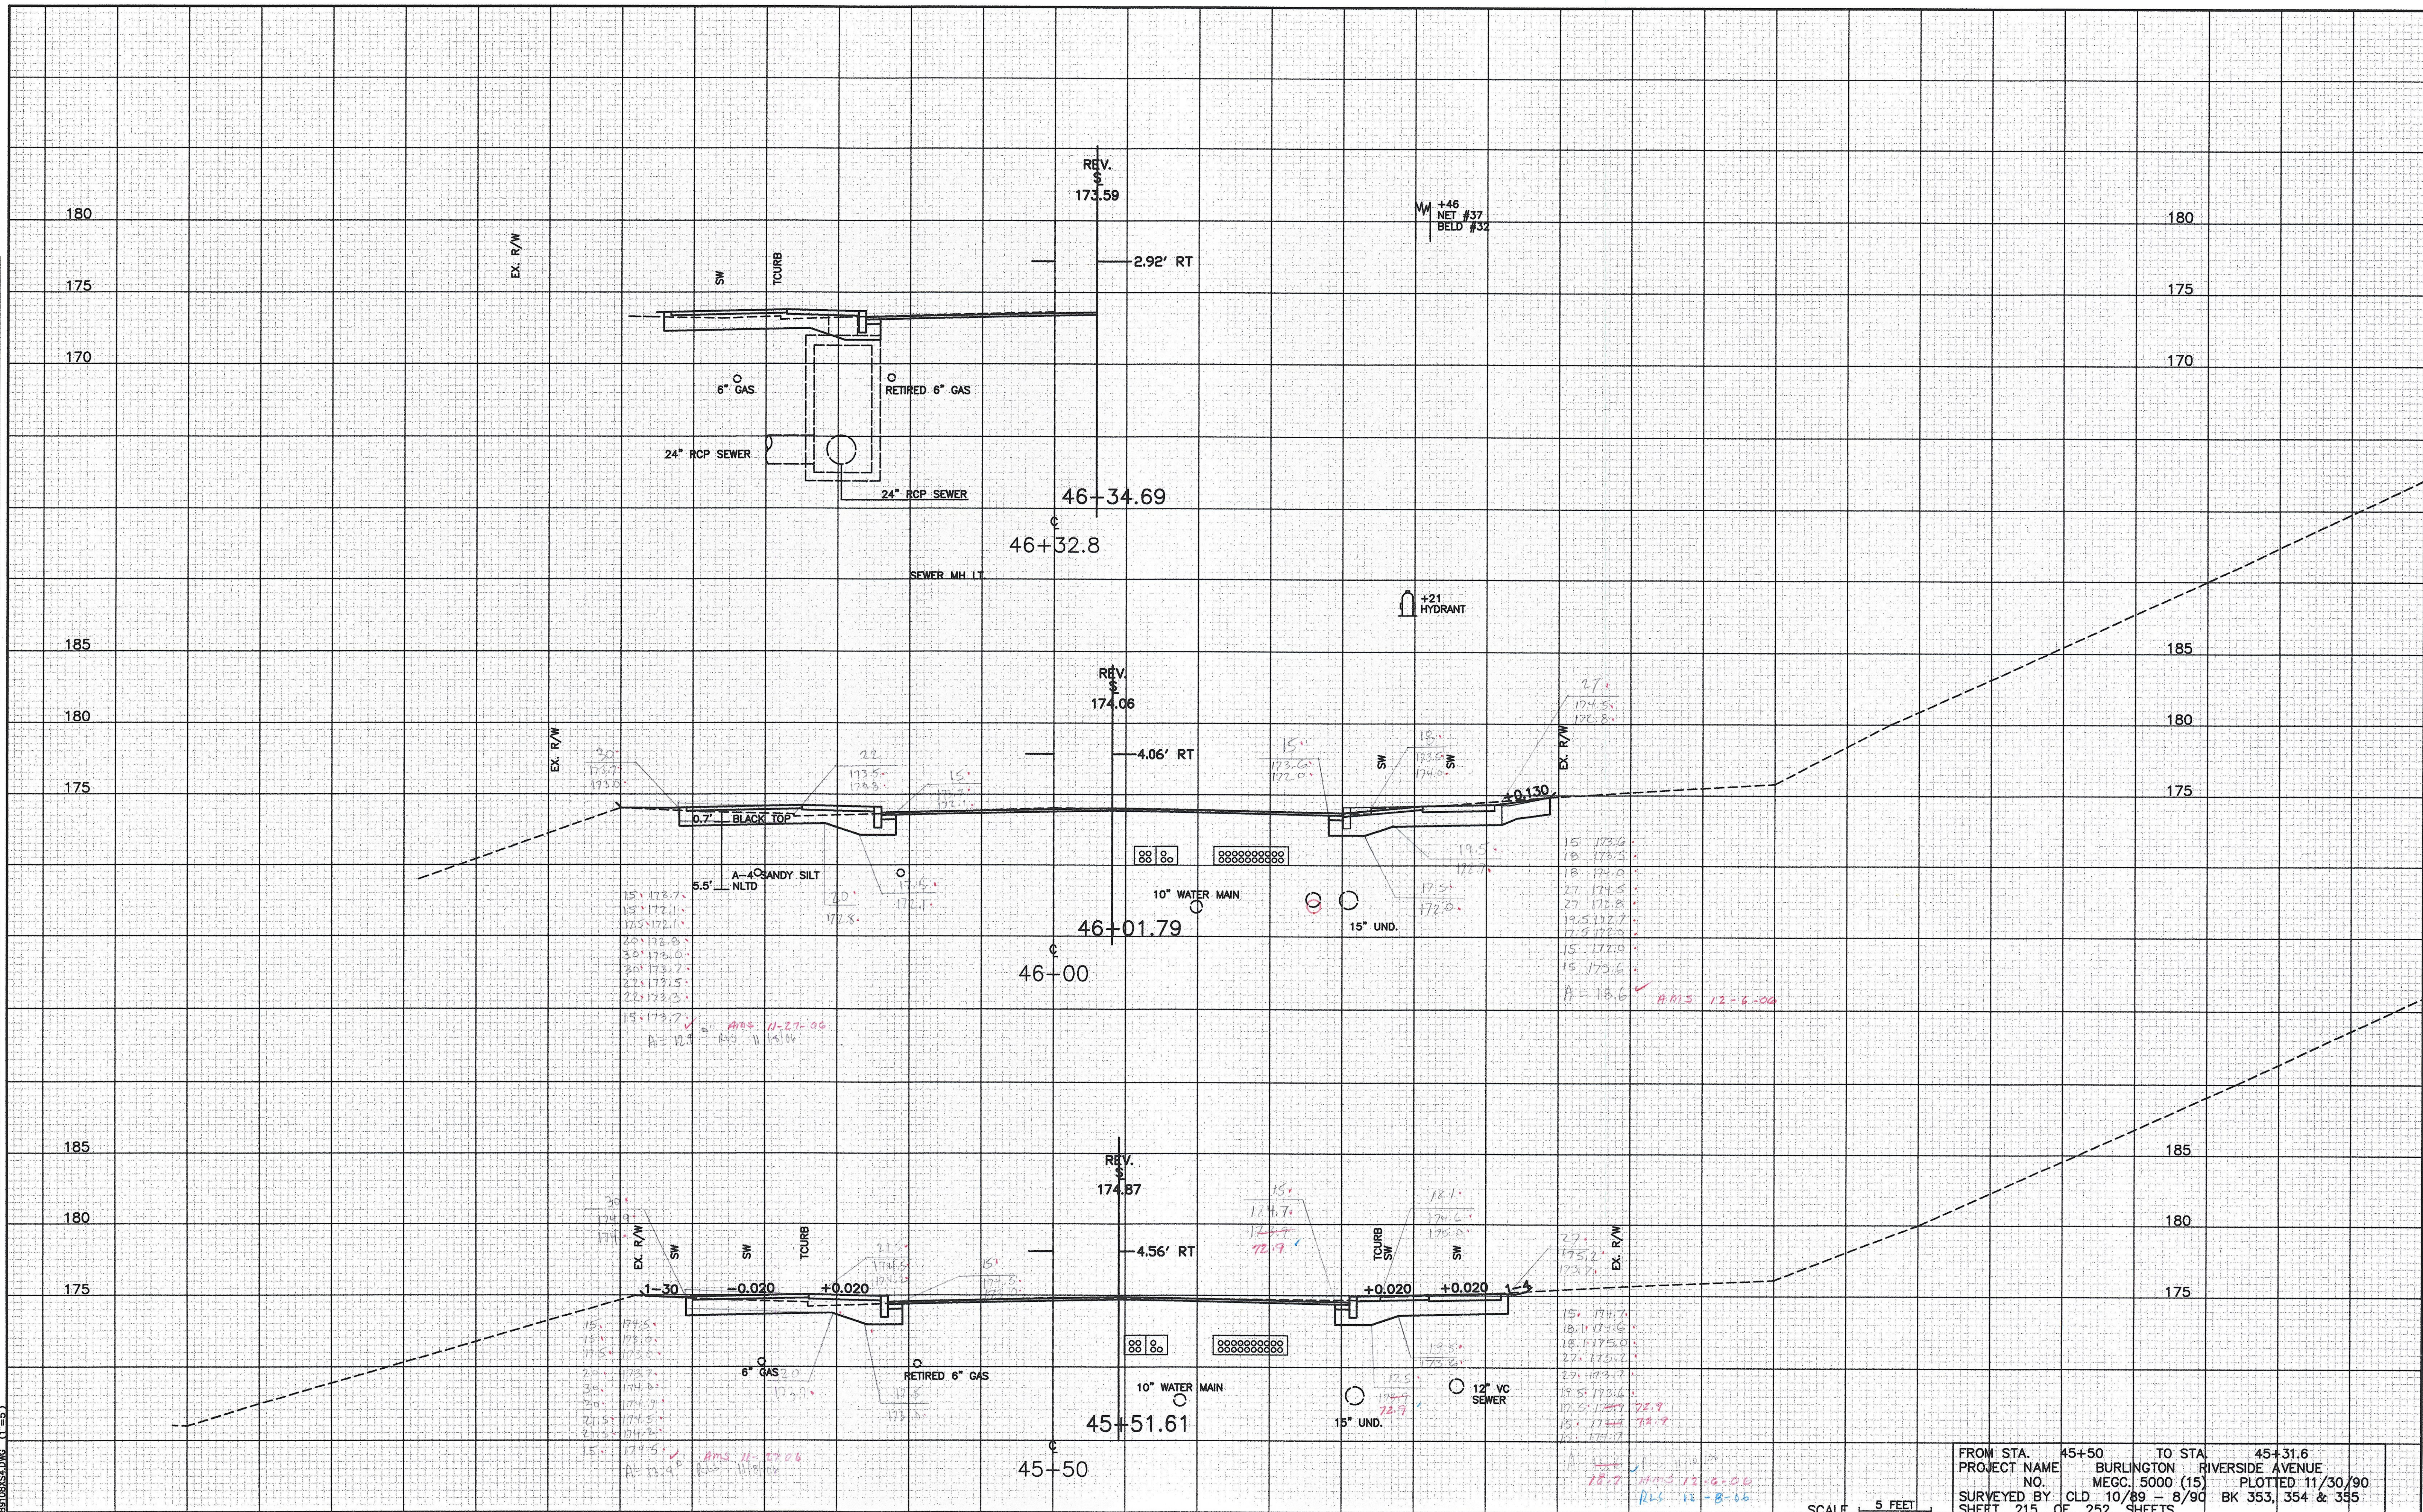

BELLINGSLING (1\"/>

18.12  
36.4  
745.33

FROM STA. 45+50 TO STA. 45+31.6  
 PROJECT NAME BURLINGTON RIVERSIDE AVENUE  
 NO. MECC. 5000 (15) PLOTTED 11/30/90  
 SURVEYED BY CLD 10/89 - 8/90 BK 353, 354 & 355  
 SHEET 215 OF 252 SHEETS

SCALE 1" = 5 FEET

18.12  
36.4  
745.33  
 11-27-90  
 12-8-90