


5 x 8.27' x .600 lbs
8 x 5.67' x

21

DATE	
BY	
FINAL SURVEY PLOTTED	
NOTED	
NO.	

DATE	
BY	
ORIGINAL SURVEY PLOTTED	
NOTED	
NO.	

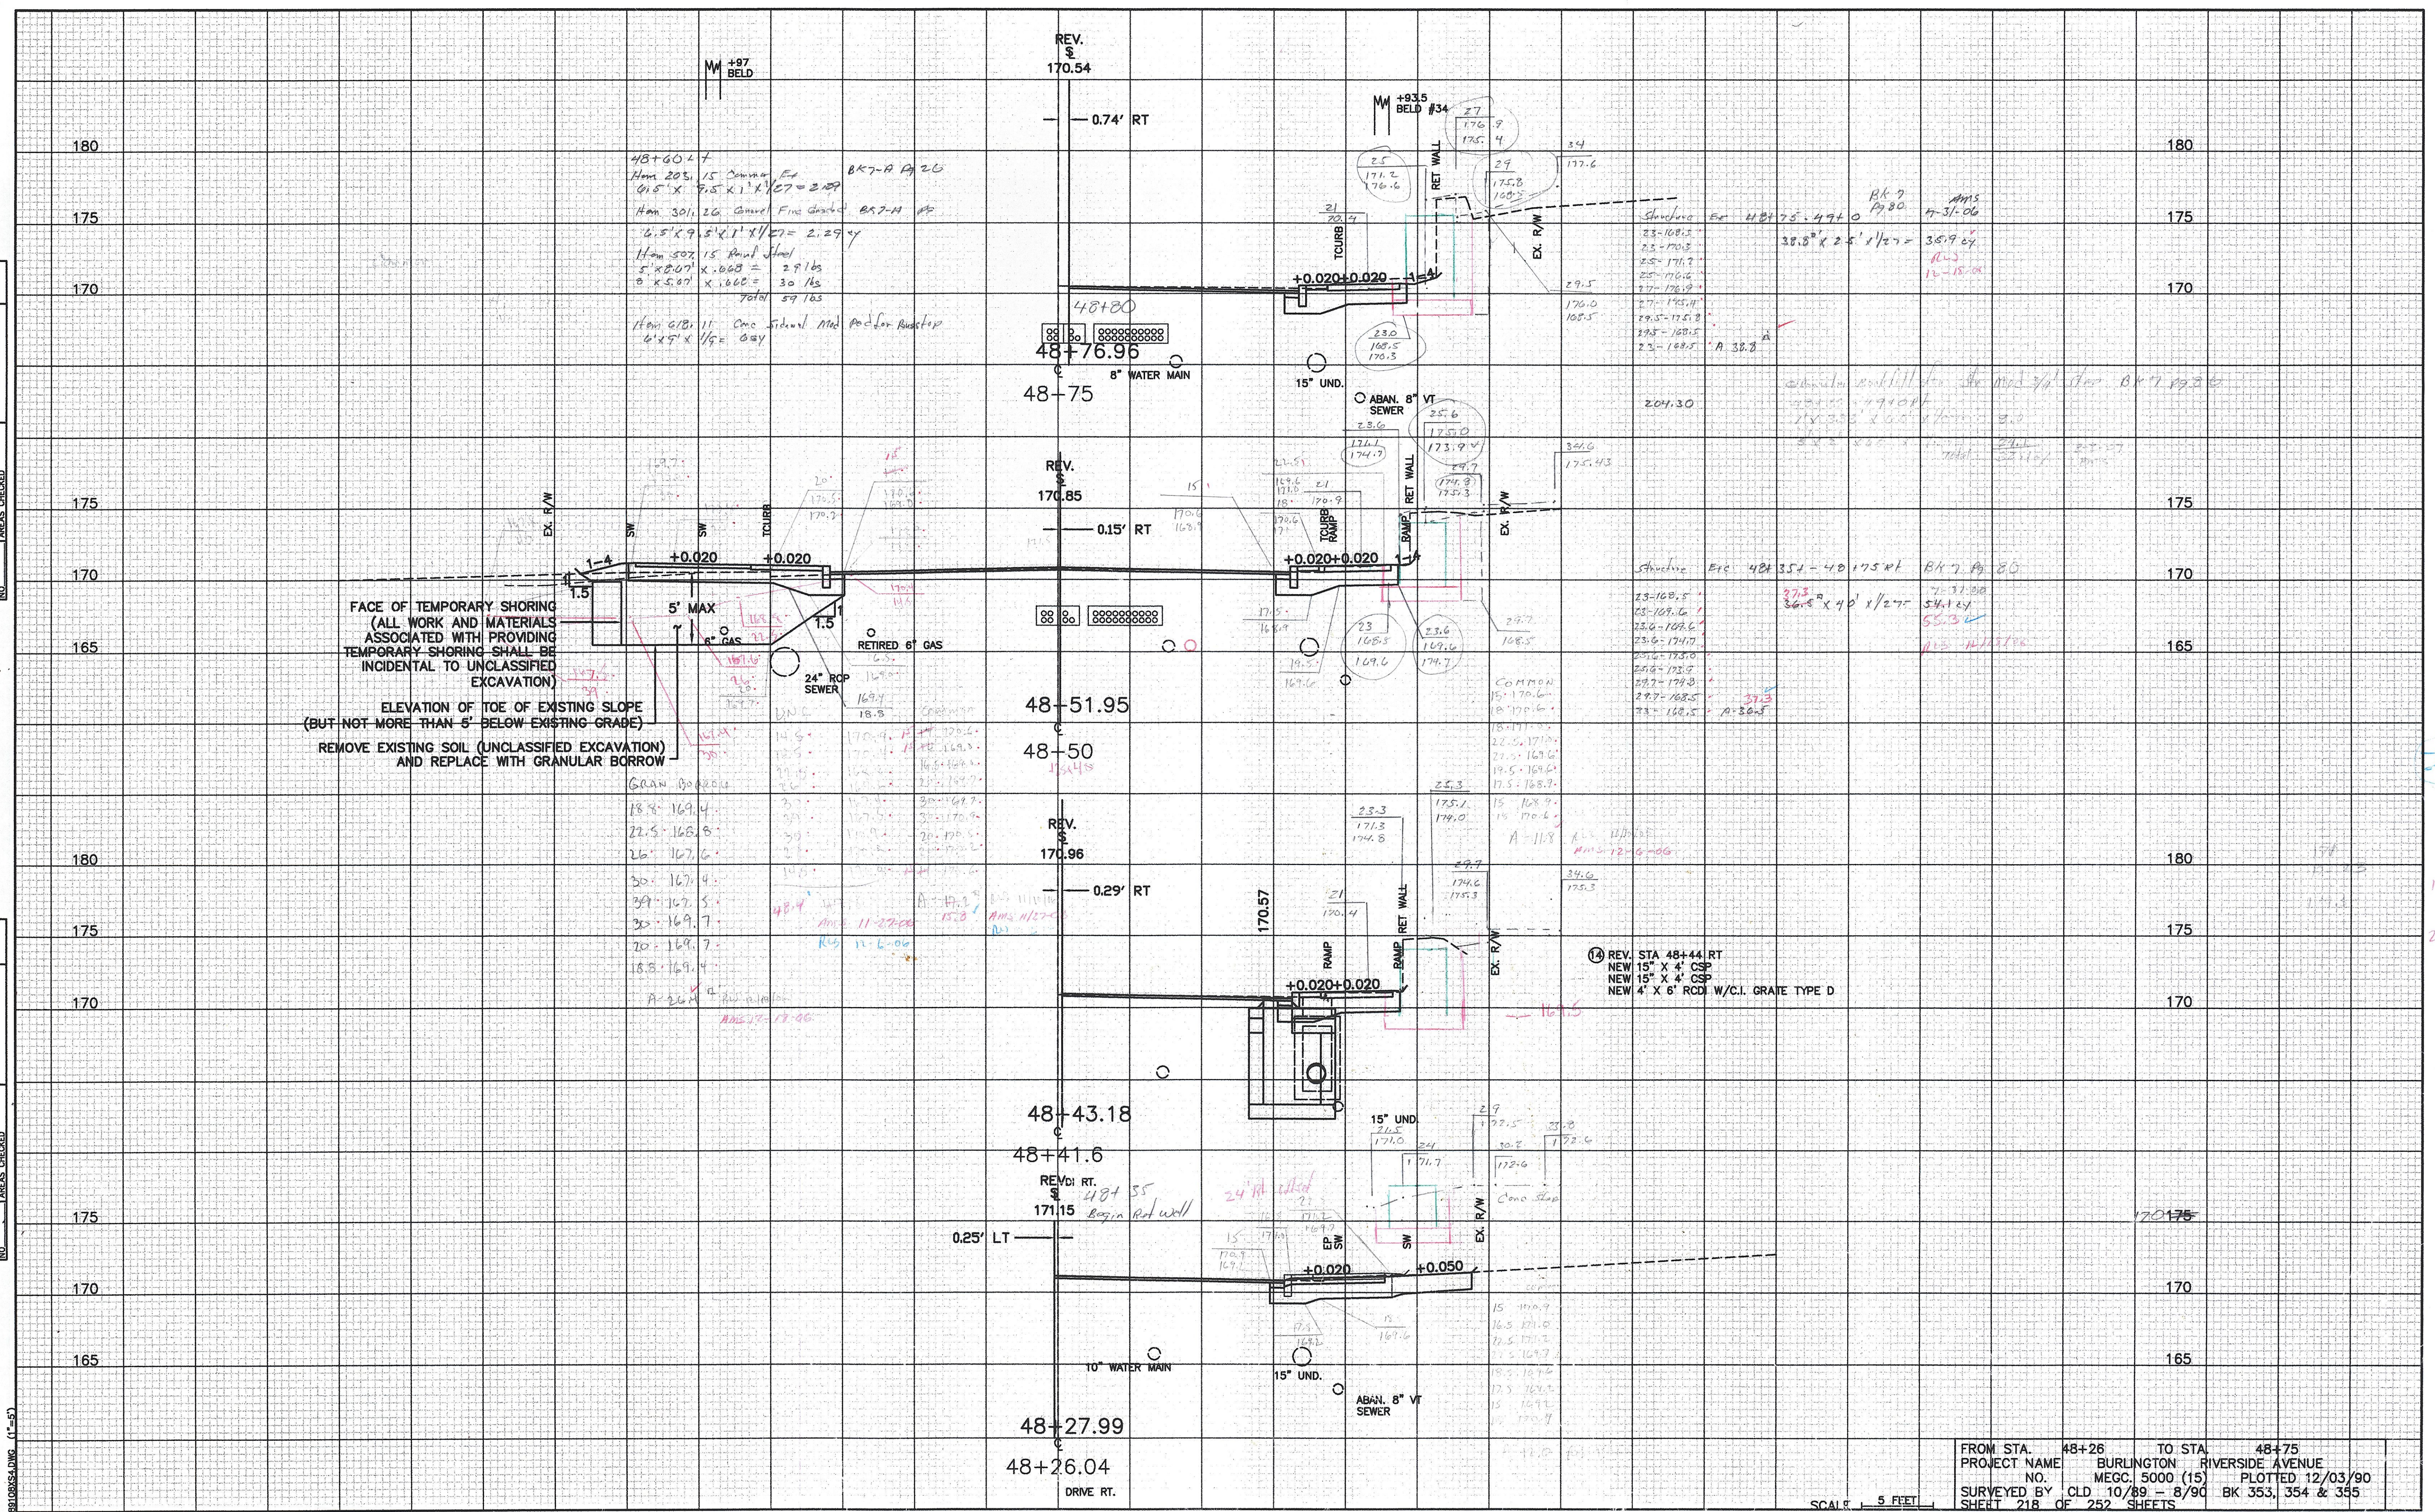

FACE OF TEMPORARY SHORING
(ALL WORK AND MATERIALS
ASSOCIATED WITH PROVIDING
TEMPORARY SHORING SHALL BE
INCIDENTAL TO UNCLASSIFIED
EXCAVATION)

ELEVATION OF TOE OF EXISTING SLOPE
(BUT NOT MORE THAN 5' BELOW EXISTING GRADE)

REMOVE EXISTING SOIL (UNCLASSIFIED EXCAVATION)
AND REPLACE WITH GRANULAR BORROW

REV. STA 48+44 RT
NEW 15" X 4" CSP
NEW 15" X 4" CSP
NEW 4' X 6' RCD W/C.I. GRATE TYPE D

FROM STA. 48+26 TO STA. 48+75
PROJECT NAME BURLINGTON RIVERSIDE AVENUE
NO. MECC. 5000 (15) PLOTTED 12/03/90
SURVEYED BY CLD 10/89 - 8/90 BK 353, 354 & 355
SHEET 218 OF 252 SHEETS

SCALE 5 FEET

8/10/88/CLD (1-5)