


DATE	
BY	
FINAL SURVEY	
PLOTTED	
NOTED	
AREAS CHECKED	
NO	

DATE	
BY	
ORIGINAL SURVEY	
PLOTTED	
NOTED	
AREAS CHECKED	
NO	

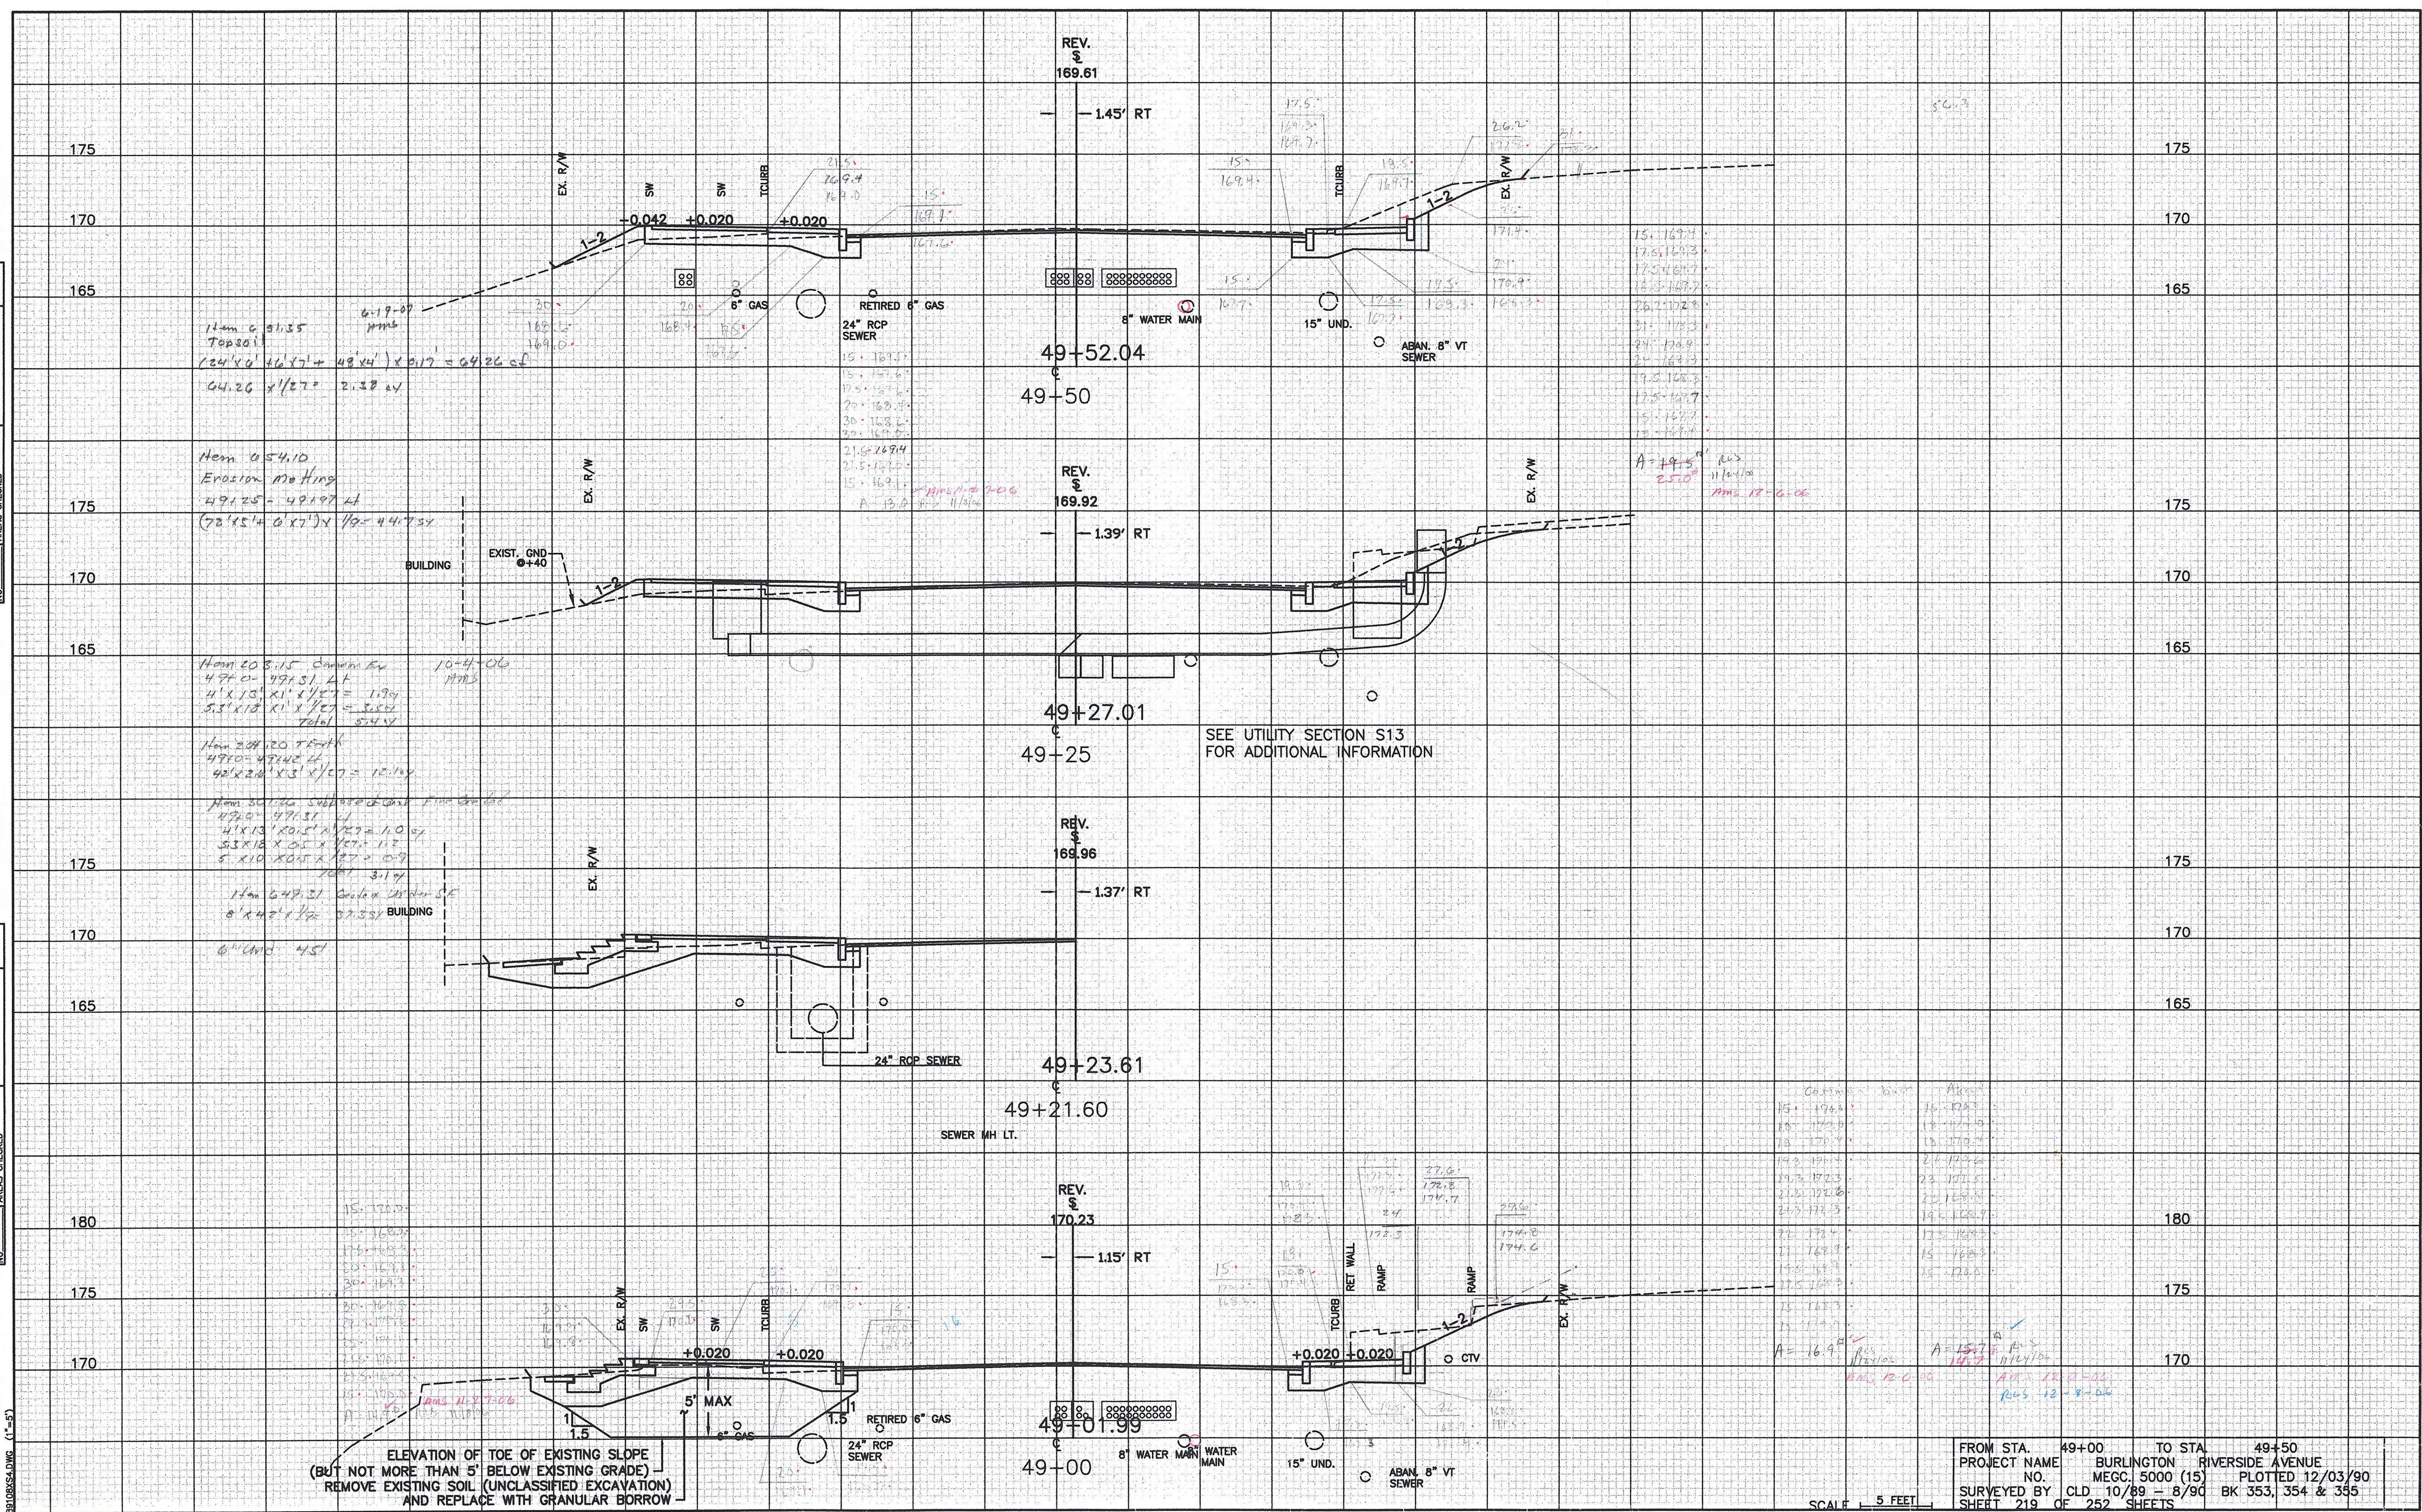

SUBSCALE (1"=5')

SCALE 5 FEET

FROM STA. 49+00 TO STA. 49+50
 PROJECT NAME BURLINGTON RIVERSIDE AVENUE
 NO. MECC. 5000 (15) PLOTTED 12/03/90
 SURVEYED BY CLD 10/89 = 8/90 BK 353, 354 & 355
 SHEET 219 OF 252 SHEETS