


DATE	
BY	
FINAL SURVEY	
FLUORIDED	
TEMPERATURE	
NOTED	
NO.	

DATE	
BY	
ORIGINAL SURVEY	
FLUORIDED	
TEMPERATURE	
NOTED	
NO.	

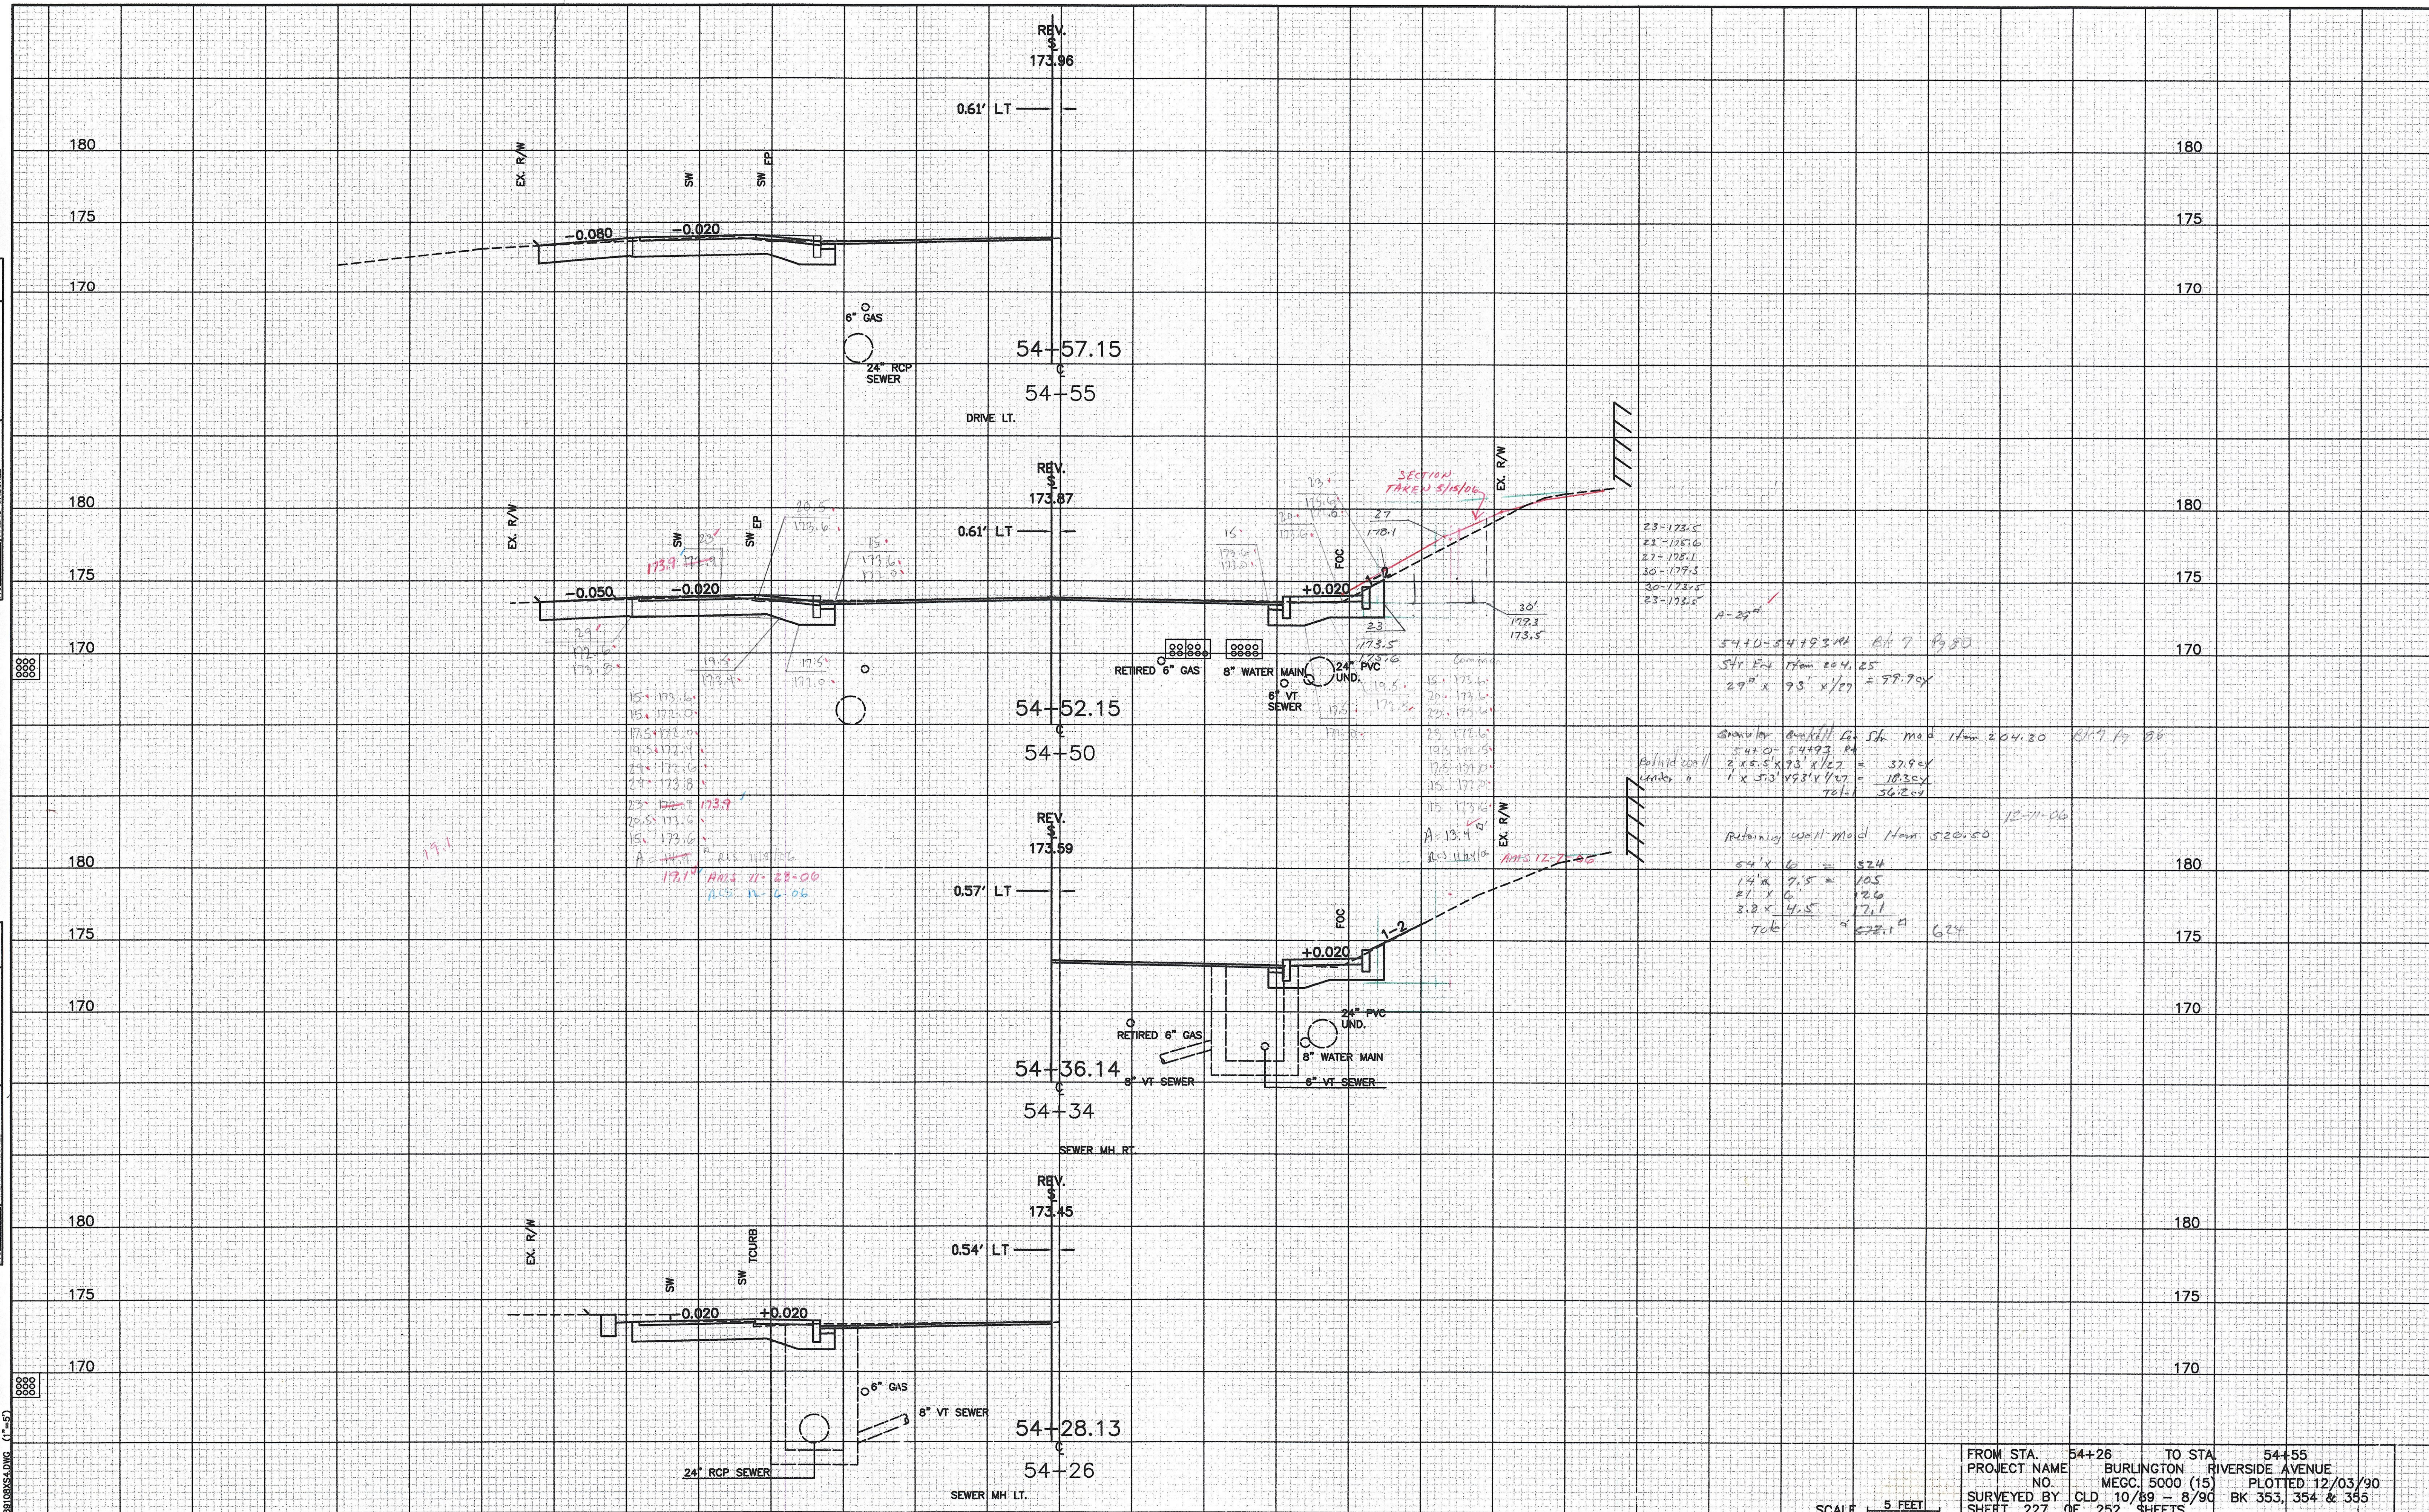

23-173.5	
23-173.6	
27-172.1	
30-172.5	
30-173.5	
23-172.5	
A-20'	
54+0-54+9.341 RA 7 49.80	
Sta. End 15m 204.25	
2.9' x 9.8' x 1/2' = 99.90x	
Granular backfill to Sta. mod 11m 204.30	
54+0-54+9.3 RA	
2 x 5.5' x 9.8' x 1/2' = 37.90x	
1 x 5' x 9.8' x 1/2' = 10.35x	
10.6'	
36.200	
Retaining wall mod 11m 520.50	
12-11-06	
54' x 6' = 324	
14' x 7.5' = 105	
21' x 6' = 126	
3.2 x 4.5 = 14.4	
706	
522.1	
624	

FROM STA. 54+26 TO STA. 54+55
 PROJECT NAME BURLINGTON RIVERSIDE AVENUE
 NO. MECC 5000 (15) PLOTTED 12/03/90
 SURVEYED BY CLD 10/89 - 8/90 BK 353, 354 & 355
 SHEET 227 OF 252 SHEETS

SCALE 5 FEET

8810855.DWG (1-5)