
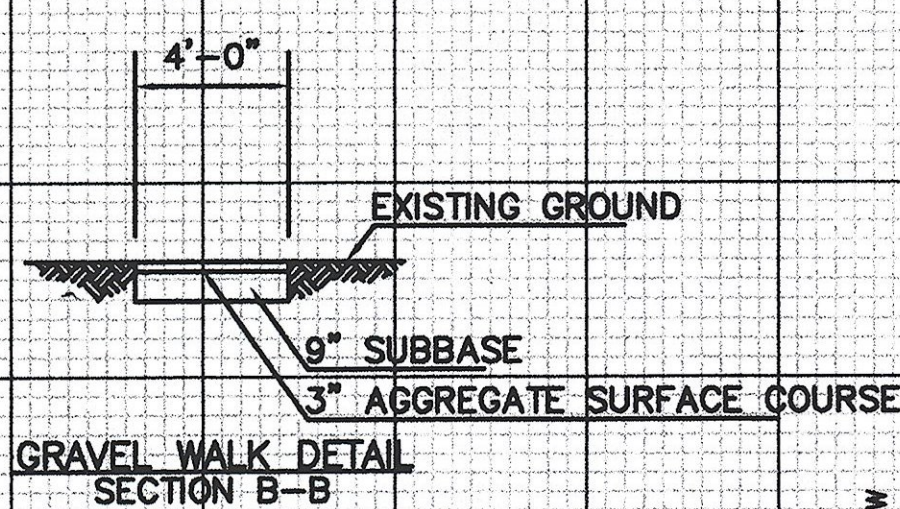


DATE	
BY	
REVISIONS	
NO.	
DATE	
BY	
REVISIONS	
NO.	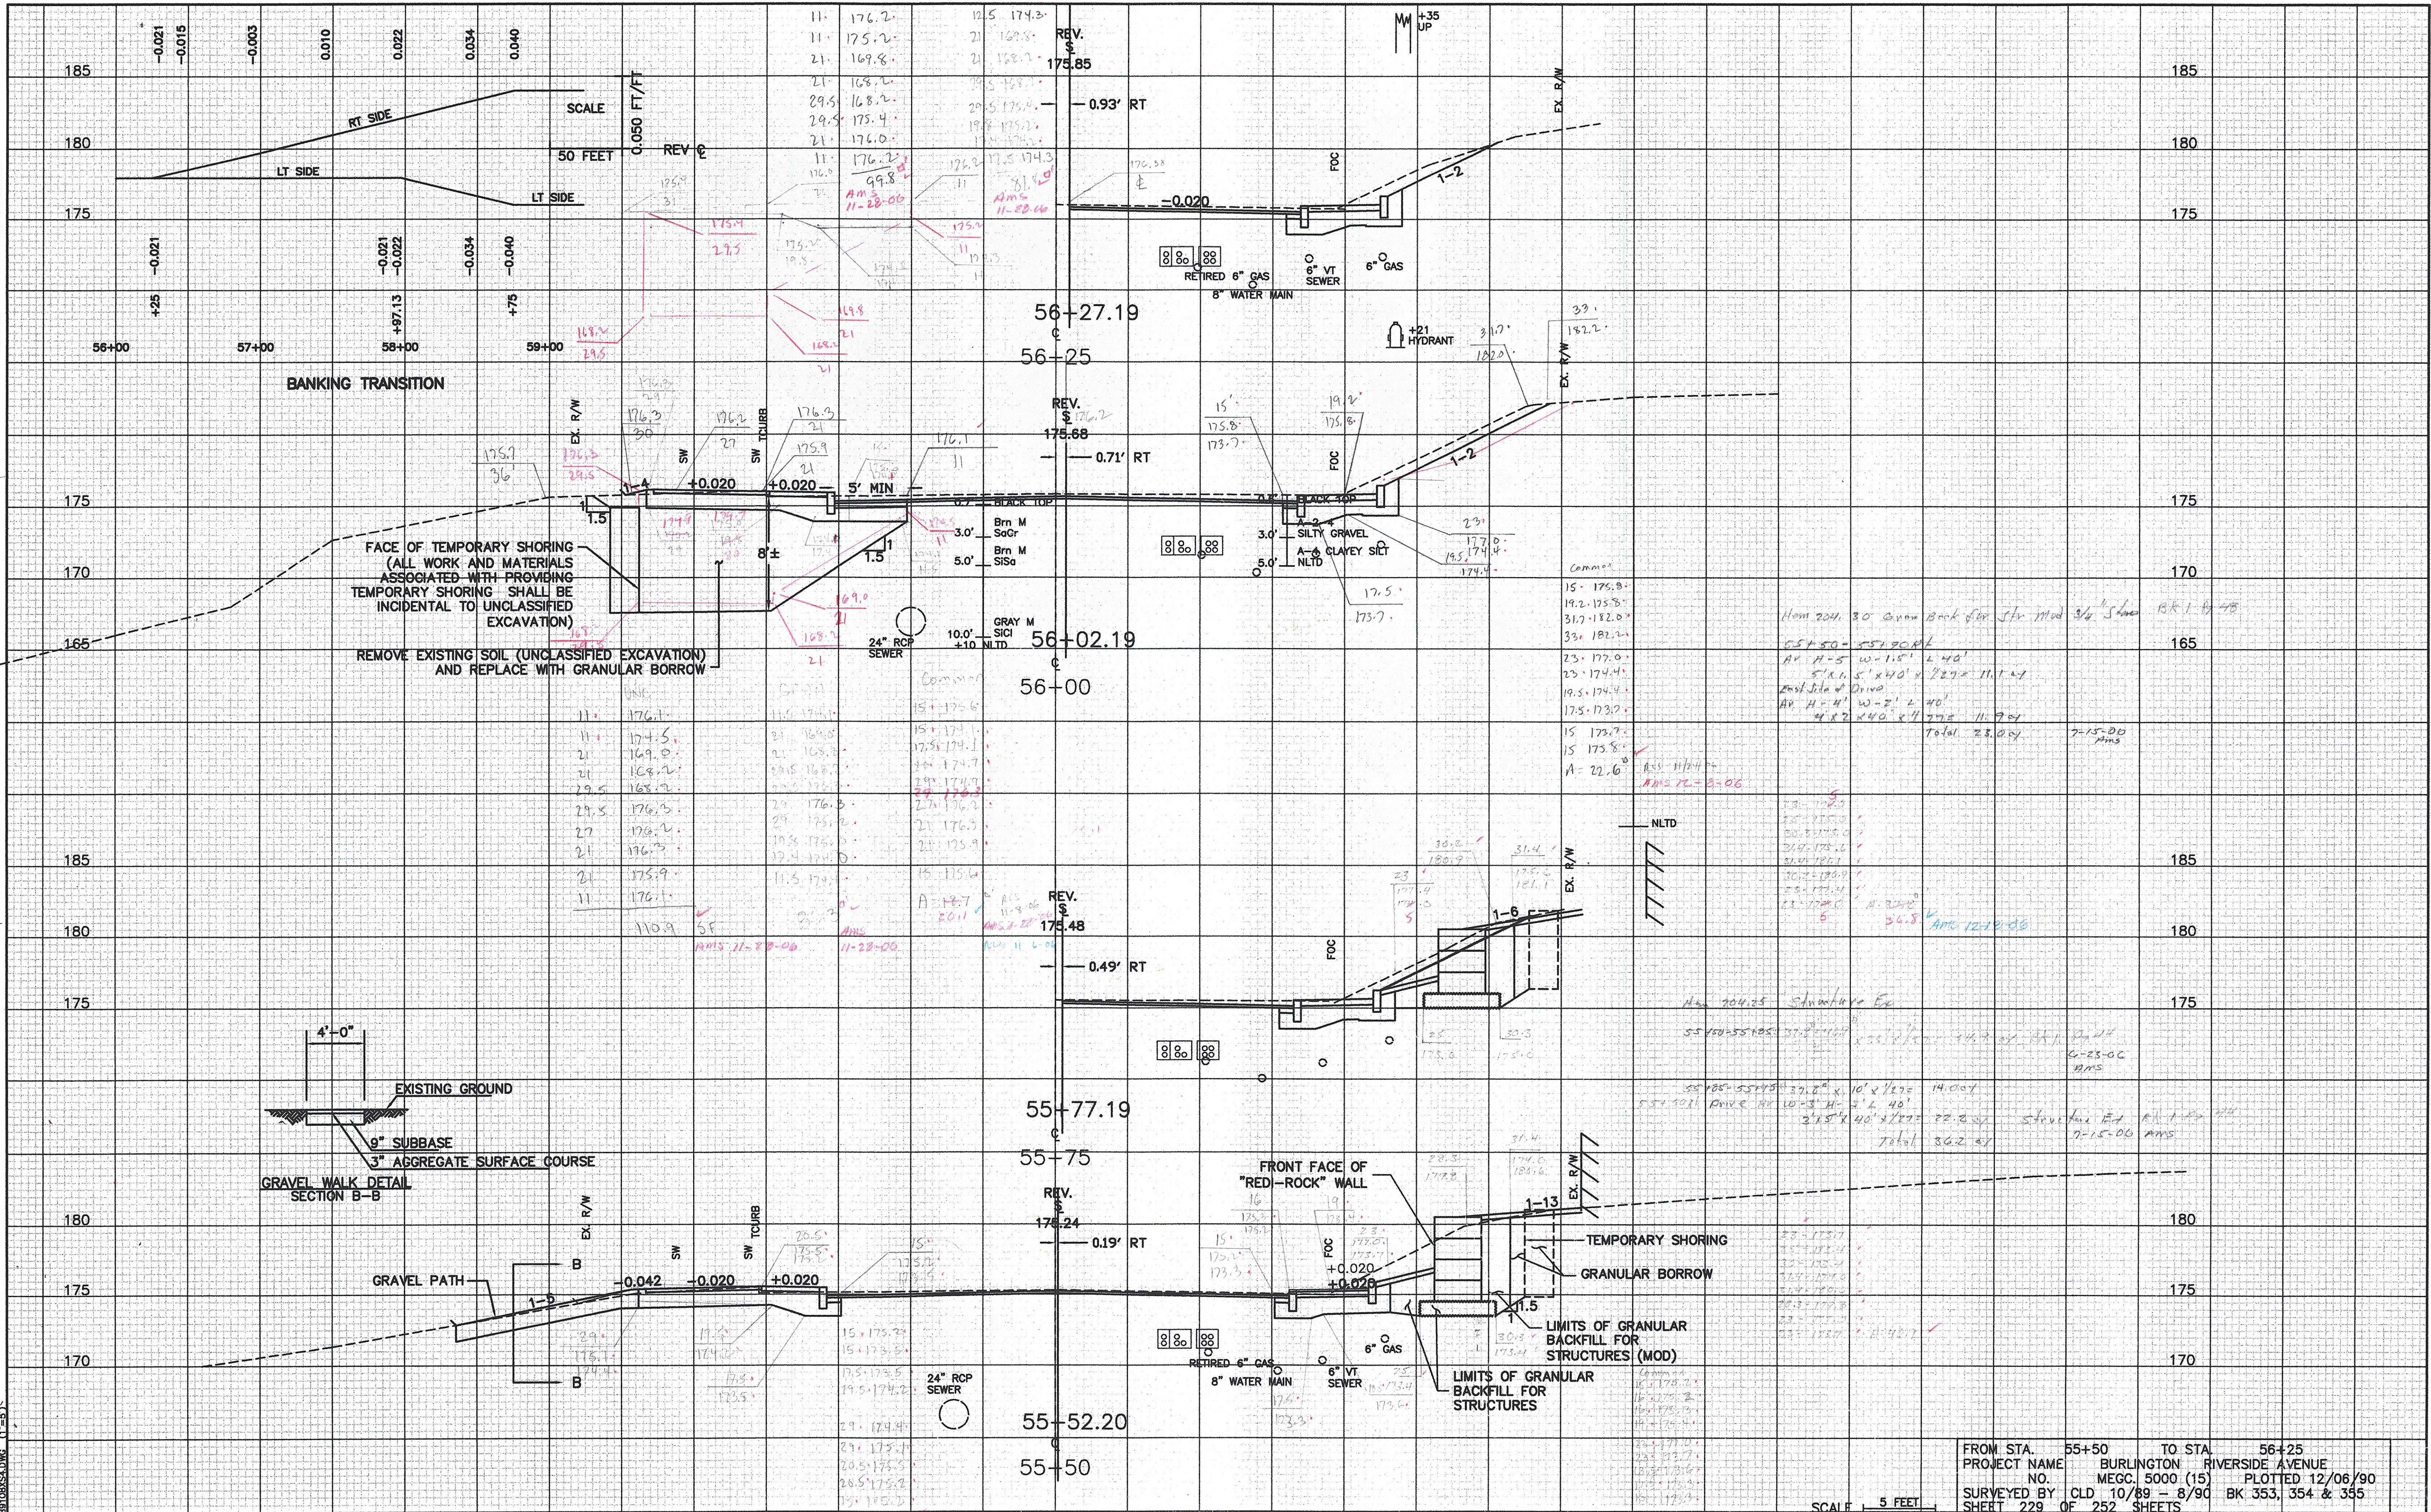
FROM STA. 55+50 TO STA. 56+25  
 PROJECT NAME BURLINGTON RIVERSIDE AVENUE  
 NO. MECC. 5000 (15) PLOTTED 12/06/90  
 SURVEYED BY CLD 10/89 - 8/90 BK 353, 354 & 355  
 SHEET 229 OF 252 SHEETS

SCALE 1" = 5 FEET

A = 16.4' AMS 11-29-00

A = 17.9' AMS 12-8-00