

5.20  
-1.16  
5.04


B 51210-5210 SF Type

176.72

MM +65  
NET #40/46

DATE	
BY	
FINAL SURVEY	
SURVEY PLOTTED	
TEMPERATURE	
NOTEBOOK	
AREAS CHECKED	
NO	

DATE	
BY	
ORIGINAL SURVEY	
SURVEY PLOTTED	
TEMPERATURE	
NOTEBOOK	
AREAS CHECKED	
NO	

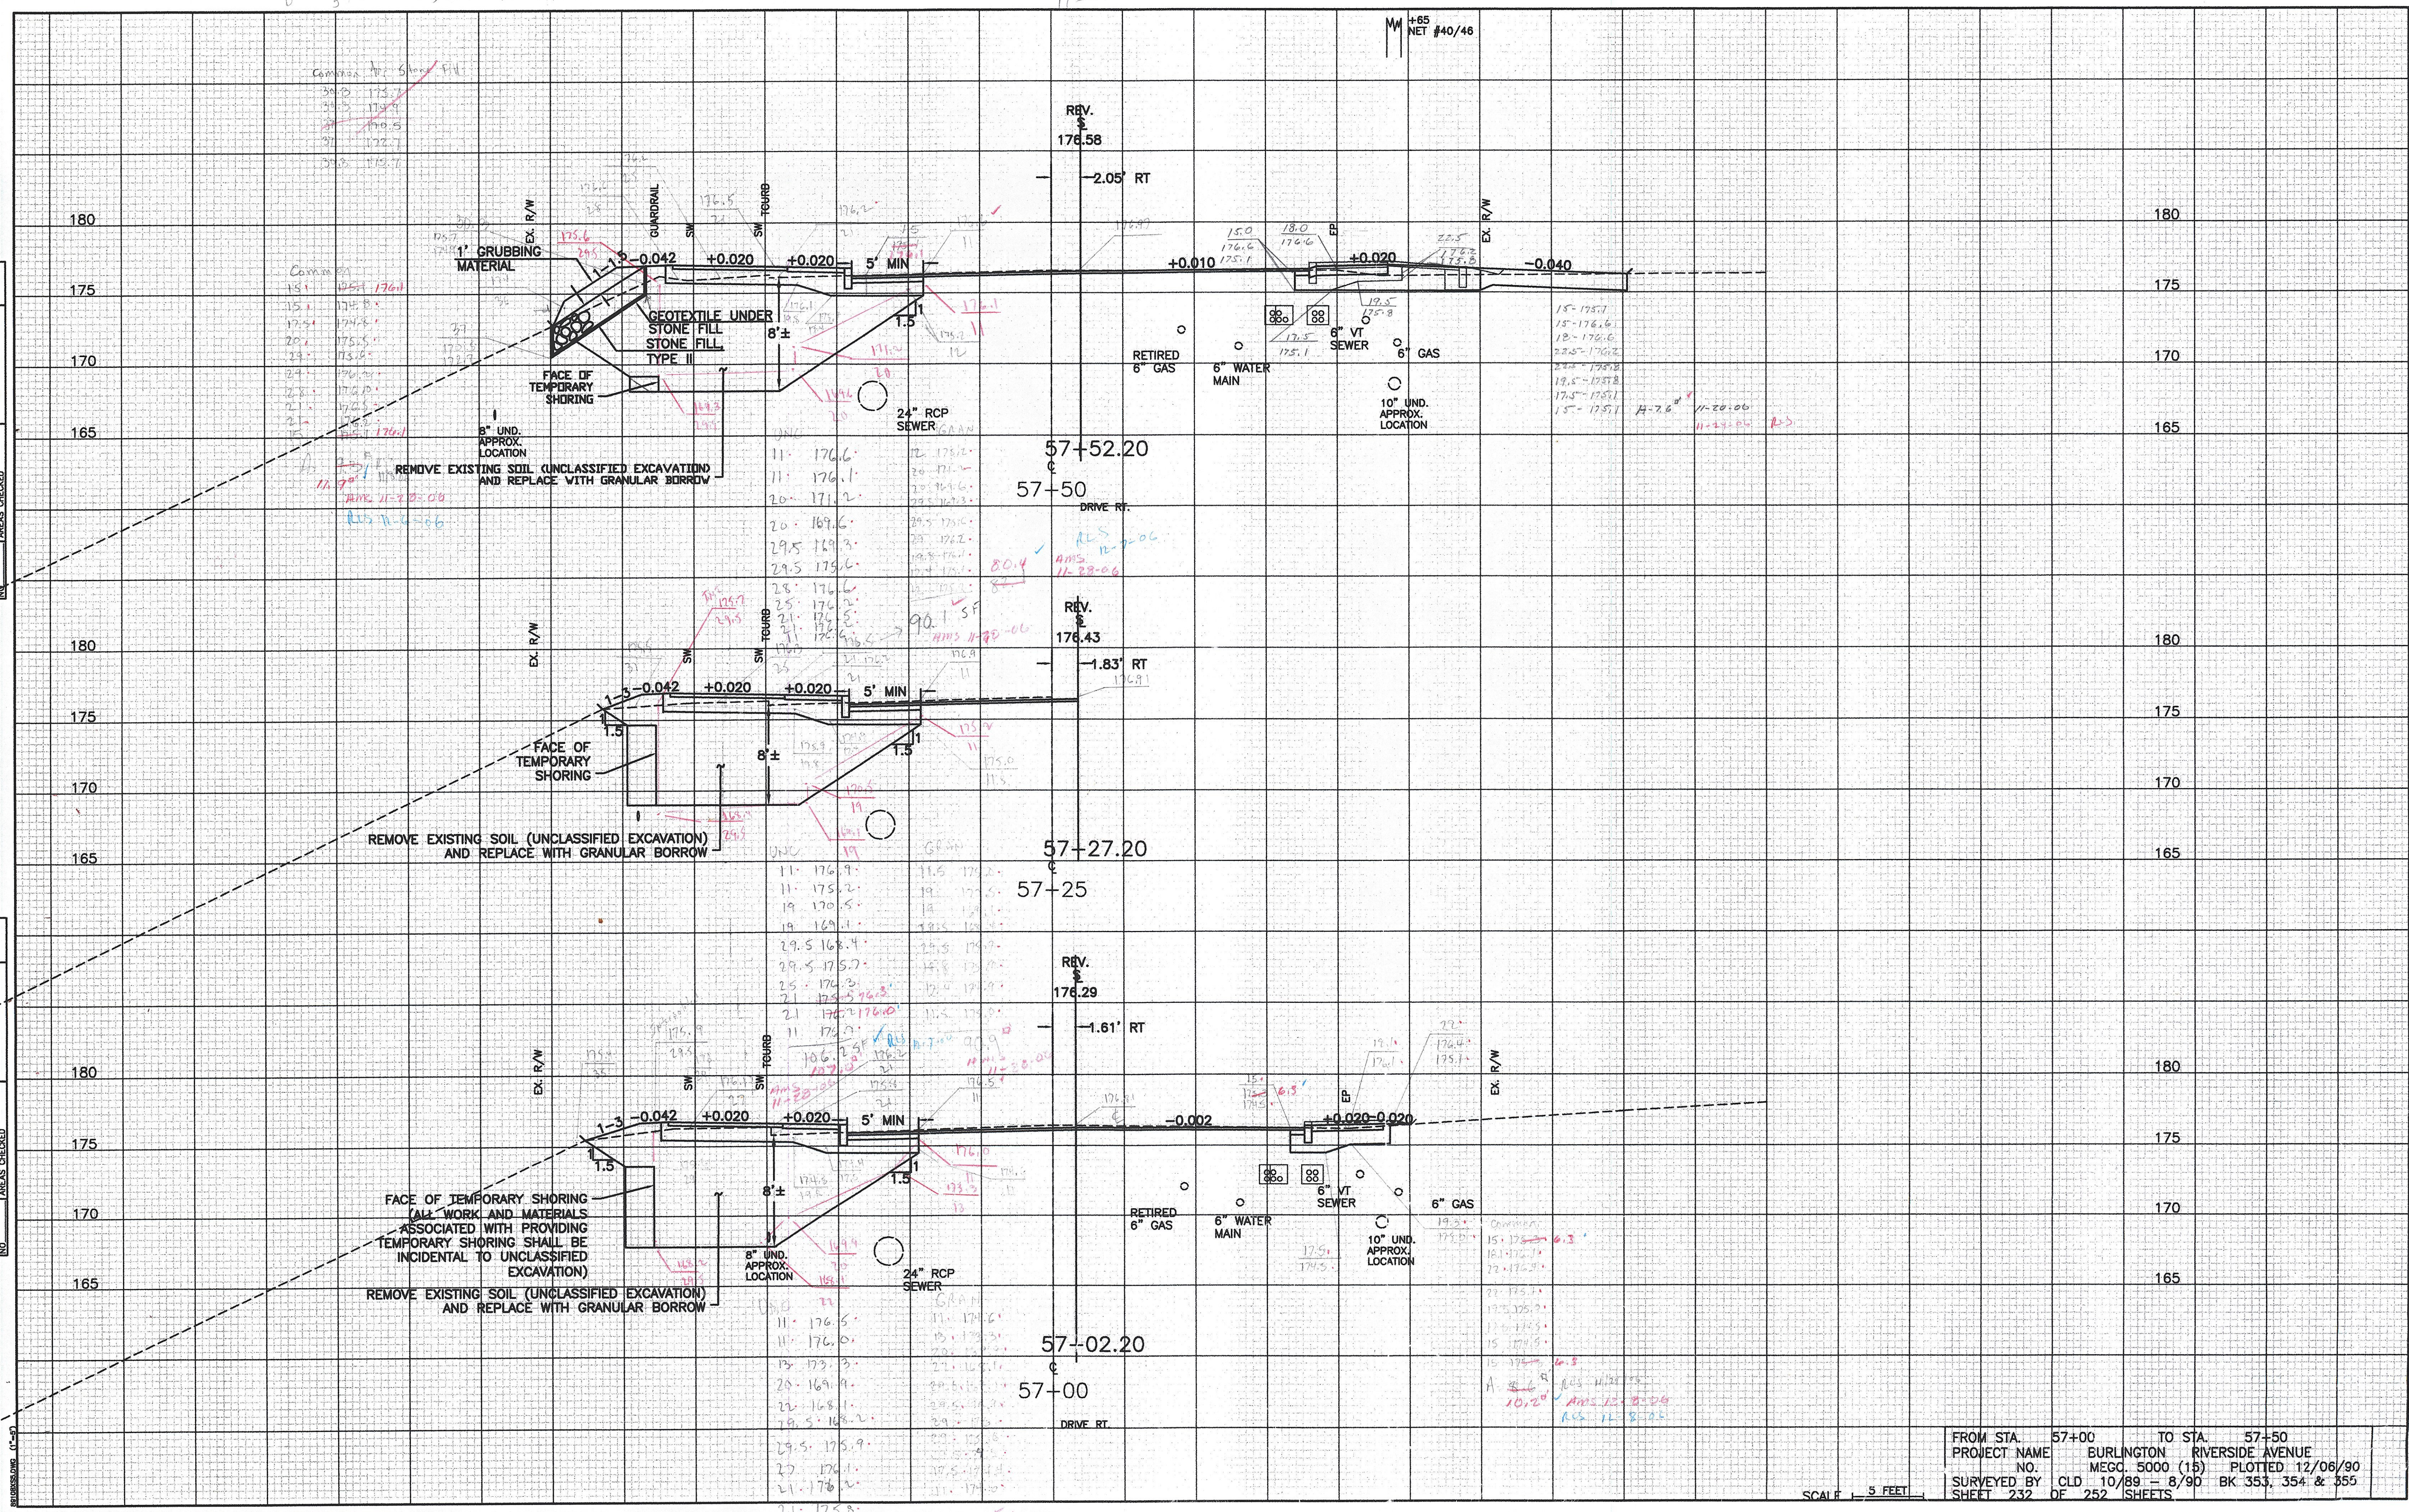

FROM STA. 57+00 TO STA. 57+50  
 PROJECT NAME BURLINGTON RIVERSIDE AVENUE  
 NO. MEGC. 5000 (15) PLOTTED 12/06/90  
 SURVEYED BY CLD 10/89 - 8/90 BK 353, 354 & 355  
 SHEET 232 OF 252 SHEETS

SCALE 5 FEET

51 187.9  
 108.2  
 AMS 11-28-04