


DATE	
BY	
FINAL SURVEY	
PLOTTED	
TEMPLATE	
NO. OF SHEETS	
AREAS CHECKED	

DATE	
BY	
ORIGINAL SURVEY	
PLOTTED	
TEMPLATE	
NO. OF SHEETS	
AREAS CHECKED	

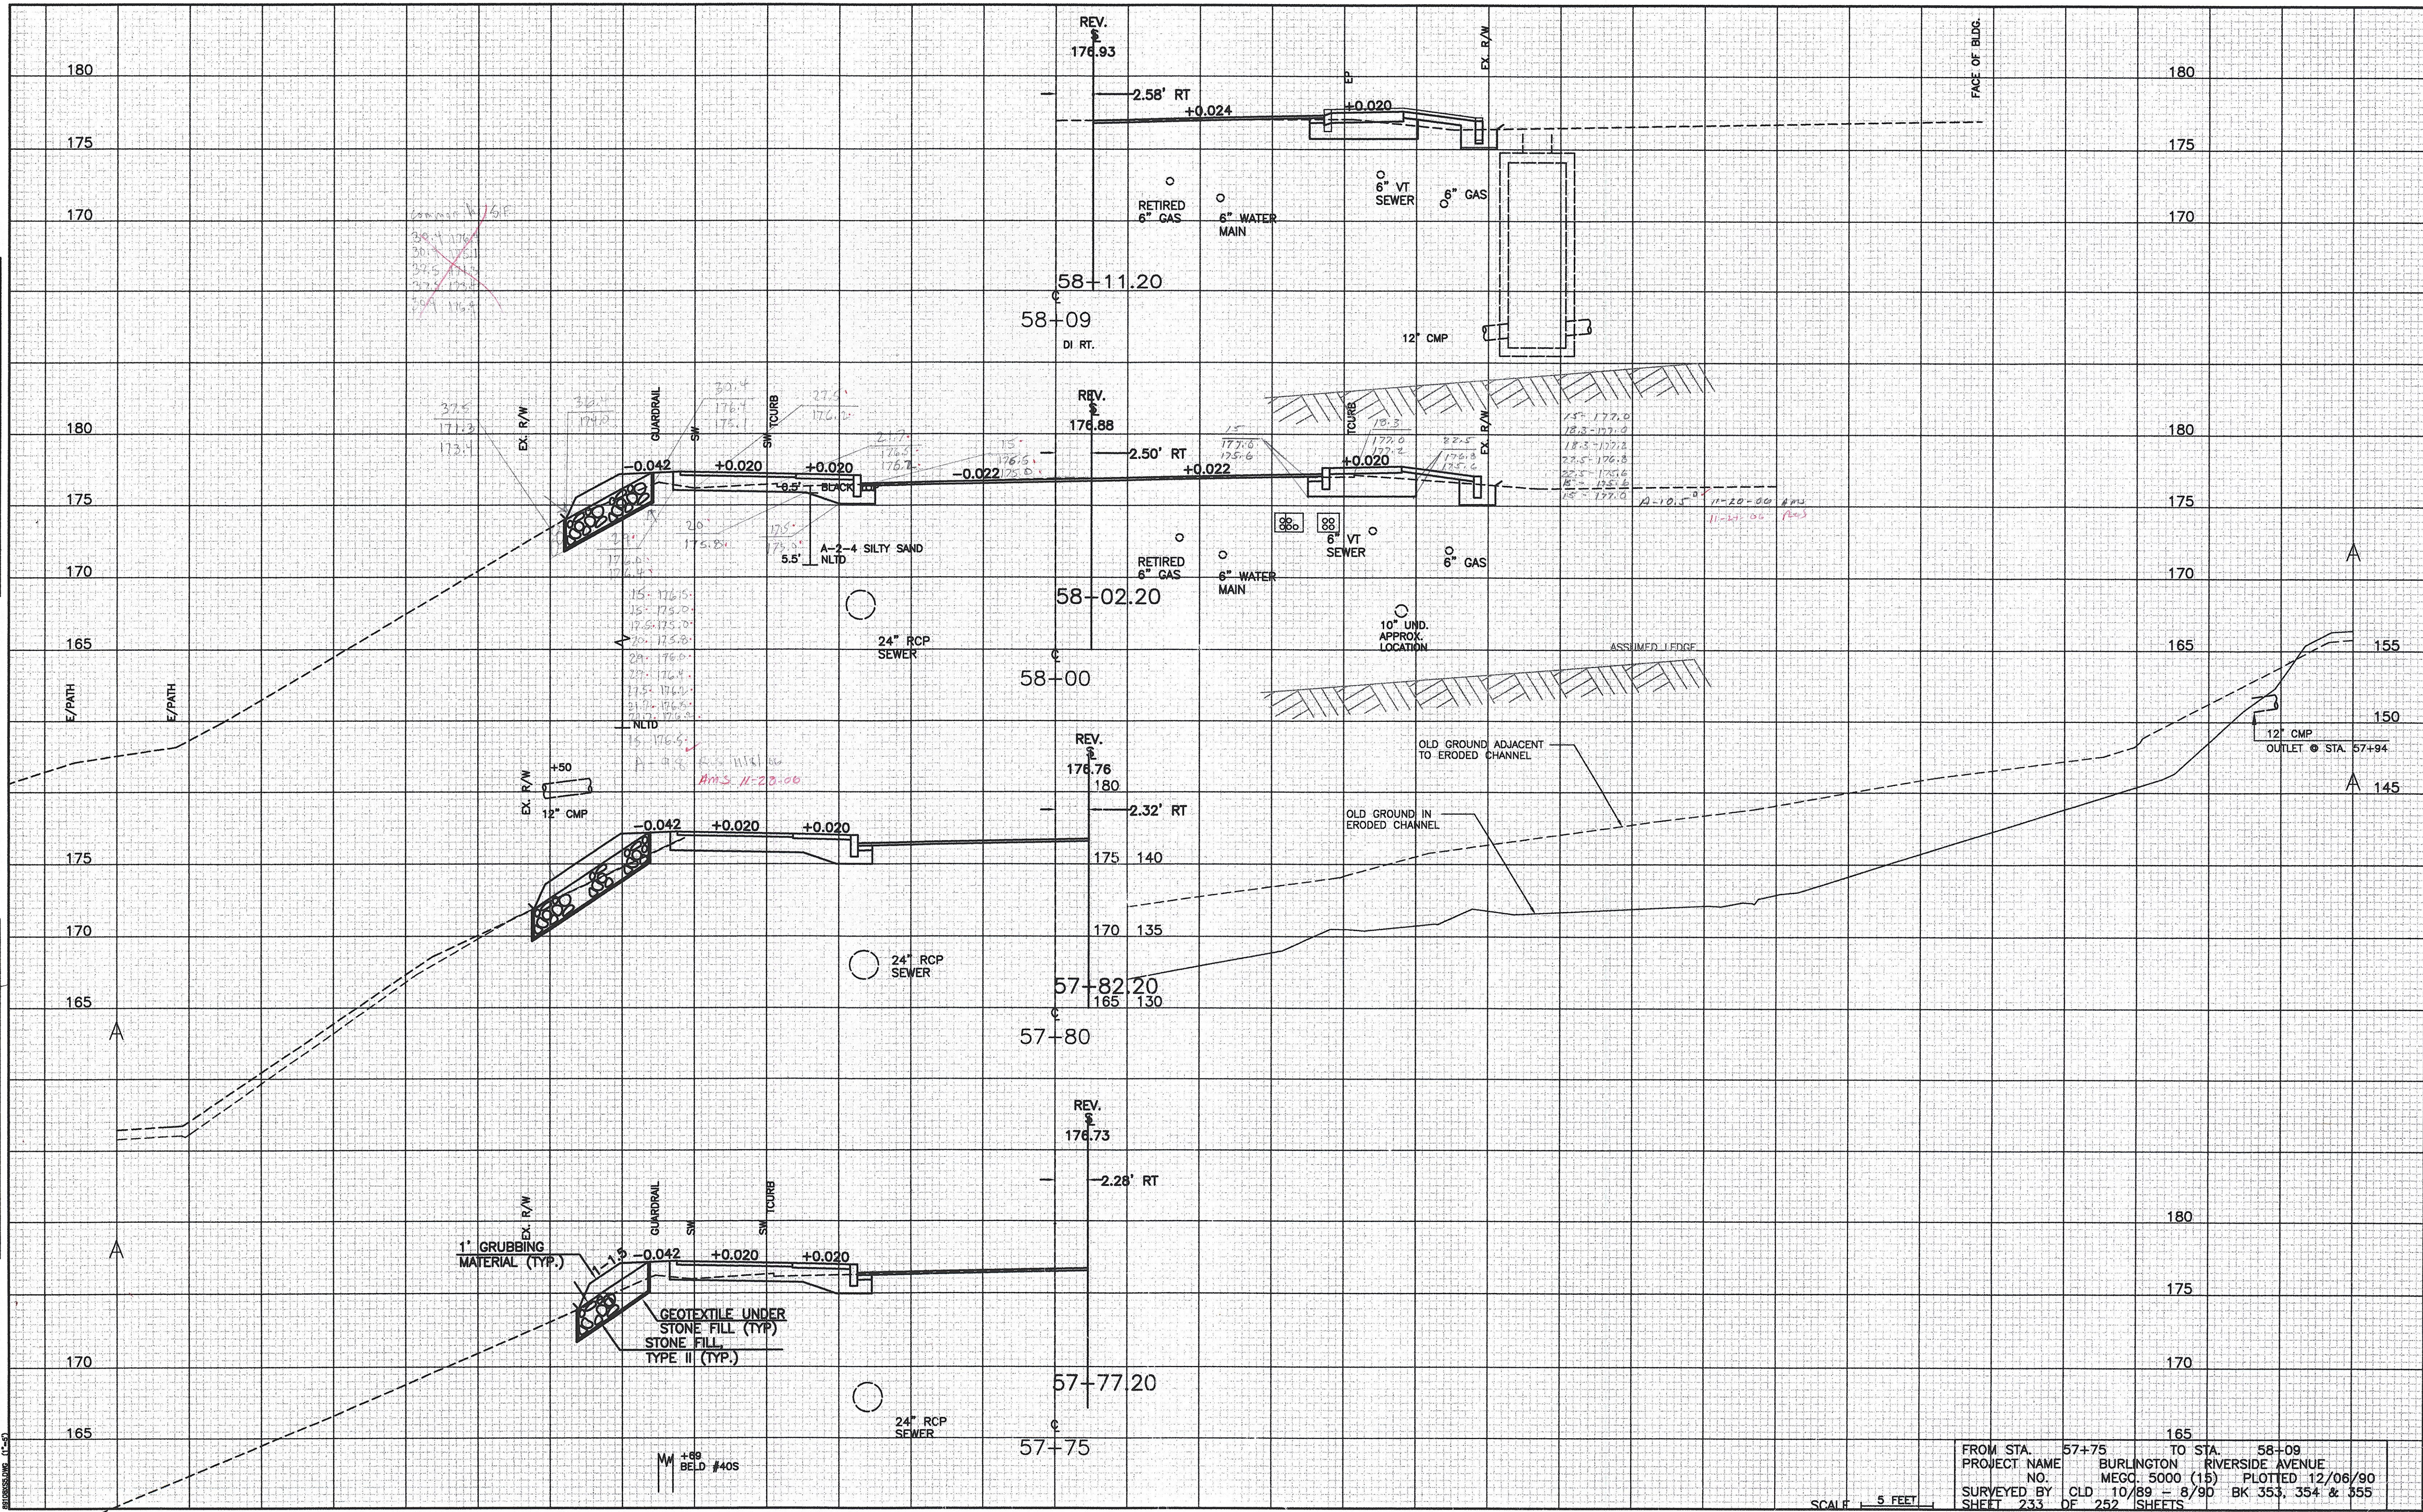

FROM STA. 57+75 TO STA. 58+09  
 PROJECT NAME BURLINGTON RIVERSIDE AVENUE  
 NO. MEGG. 5000 (15) PLOTTED 12/06/90  
 SURVEYED BY CLD 10/89 - 8/90 BK 353, 354 & 355  
 SHEET 233 OF 252 SHEETS

SCALE 5 FEET