


DATE	
BY	
FINAL SURVEY	
PLOTTED	
NO. DATE	
AREAS	
CHECKED	
NO.	

DATE	
BY	
ORIGINAL SURVEY	
PLOTTED	
NO. DATE	
AREAS	
CHECKED	
NO.	

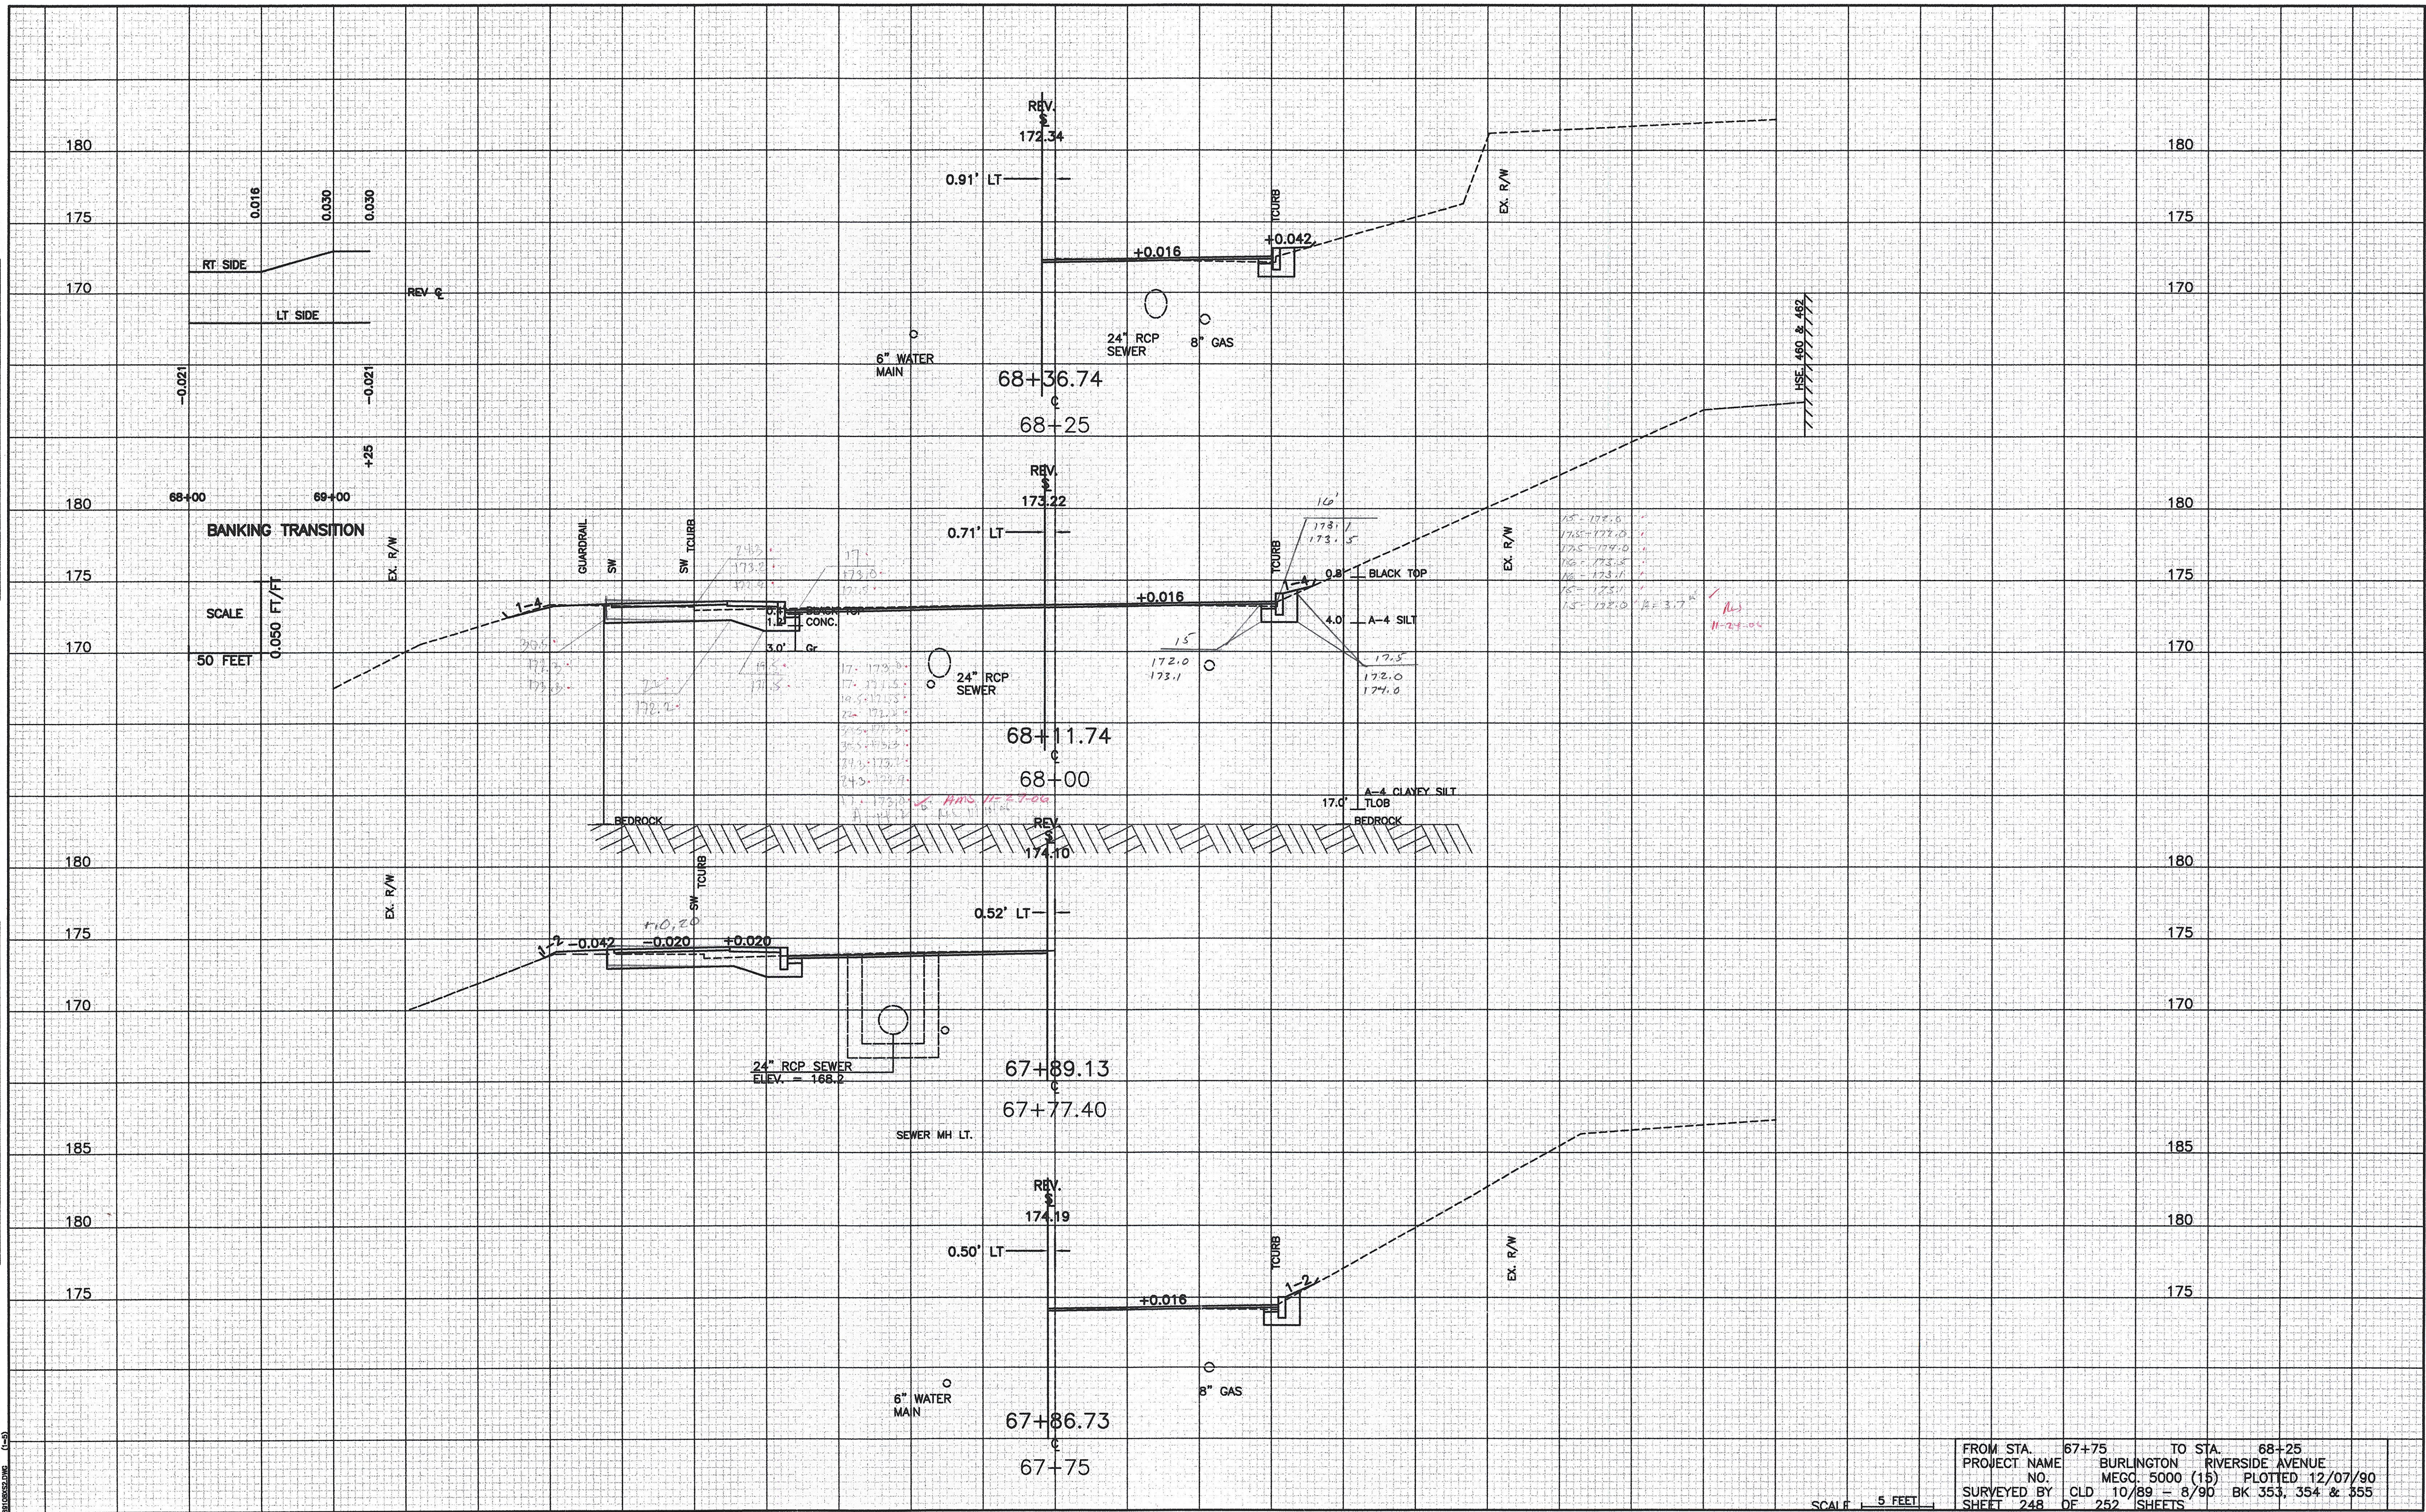

FROM STA. 67+75 TO STA. 68+25  
 PROJECT NAME BURLINGTON RIVERSIDE AVENUE  
 NO. MECG. 5000 (15) PLOTTED 12/07/90  
 SURVEYED BY CLD 10/89 - 8/90 BK 353, 354 & 355  
 SHEET 248 OF 252 SHEETS

SCALE 5 FEET