


DATE	
BY	
FINAL SURVEY	
PLOTTED	
TEMPERATURE	
NO. OF SHEETS	
AREAS CHECKED	

DATE	
BY	
ORIGINAL SURVEY	
PLOTTED	
TEMPERATURE	
NO. OF SHEETS	
AREAS CHECKED	

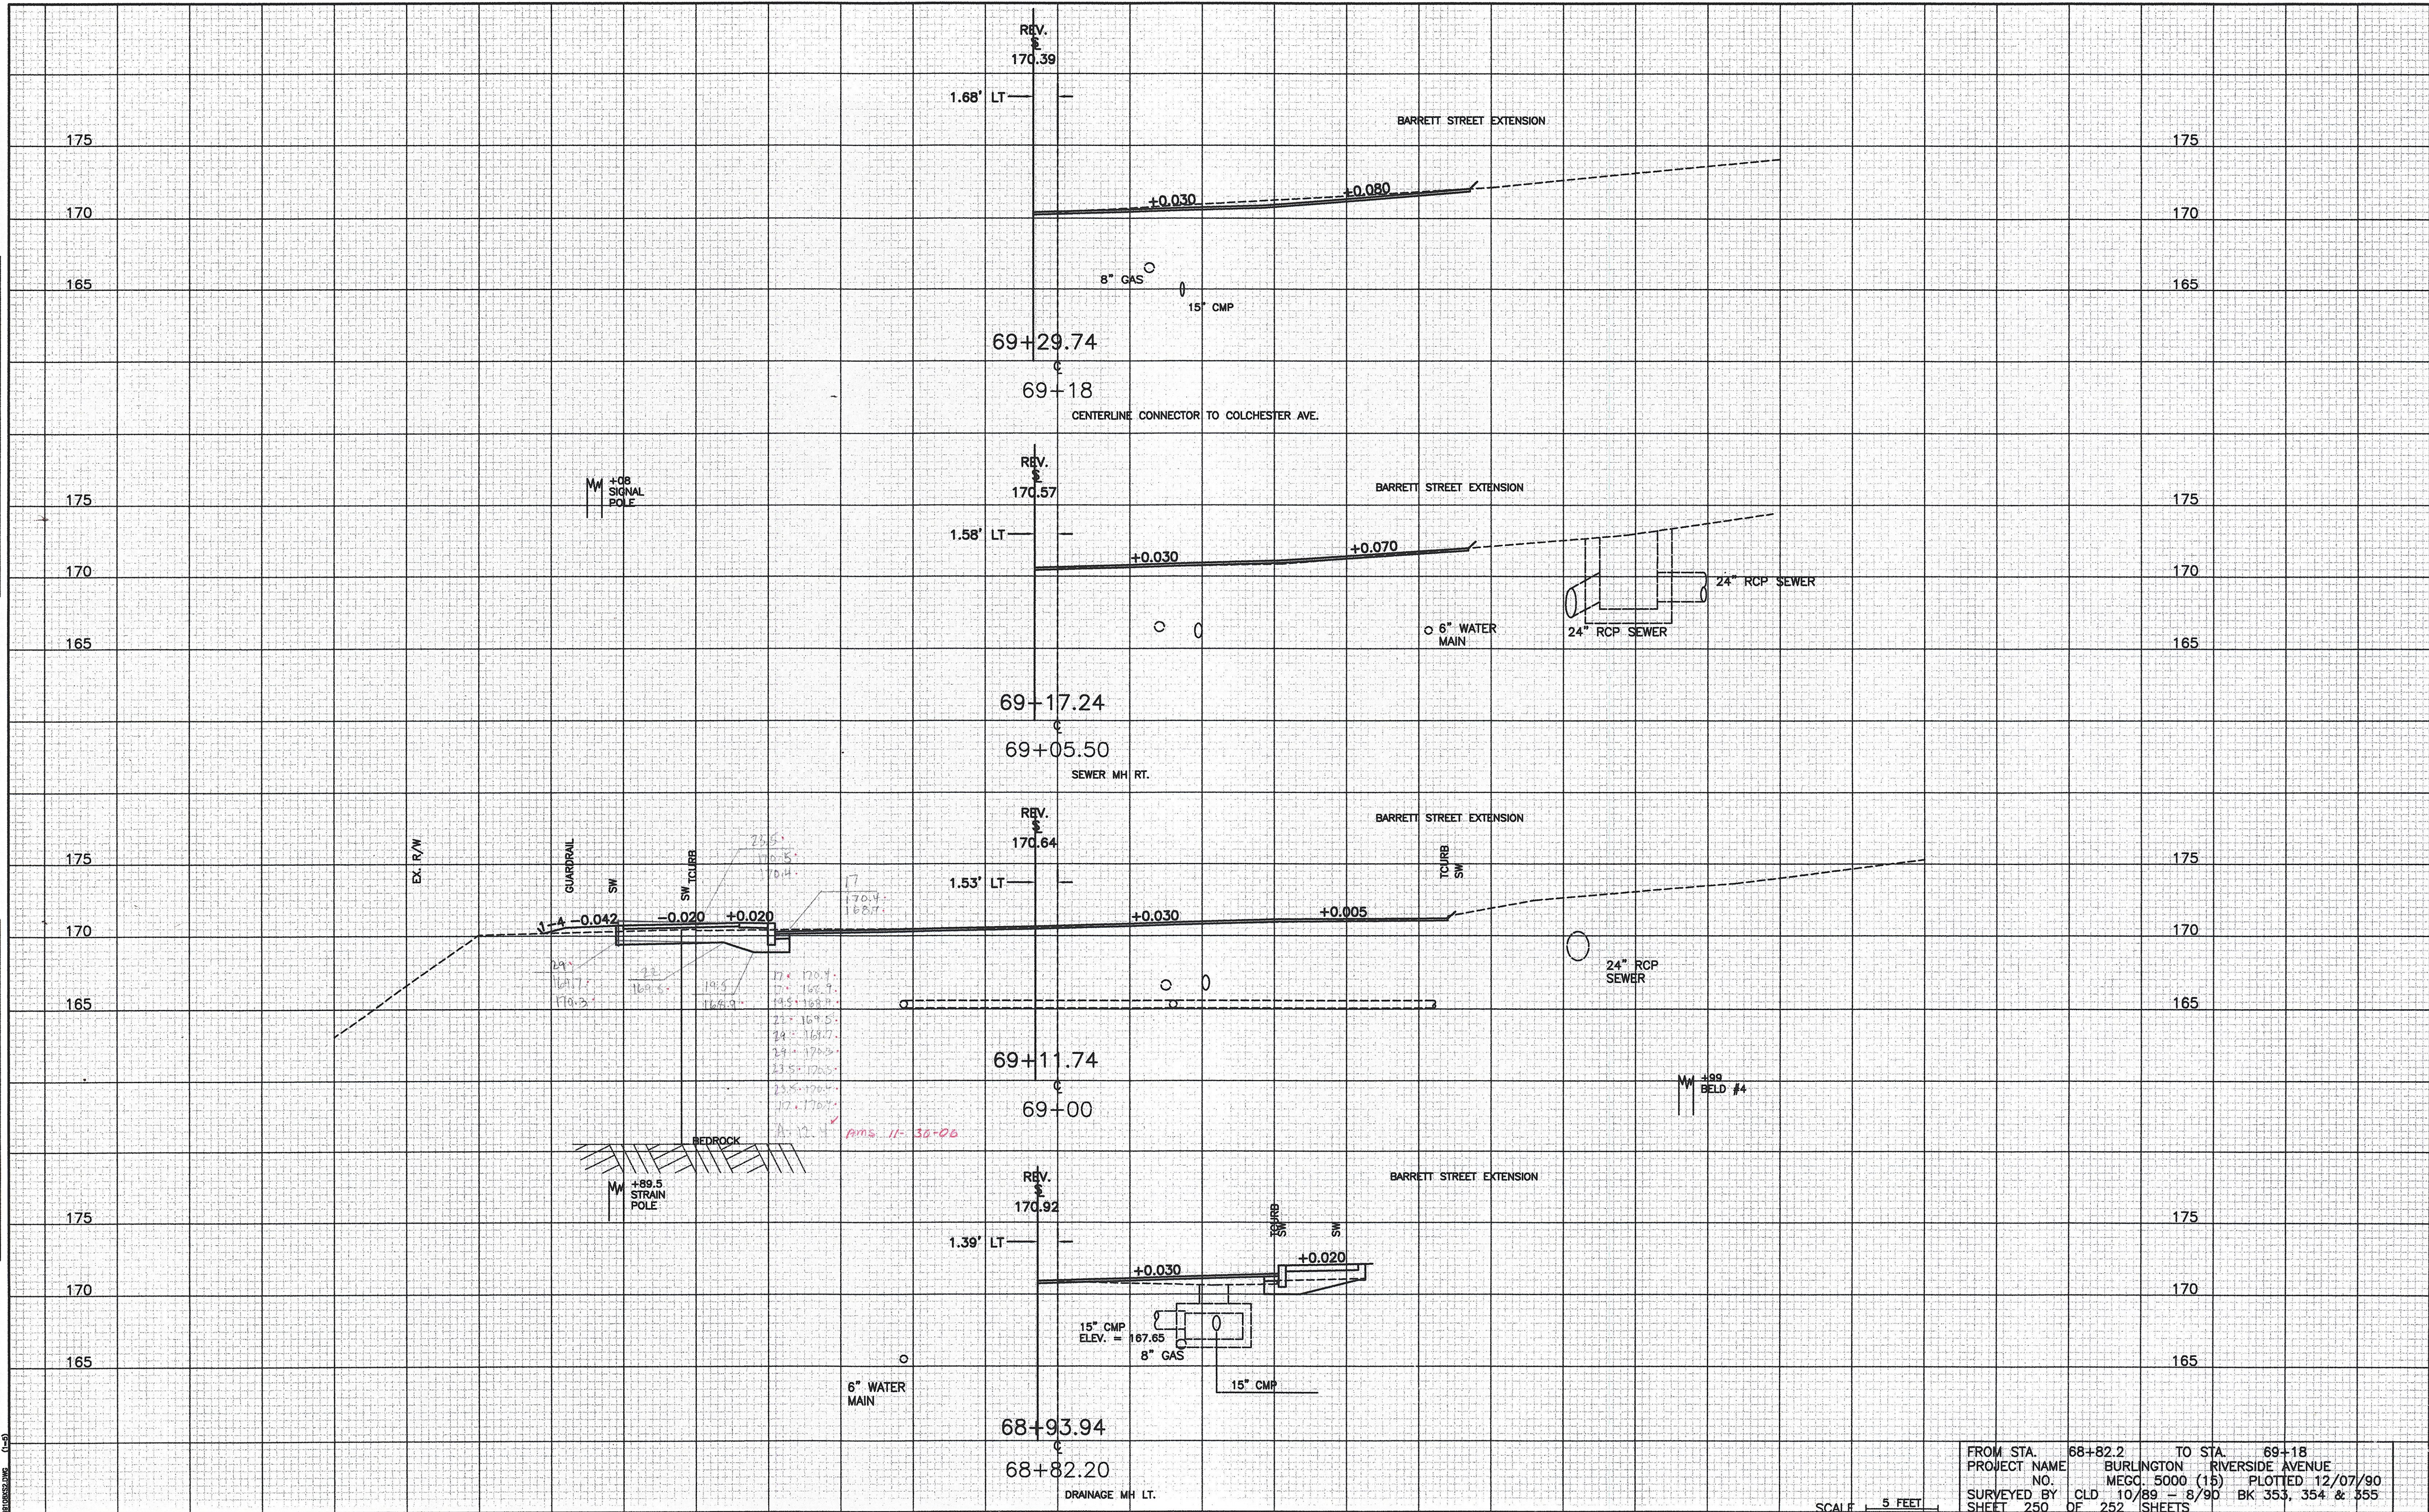

FROM STA.	68+82.2	TO STA.	69+18
PROJECT NAME	BURLINGTON RIVERSIDE AVENUE		
NO.	MEG. 5000 (15)		
SURVEYED BY	CLD	10/89 - 8/90	PLOTTED 12/07/90
SHEET	250	OF	252 SHEETS

SCALE 5 FEET

10/89