
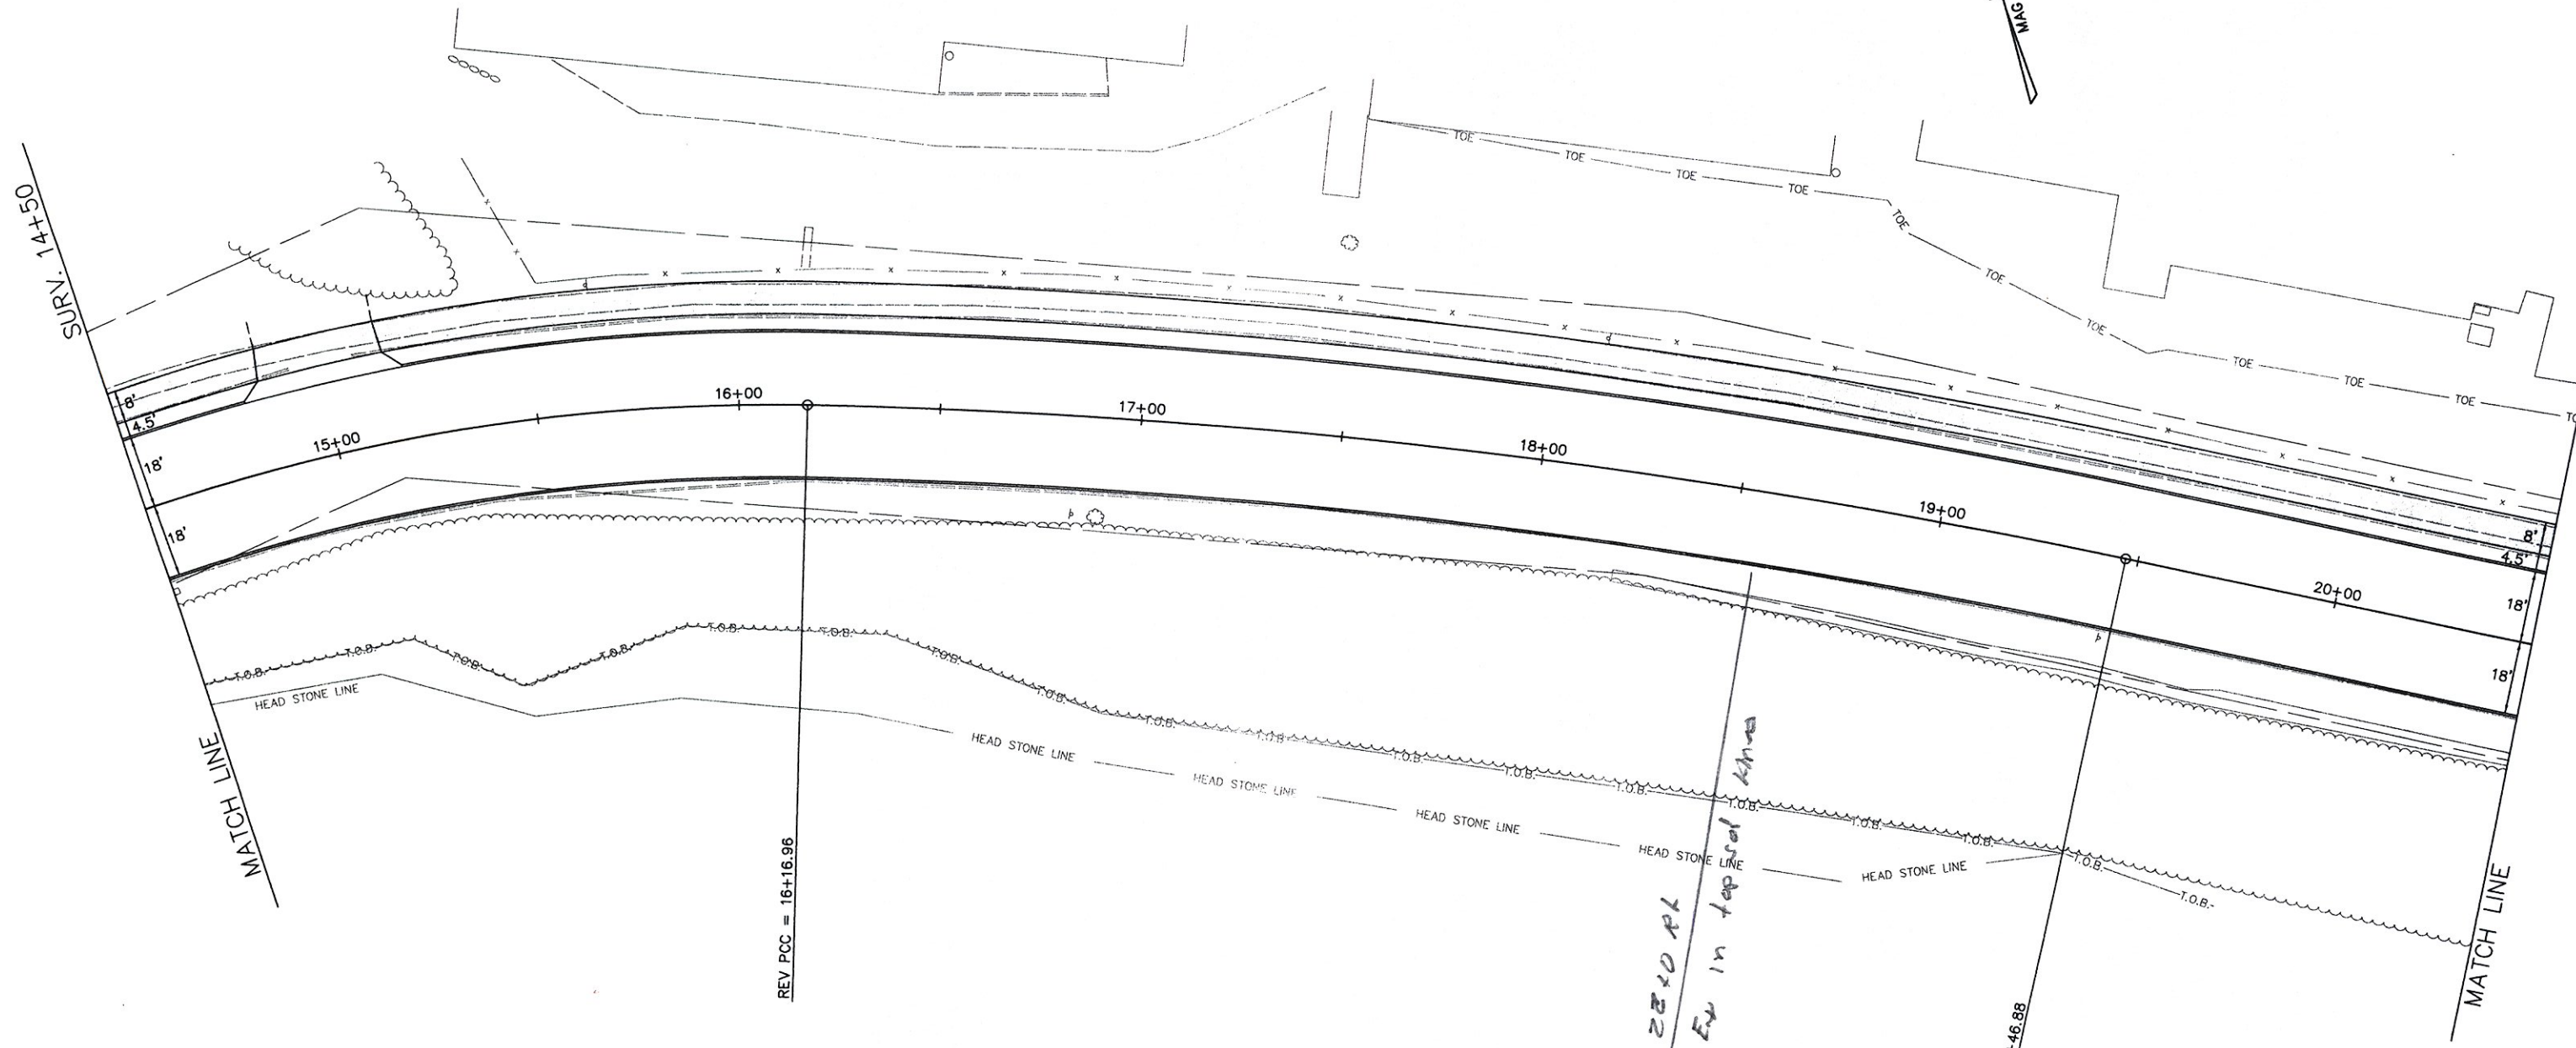


SURV. 14+50

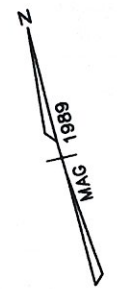

MATCH LINE

MATCH LINE


REV. PCC = 16+16.96

REV. PT = 19+46.88

*14+0 - 20+0 RL
Common Ew in top of lane*

*#
9A*

VIEW: CS2
DATUM
VERTICAL <u> </u> NGVD 1929
HORIZONTAL <u> </u> N/A

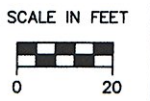

PAVEMENT LAYOUT

SURVEYED BY	<u>CLD</u>	DATE	<u> </u>
DRAWN BY	<u>TUS</u>	DATE	<u> </u>
SQUAD LEADER	<u>JAW</u>		
DESIGN FILE NO.	<u>89-108</u>		
IPARM FILE	<u> </u>	DATE PLOTTED	<u> </u>
PROJECT NAME:	<u>BURLINGTON</u>		
PROJECT NUMBER:	<u>MEGC 5000(15</u>		
SHEET	<u>73</u>	OF	<u>252</u> SHEETS