


VIEW CS3
DATUM
 VERTICAL NGVD 1929
 HORIZONTAL N/A

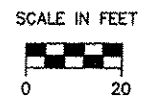

PAVEMENT LAYOUT		
SURVEYED BY	CLD	DATE
DRAWN BY	TJS	DATE
SQUAD LEADER	JAW	
DESIGN FILE NO.	89-108	
IPARM FILE		DATE PLOTTED
PROJECT NAME:	BURLINGTON	
PROJECT NUMBER:	MEGC 5000(15)	
SHEET 74 OF 252 SHEETS		