

#3 24+37 - 25+75 Lt
Grove / For Outland

REV PC = 24+34.81

REV PT = 26+58.11

REV PC = 29+98.99

MATCH LINE

MATCH LINE

#16
24+52 - 24+63 13

#17
24+50 - 24+92


#18
25+00.5 - 25+38.5

#19
27+28 - 27+37 23'

#20
27+72 - 27+87 21.5'


#21
28+40 - 28+52.5 20'

#22
28+85 124'

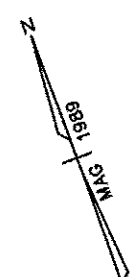

VIEW: CS4

DATUM	
VERTICAL	NGVD 1929
HORIZONTAL	N/A

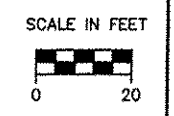

PAVEMENT LAYOUT

SURVEYED BY	CLD	DATE	
DRAWN BY	TUS	DATE	
SQUAD LEADER	JAW		
DESIGN FILE NO.	89-108		
IPARM FILE		DATE PLOTTED	
PROJECT NAME:	BURLINGTON		
PROJECT NUMBER:	MEGC 5000(15)		
SHEET 75 OF 252 SHEETS			