

SURV. 36+00

SURV. 41+50

MATCH LINE


MATCH LINE

REV PT = 37+17.36

REV PC = 40+40.96

NEW 628

DATUM	
VERTICAL	NGVD 1929
HORIZONTAL	N/A

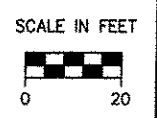

PAVEMENT LAYOUT	
SURVEYED BY	GLD
DRAWN BY	TUS
SQUAD LEADER	JAW
DESIGN FILE NO.	89-108
IPARM FILE	DATE PLOTTED
PROJECT NAME:	BURLINGTON
PROJECT NUMBER:	MEGC 5000(1)
SHEET	77 OF 252 SHEETS