

SURV. 53+50

MATCH LINE

REV PC = 53+54.76

54+00 +10.81

+26

55+00

56+00

57+00

58+00

+90 59+00

SURV. 59+50

MATCH LINE

REV PT = 55+56.96

PROPOSED SNOW FENCE (MOD)
(TO BE REMOVED ONCE
CONSTRUCTION IS COMPLETED)

REV PC = 58+37.98


#37 Curb west side of Drive 19'
#38 Curb on East Side of Drive 28.5'

1.40

31.00

VIEW: CSP

DATUM	
VERTICAL	NGVD 1929
HORIZONTAL	N/A

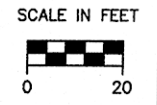

PAVEMENT LAYOUT	
SURVEYED BY	CLD DA
DRAWN BY	TUS DA
SQUAD LEADER	JAW
DESIGN FILE NO.	89-108
IPARM FILE	DATE PLOTTED
PROJECT NAME:	BURLINGTON
PROJECT NUMBER:	MEGC 5000(1
SHEET 80 OF 252 SHEETS	