
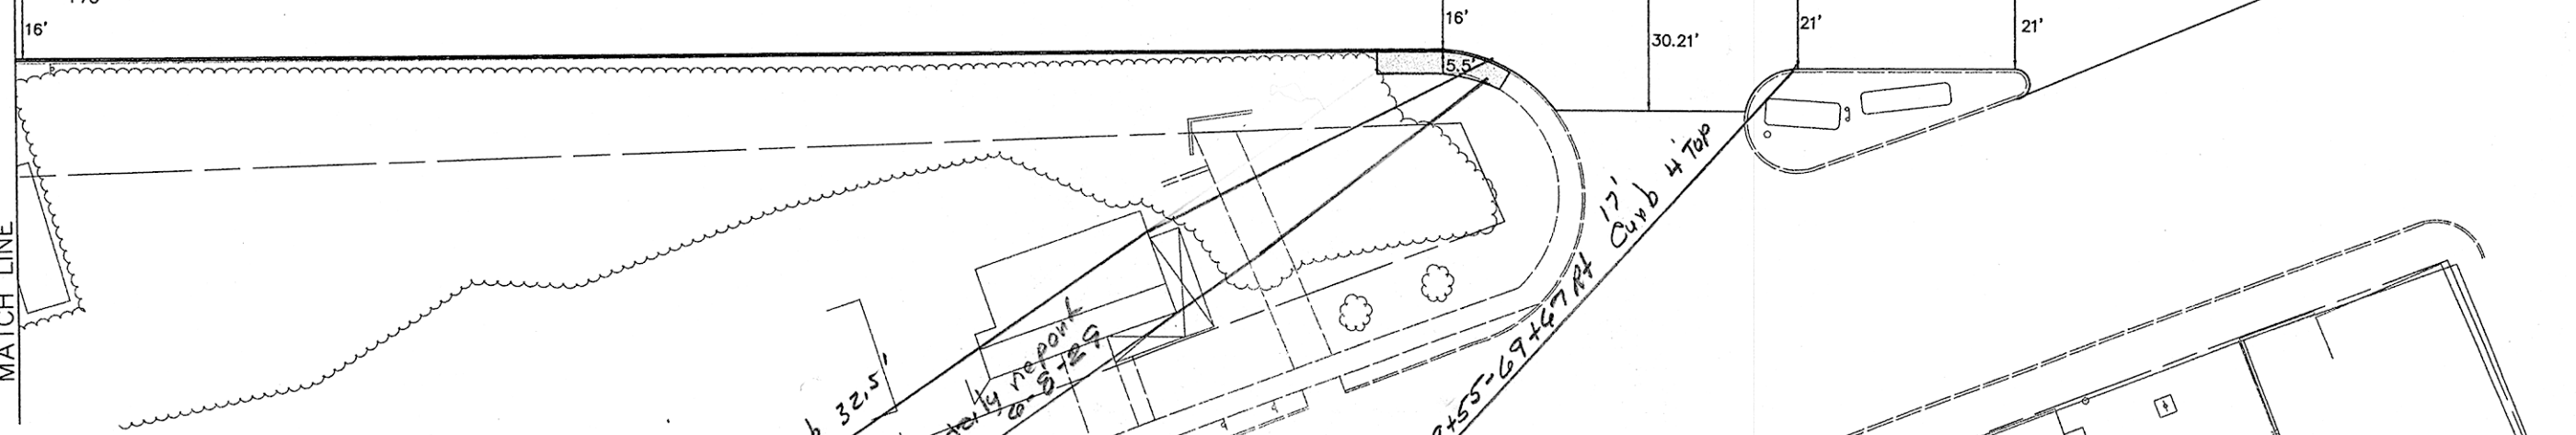


SURV. 65+50

MATCH LINE

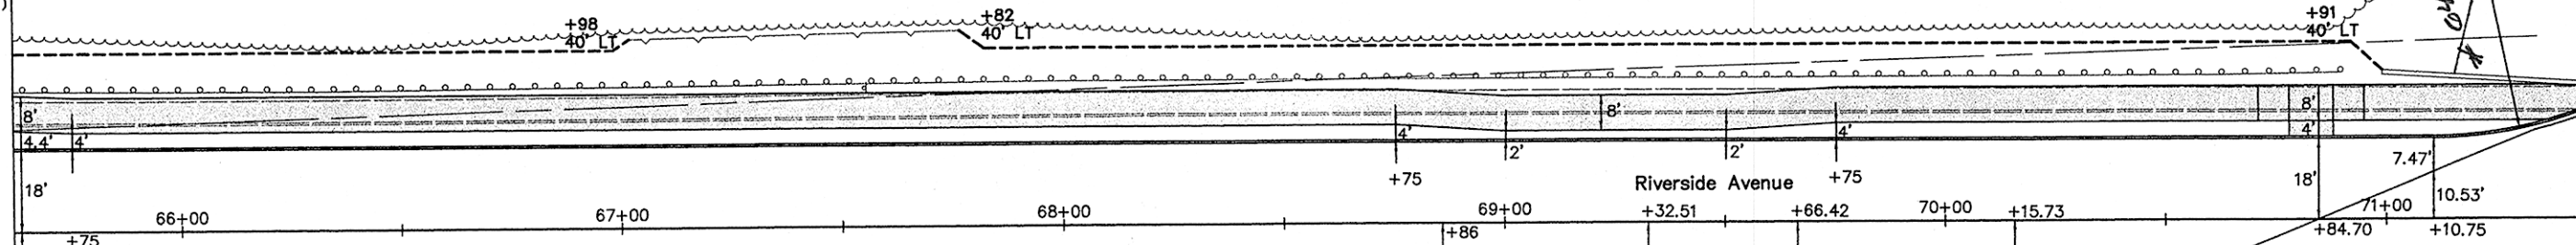

#42 68+97-69+11 Rt Curb 32.5'
 #43 68+92-69+02 Sidewalk
 #44 69+55-69+67 Rt 17' Curb 4' top

VIEW: CS11

| | |
|--------------|-----------|
| DATUM | |
| VERTICAL | NGVD 1929 |
| HORIZONTAL | N/A |



PAVEMENT LAYOUT

| | | | |
|------------------------|---------------|--------------|--|
| SURVEYED BY | CLD | DATE | |
| DRAWN BY | TUS | DATE | |
| SQUAD LEADER | JAW | | |
| DESIGN FILE NO. | 89-108 | | |
| IPARM FILE | | DATE PLOTTED | |
| PROJECT NAME: | BURLINGTON | | |
| PROJECT NUMBER: | MEGC 5000(15) | | |
| SHEET 82 OF 252 SHEETS | | | |

US 7 To Winoski

Mill Street

Barrett Street