


DESCRIPTION AND LOCATION

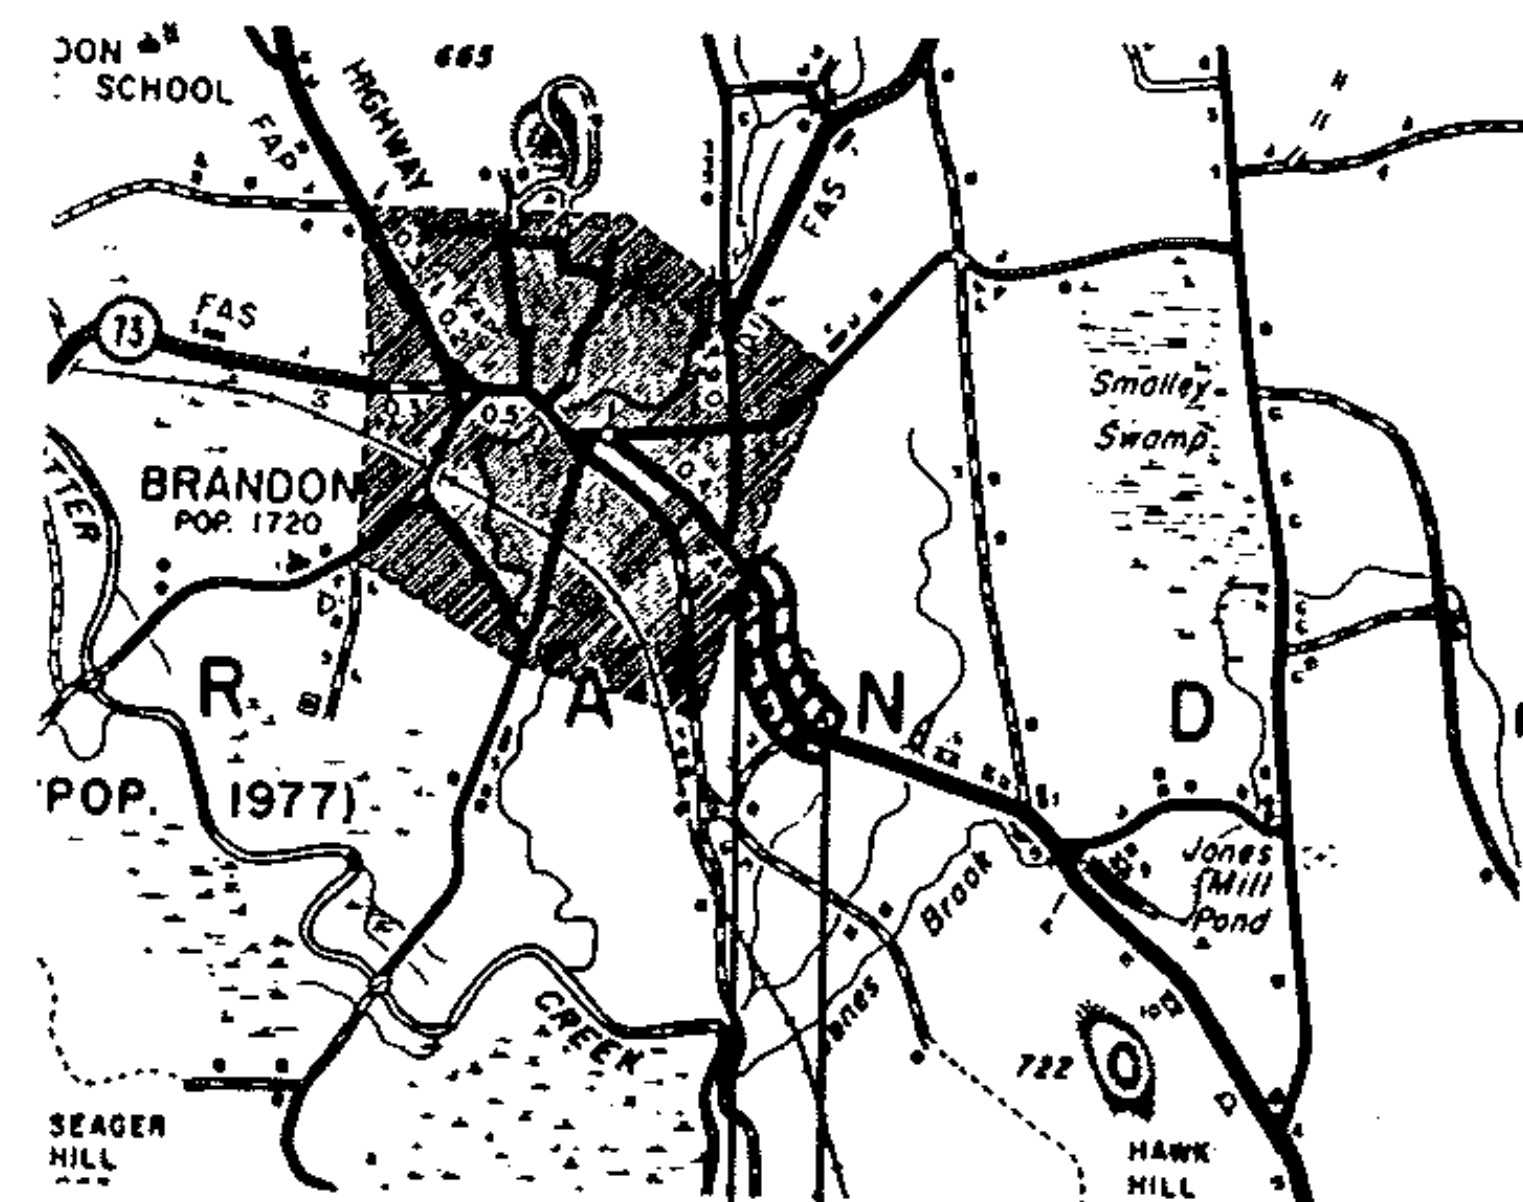

Scale: 1" = 1 mile

Begin Project HMA 2812
MM 2.807

End Project HMA 2812
MM 3.357

Beginning at a point on US 7, 2.807 miles northerly of the Pittsford - Brandon town line and extending 0.550 miles northerly to MM 3.357

Work consists of resurfacing of the highway, including shoulders and new pavement markings.

1986 ADT 6000

Length of Project 2904 feet
0.550 miles

PROJECT Brandon

NO. HMA 2812

SHEET 3 OF 7 SHEETS

SHEET 16 OF 75 SHEETS