


TYPICAL SECTIONS & DESIGN DATA

BITUMINOUS CONCRETE PAVEMENT
LEVELING COURSE TYPE IV (355 TONS/MILE)
AS DIRECTED BY THE ENGINEER.
1 1/4" WEARING COURSE TYPE III (±1/4" THICKNESS TOLERANCE)

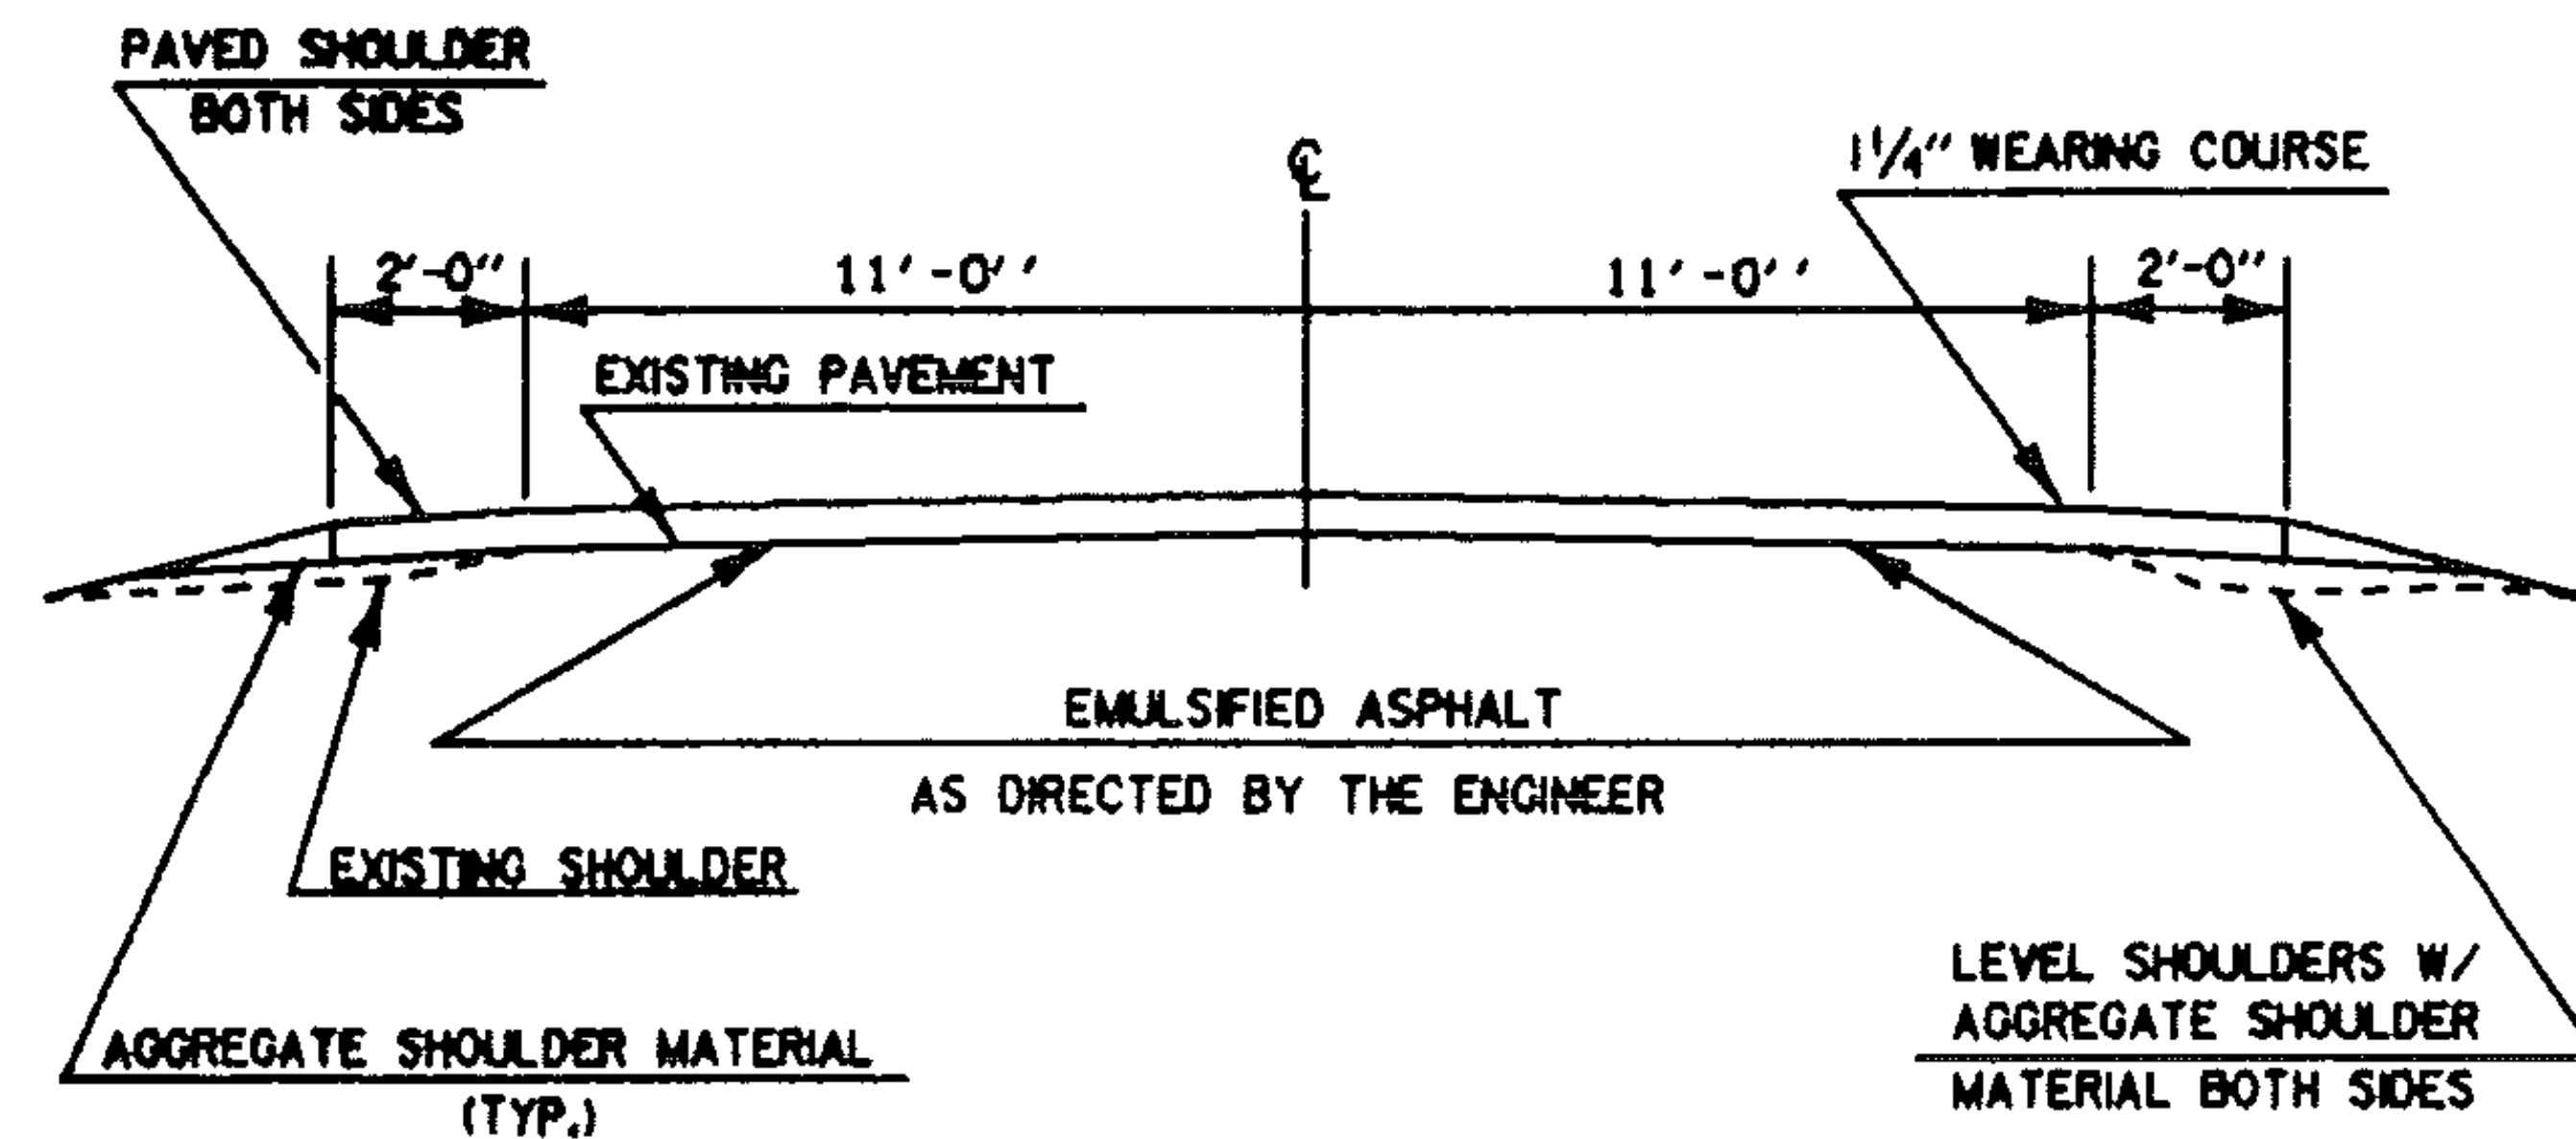

VT. 73 MM 3.600 ~ MM 5.853

NOTE : WHEN ENCOUNTERING VEGETATION OR POOR MATERIAL IN THE SHOULDER AREA, REMOVE 2" BELOW EXISTING PAVEMENT LEVEL AND REPLACE WITH AGGREGATE SHOULDER MATERIAL. REMOVAL OF THIS MATERIAL WILL BE PAID FOR UNDER THE ITEM 'ALL PURPOSE EXCAVATOR RENTAL' OR 'GRADER RENTAL'.

PROJECT BRANDON

NO. HMA 2853
SHEET 4 OF 7 SHEETS
SHEET 31 OF 75 SHEETS