



TYPICAL SECTIONS & DESIGN DATA

BITUMINOUS CONCRETE PAVEMENT
LEVELING COURSE TYPE IV (273# & 341# TONS/MILE)
AS DIRECTED BY THE ENGINEER.
1 1/4" WEARING COURSE TYPE III (±1/4" THICKNESS TOLERANCE)

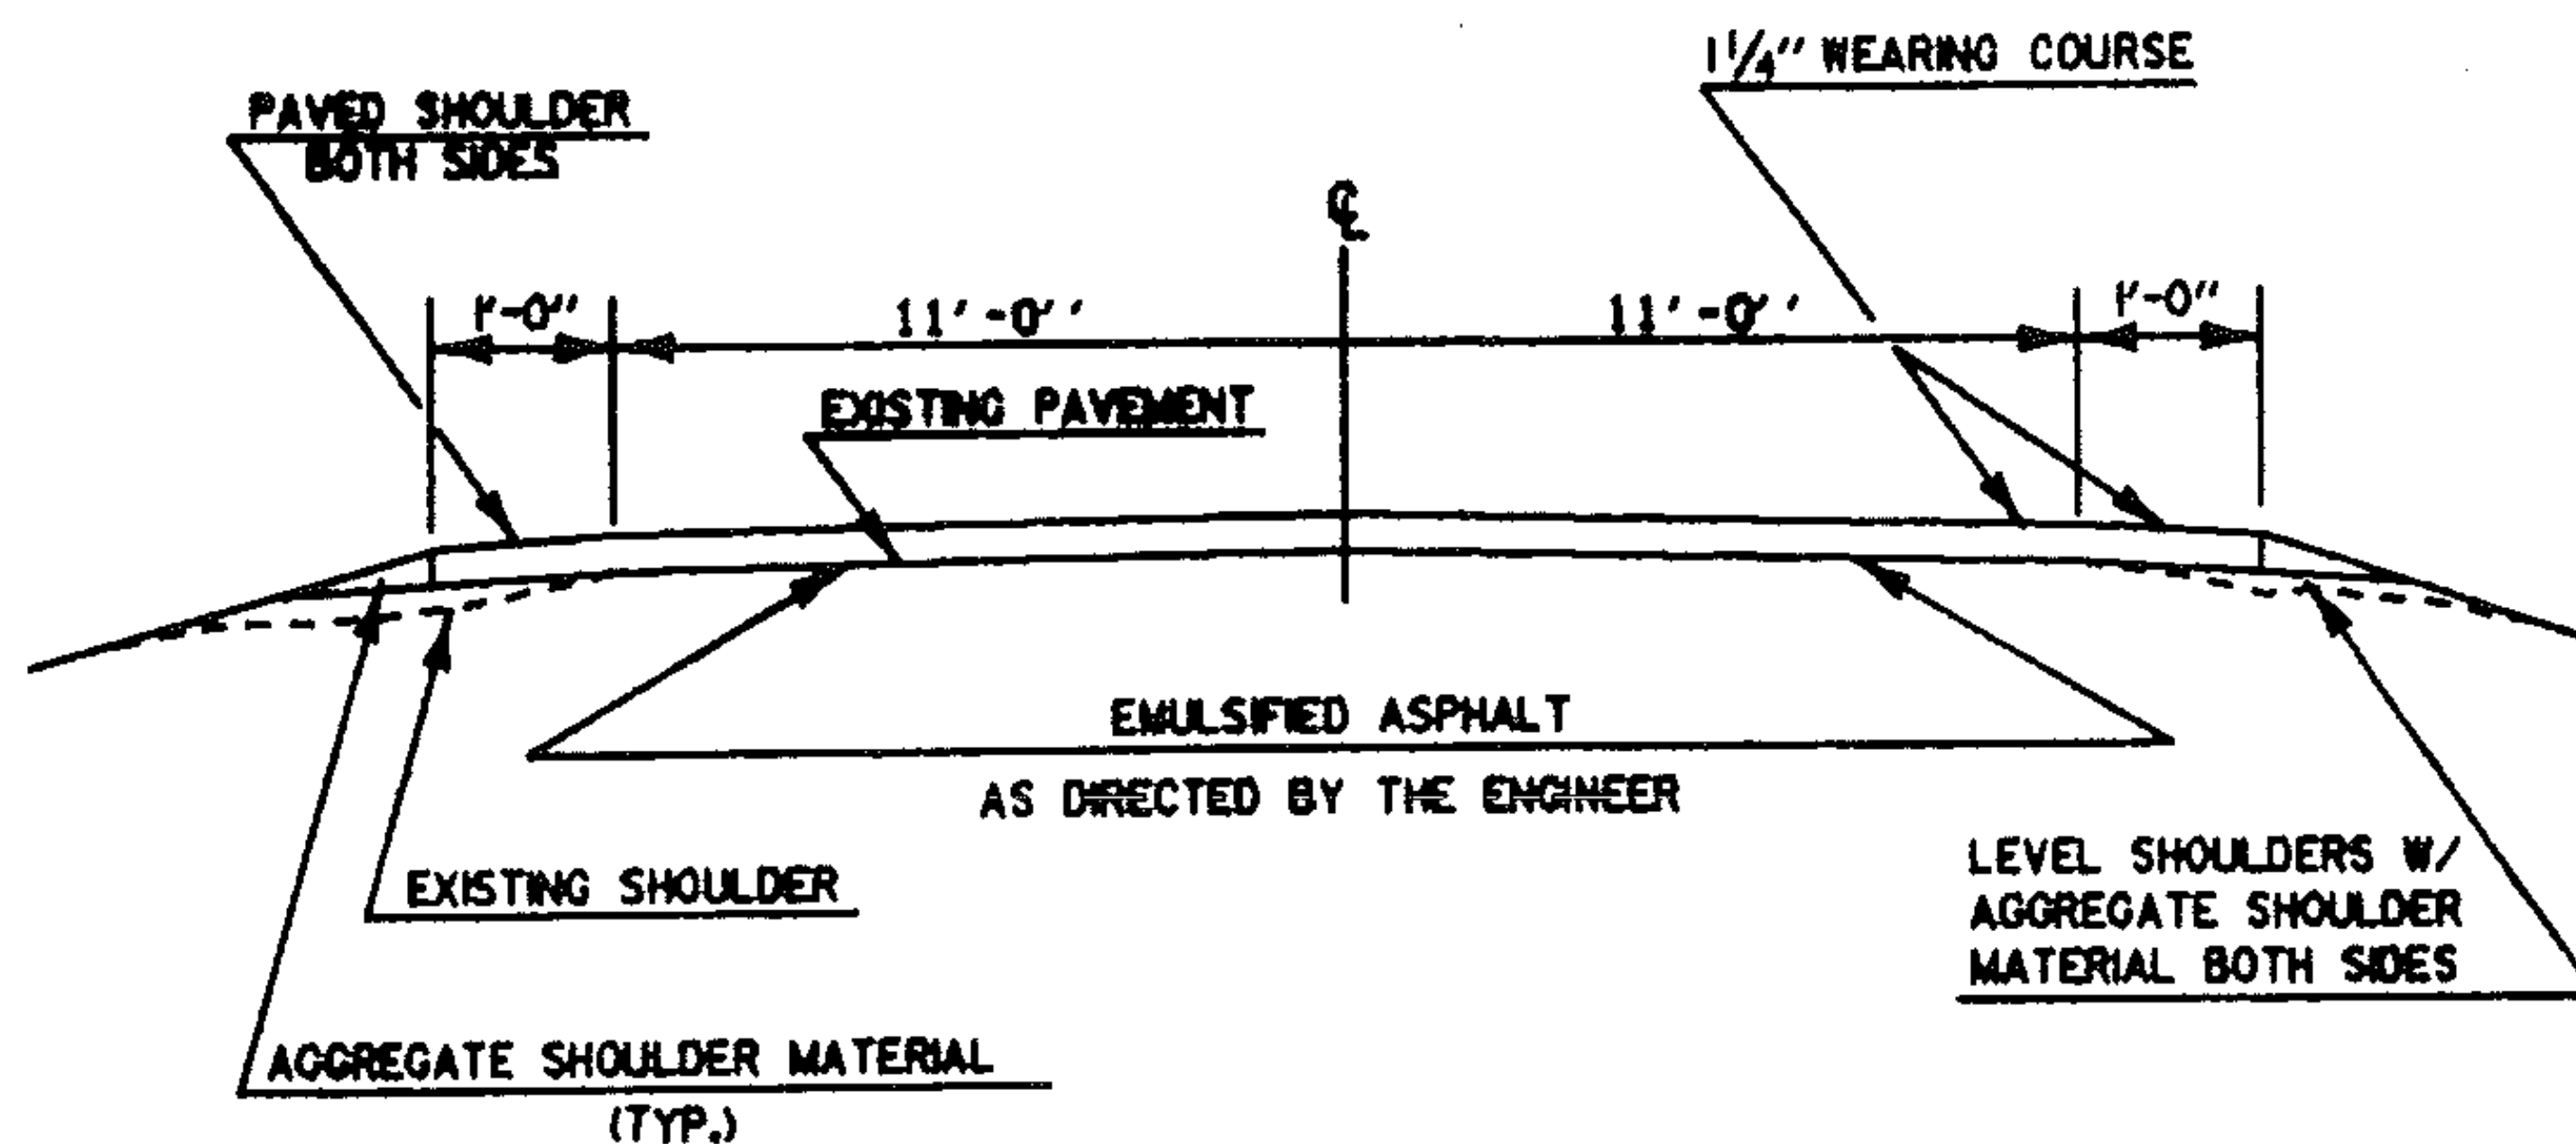

VT.125 MM 0.337 ~ MM 1.014*

NOTE : WHEN ENCOUNTERING VEGETATION OR POOR MATERIAL IN THE SHOULDER AREA, REMOVE 2" BELOW EXISTING PAVEMENT LEVEL AND REPLACE WITH AGGREGATE SHOULDER MATERIAL. REMOVAL OF THIS MATERIAL WILL BE PAID FOR UNDER THE ITEM 'ALL PURPOSE EXCAVATOR RENTAL' OR 'GRADER RENTAL'.

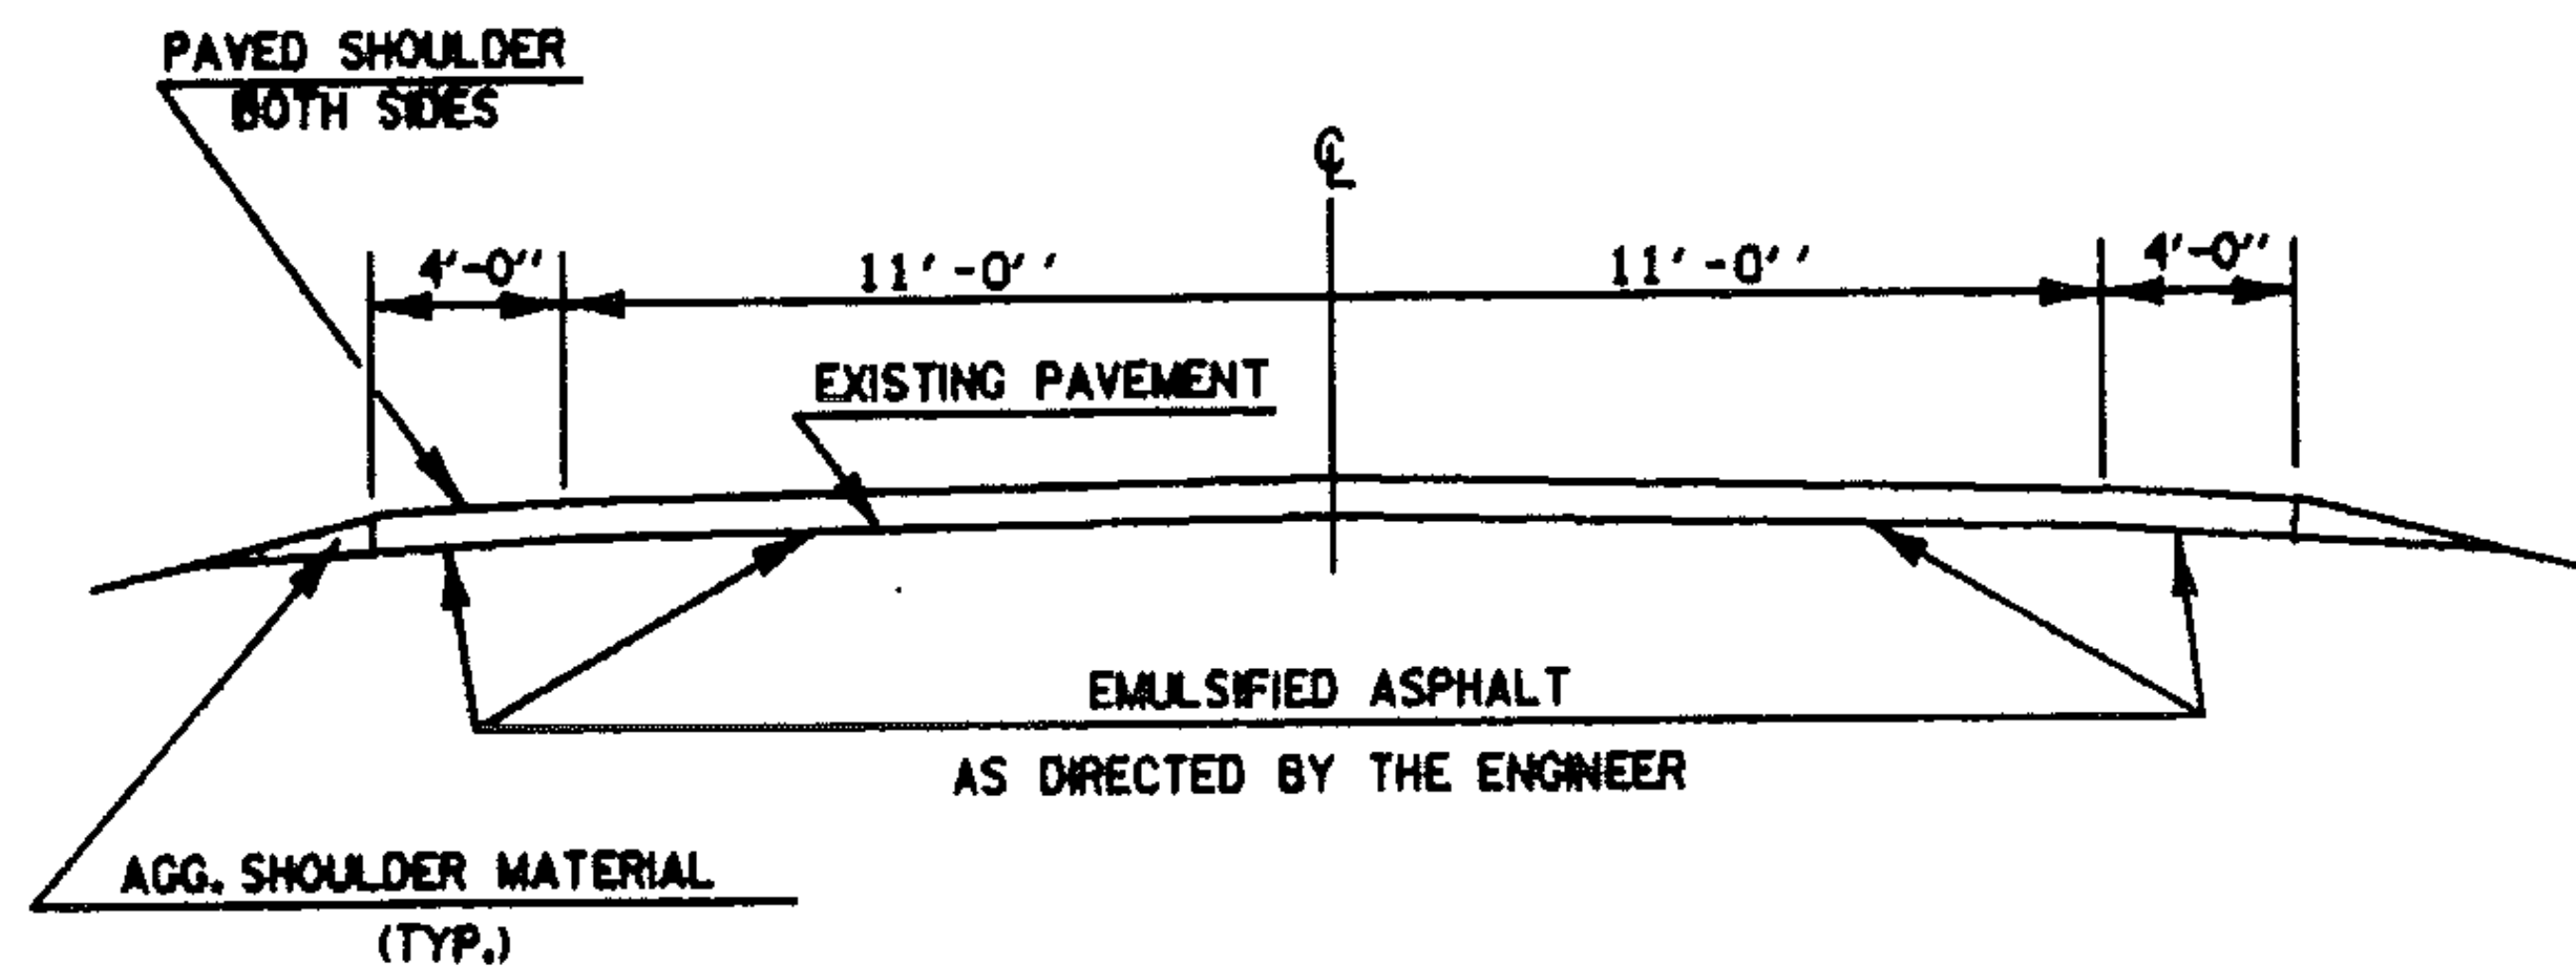

VT.125 MM 1.014 ~ MM 1.164**

PROJECT RIPTON

NO. HMA 2864
 SHEET 5 OF 8 SHEETS
 SHEET 53 OF 75 SHEETS