


| DESCRIPTION AND LOCATION |     |
|--------------------------|-----|
| 1                        | ... |
| 2                        | ... |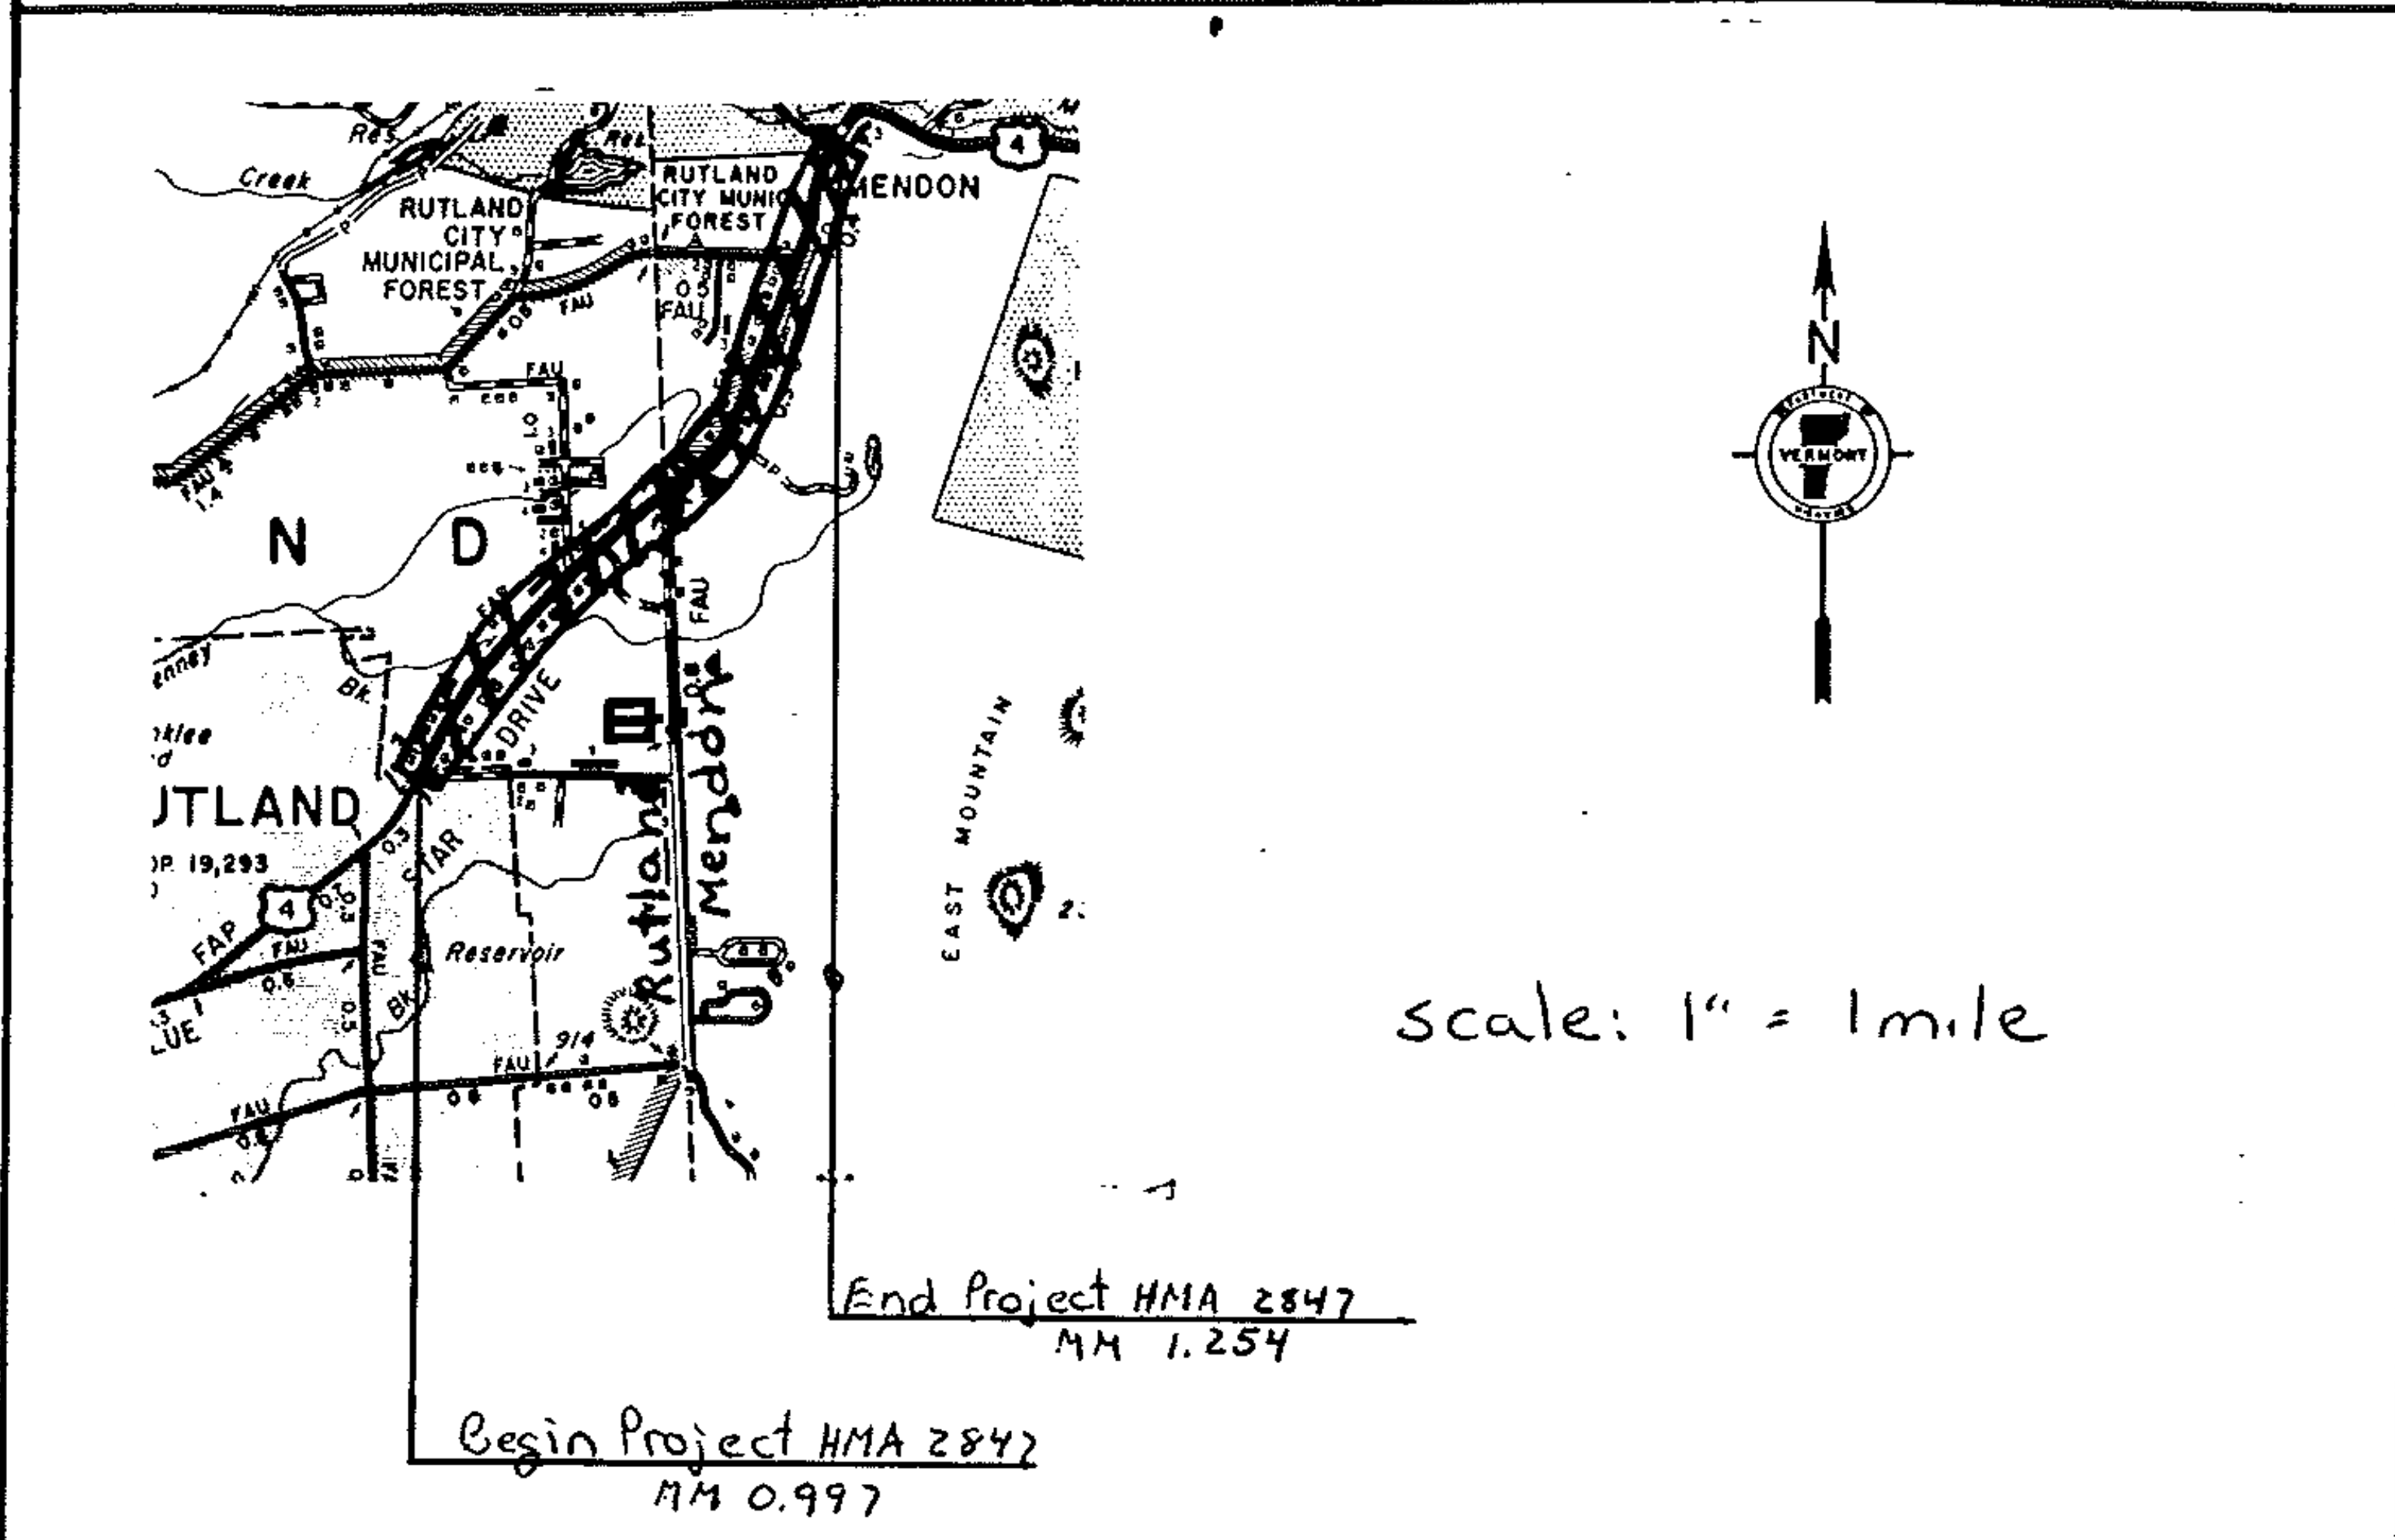
End Project HMA 2847  
MM 1.254

Work consists of resurfacing of the highway, including shoulders and new pavement markings

Length of Project 2.488 miles  
13130 feet

NO. HMA 2847

SHEET 59 OF 75 SHEETS