


NOTE: ALL MARKINGS DETAILED ON THIS SHEET
ARE DURABLE EXCEPT EDGE LINES
FOR MORE DETAILS SEE SHEET 11 OF 12
AND STANDARD E-50

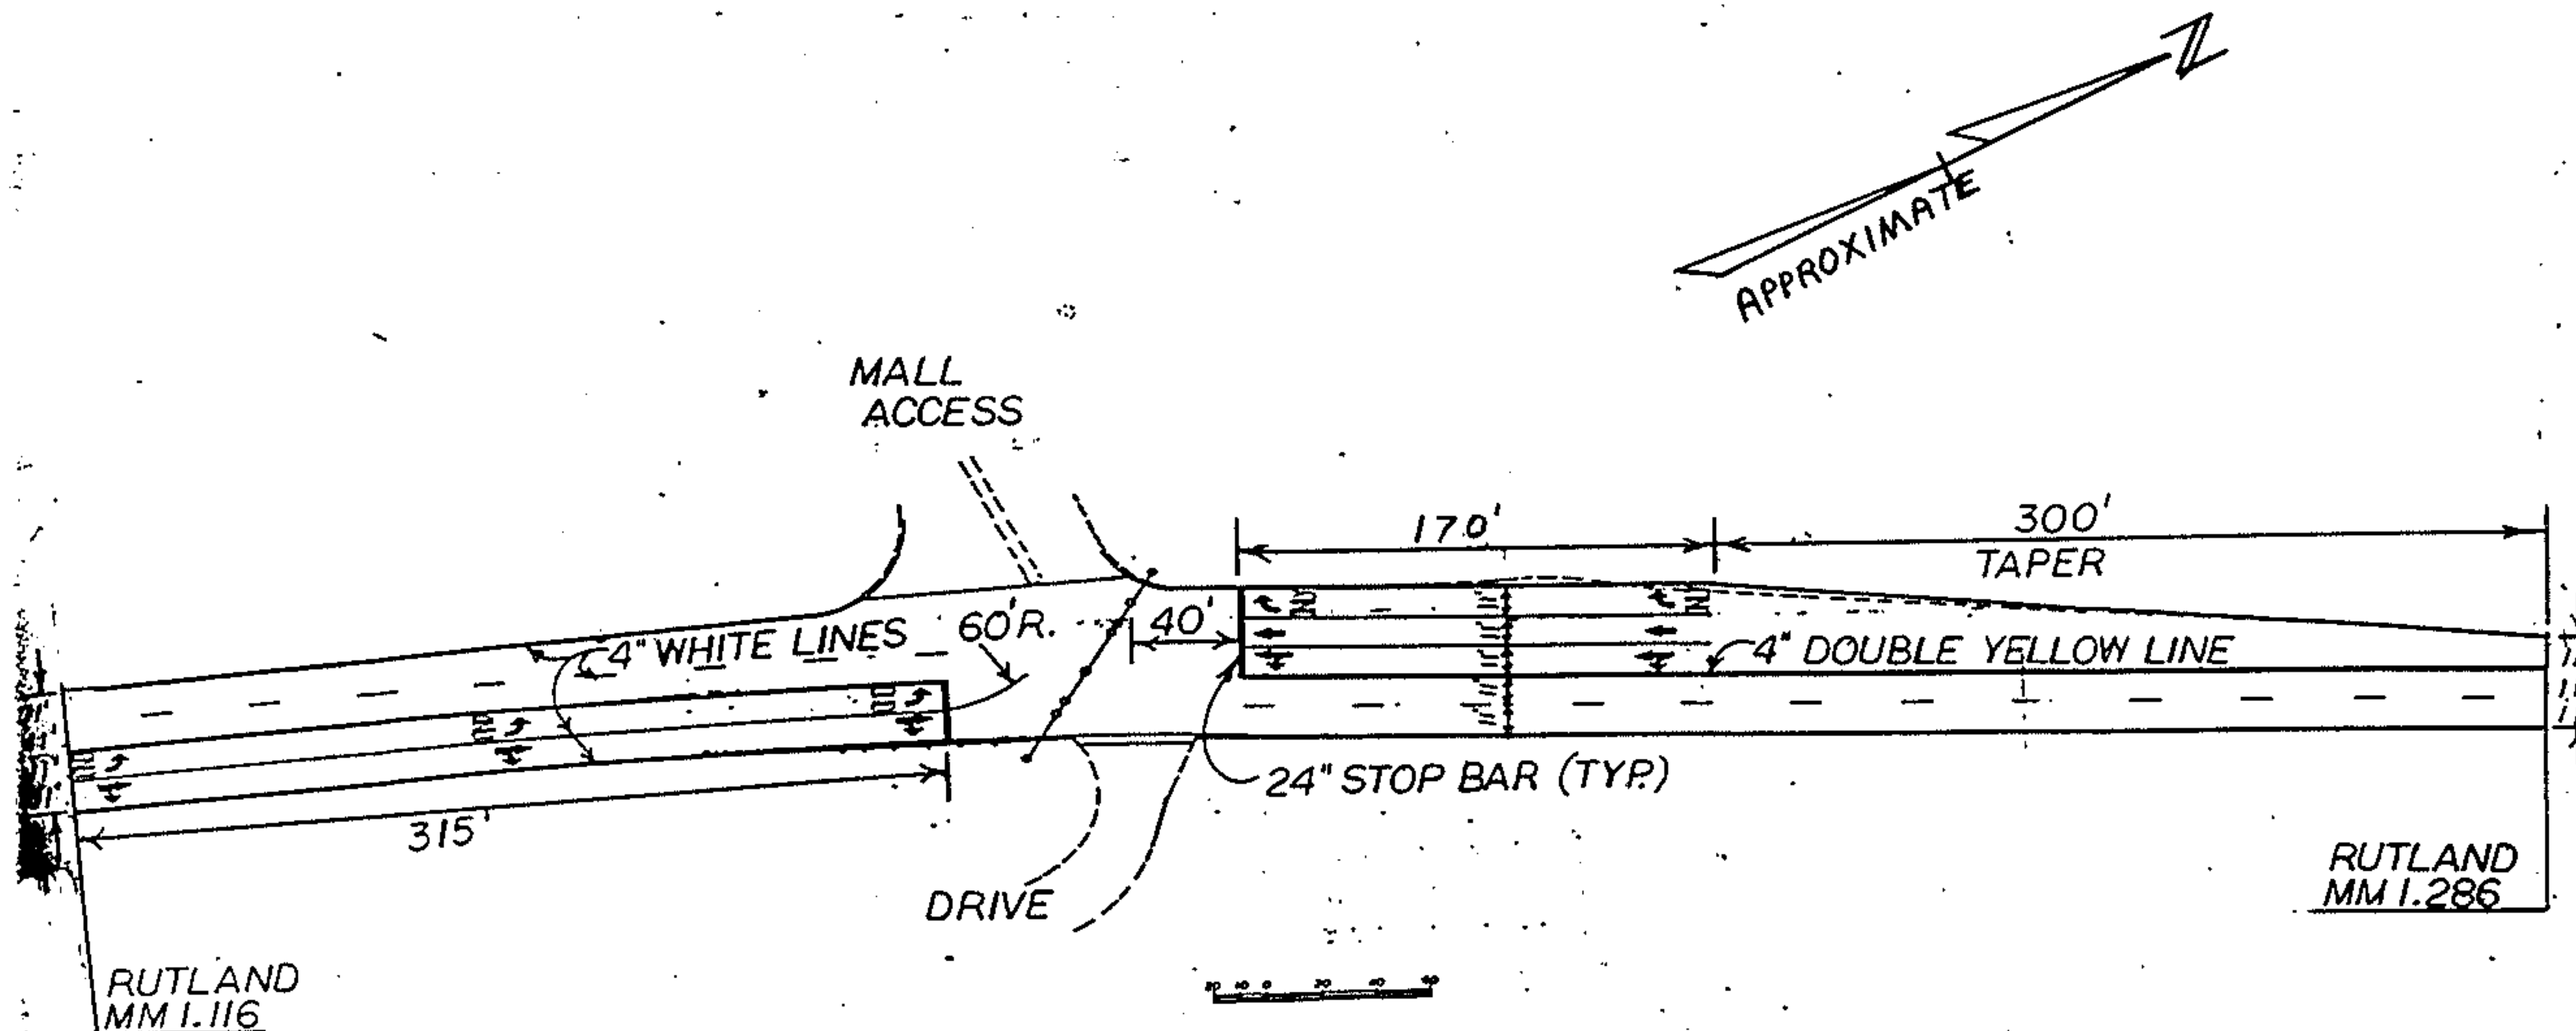

RUTLAND-MENDON
U.S. RTE. 4
HMA 2847

SHT 12 OF 12
SHT 63 OF 75