


TYPICAL SECTIONS & DESIGN DATA

ITEM 406.25 BITUMINOUS CONCRETE PAVEMENT
 AGGREGATE SHOULDERS ($\pm 1/2"$)
 LEVELING COURSE TYPE IV (295 TONS/MILE)
 1 1/4" WEARING COURSE TYPE III ($\pm 1/4"$)
 AS DIRECTED BY THE ENGINEER
 VT 36 FAIRFIELD MM 7.958 ~ MM 9.444

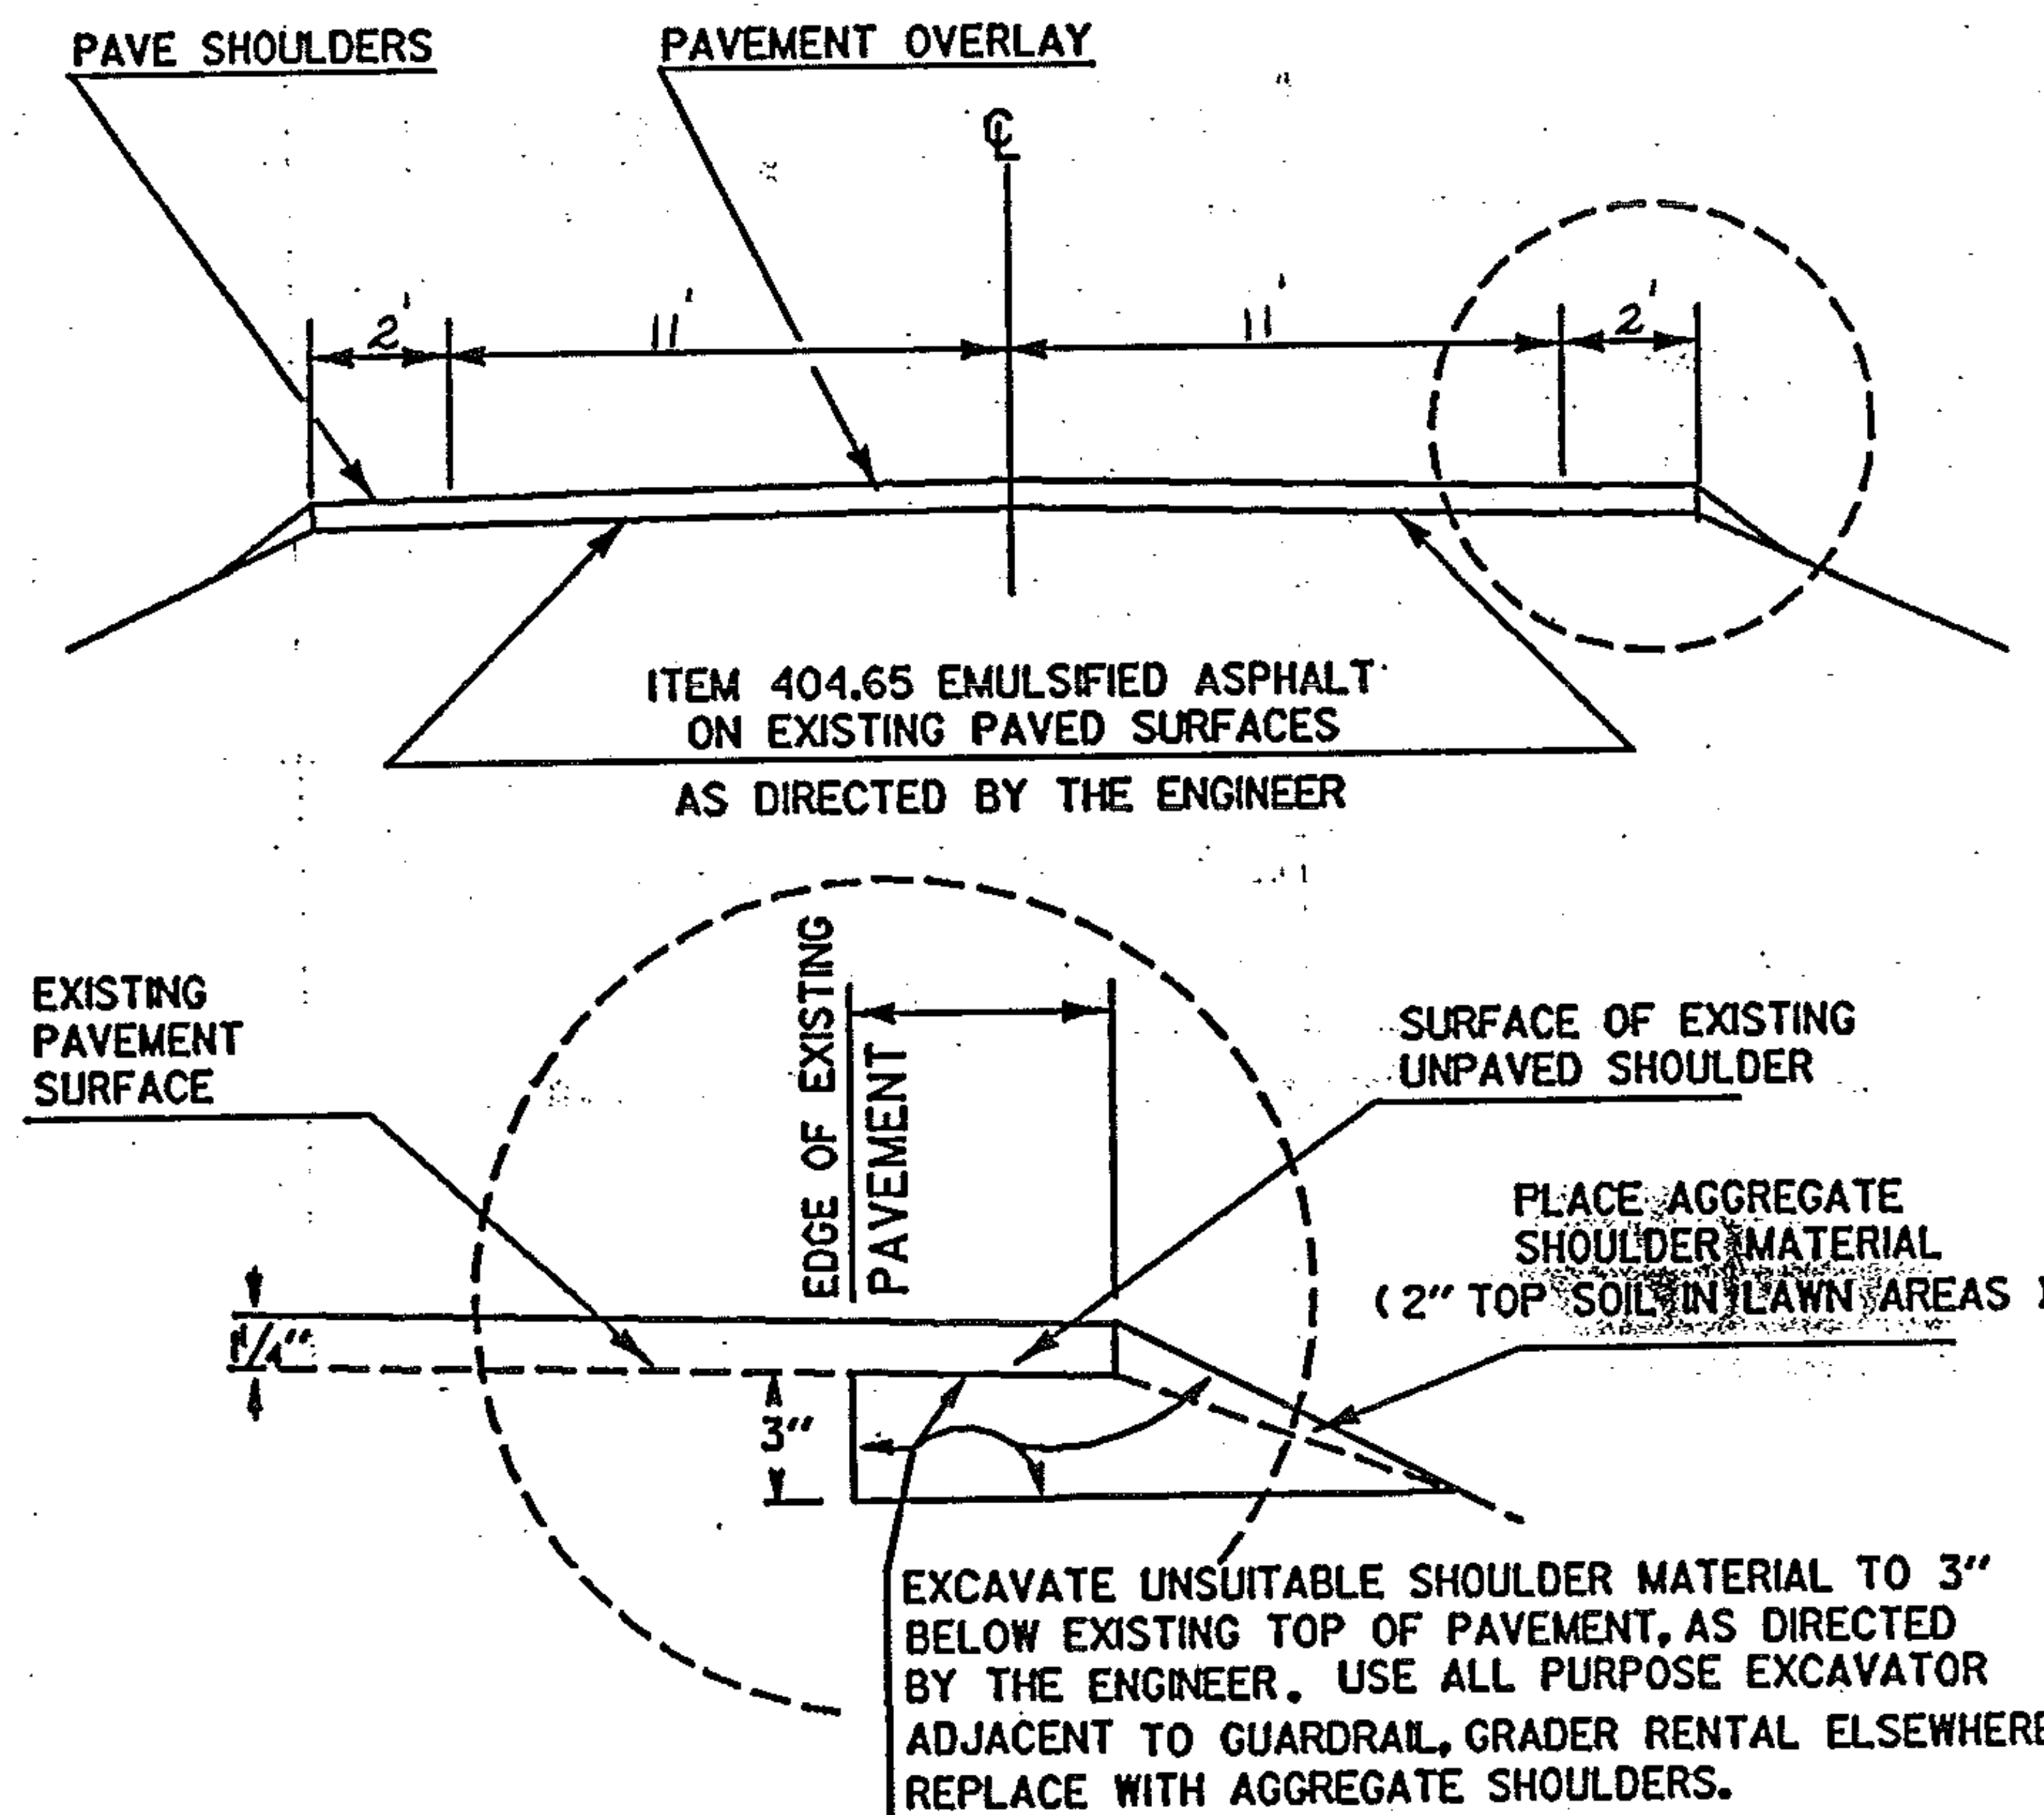

PROJECT FAIRFIELD - BAKERSFIELD

NO. HMA 2866

SHEET 42 OF 60 SHEETS