


DESCRIPTION AND LOCATION

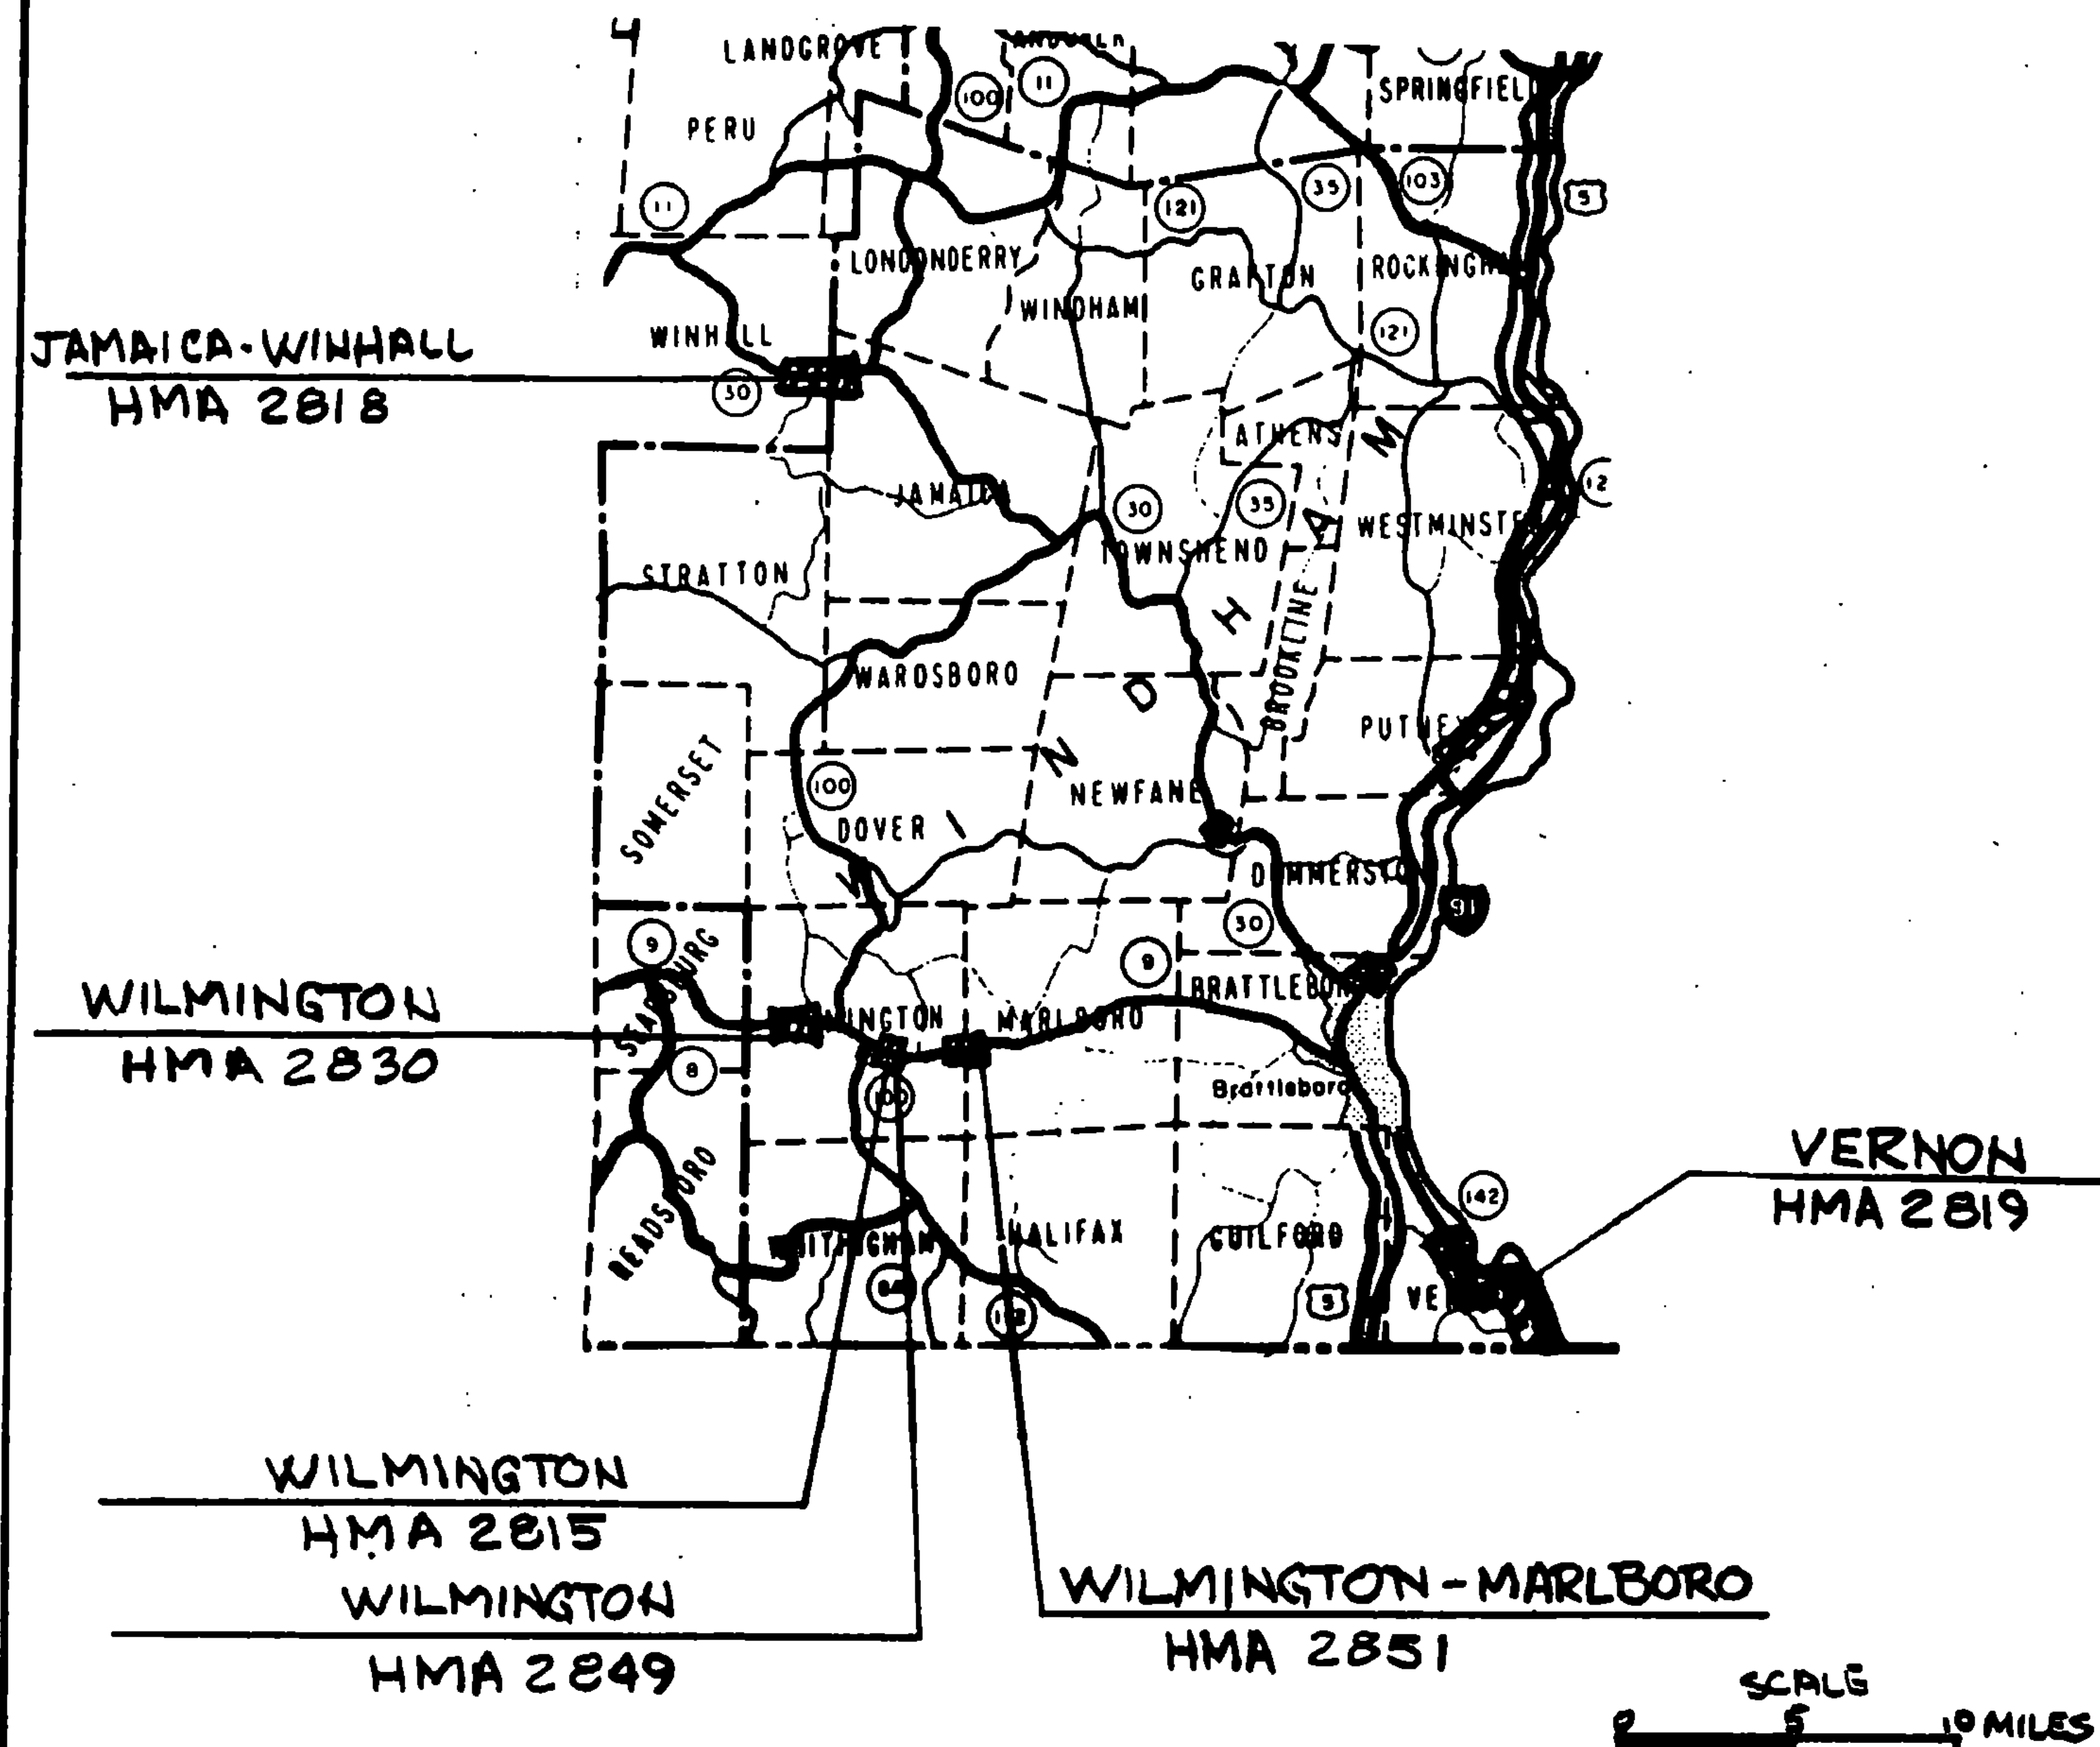

OVERLAY						
PROJECT	DEPTH	BEGIN	END	LENGTH (FT)	LENGTH (MI)	
JAMAICA-WINHALL HMA 2818	1 1/4"	JAMAICA 2.825	WINHALL 2.096	16030.080	3.036	
VERNON HMA 2819	1 1/4"	0.000	6.800	35904.000	6.800	
WILMINGTON HMA 2830	1 1/4"	1.270	1.978	3738.24	0.708	
WILMINGTON HMA 2815	1 1/4"	4.283	4.500	1145.76	0.217	
WILMINGTON HMA 2849	1 1/4"	4.500	5.157	3468.960	0.657	
WILMINGTON-MARLBORO HMA 2851	1 1/4"	WILMINGTON 7.118	MARLBORO 6.870	3315.840	0.628	
TOTALS				63,602.88	12.046	

PROJECT 1987 DIST. 2 PAVING

NO. HMA PAVING

SHEET 3 OF 64 SHEETS