


TYPICAL SECTIONS & DESIGN DATA

WINHALL MM0.538~MM2.096
ITEM 406.25 BITUMINOUS CONCRETE PAVEMENT
LEVELING COURSE TYPE IV (250 TONS/MILE)
1/4" WEARING COURSE TYPE III ($\pm 1/4"$)
AS DIRECTED BY THE ENGINEER

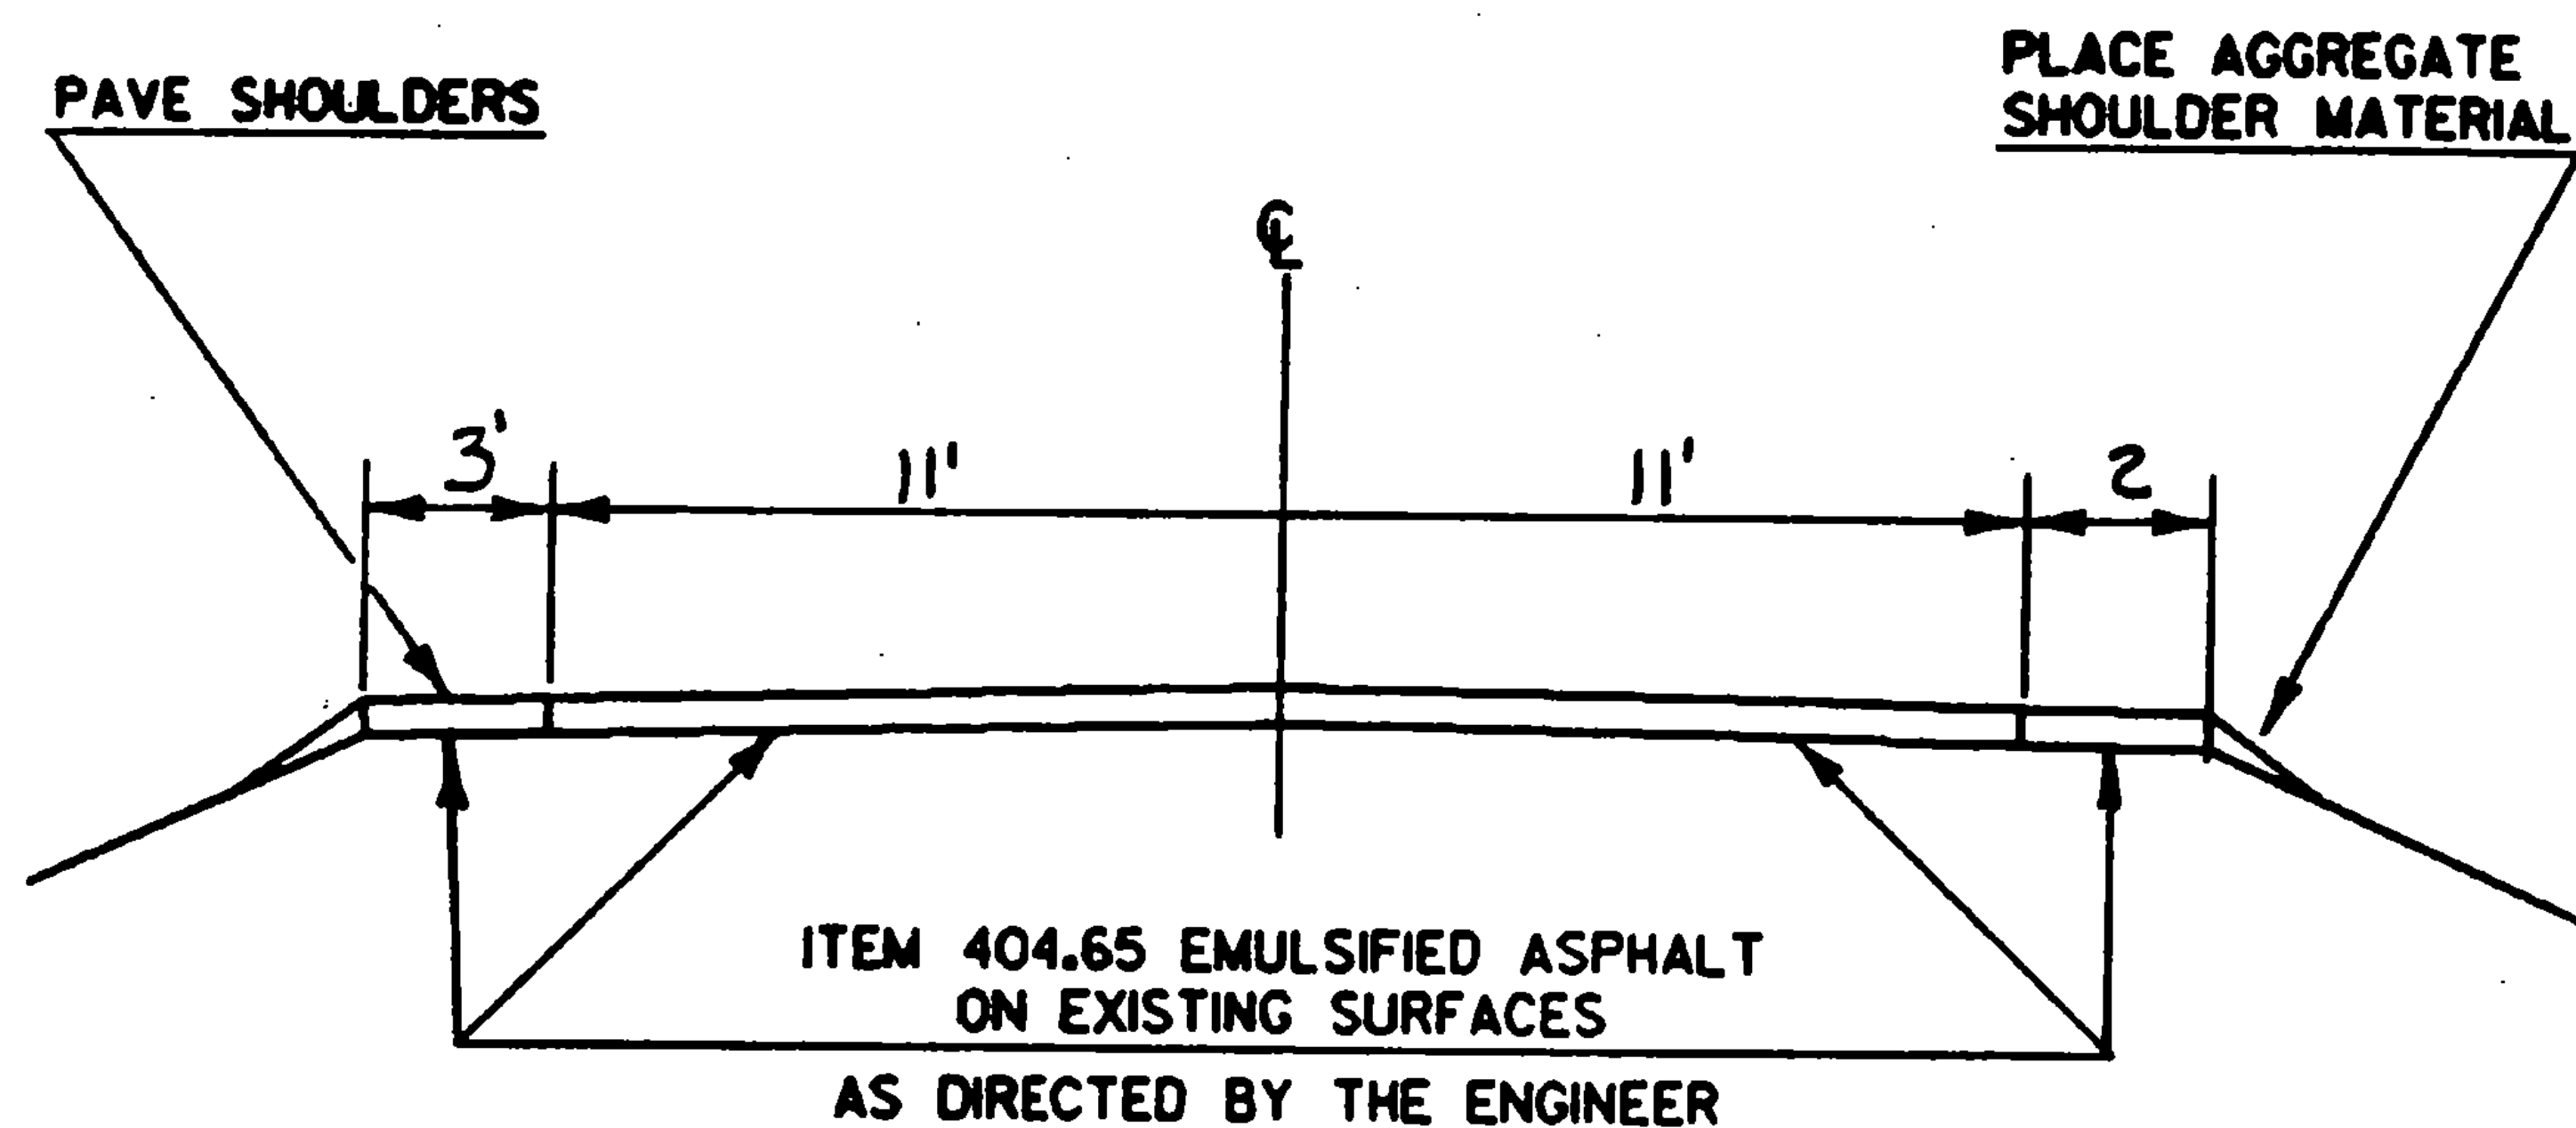

PROJECT JAMAICA-WINHALL

NO. HMA 2818
SHEET 15 OF 64 SHEETS
SHEET 7 OF 10 SHEETS