



TYPICAL SECTIONS & DESIGN DATA

WATERFORD-ST. JOHNSBURY
HARDWICK-WALDEN
MORRISTOWN

HMA 2842
HMA 2820
HMA 2817

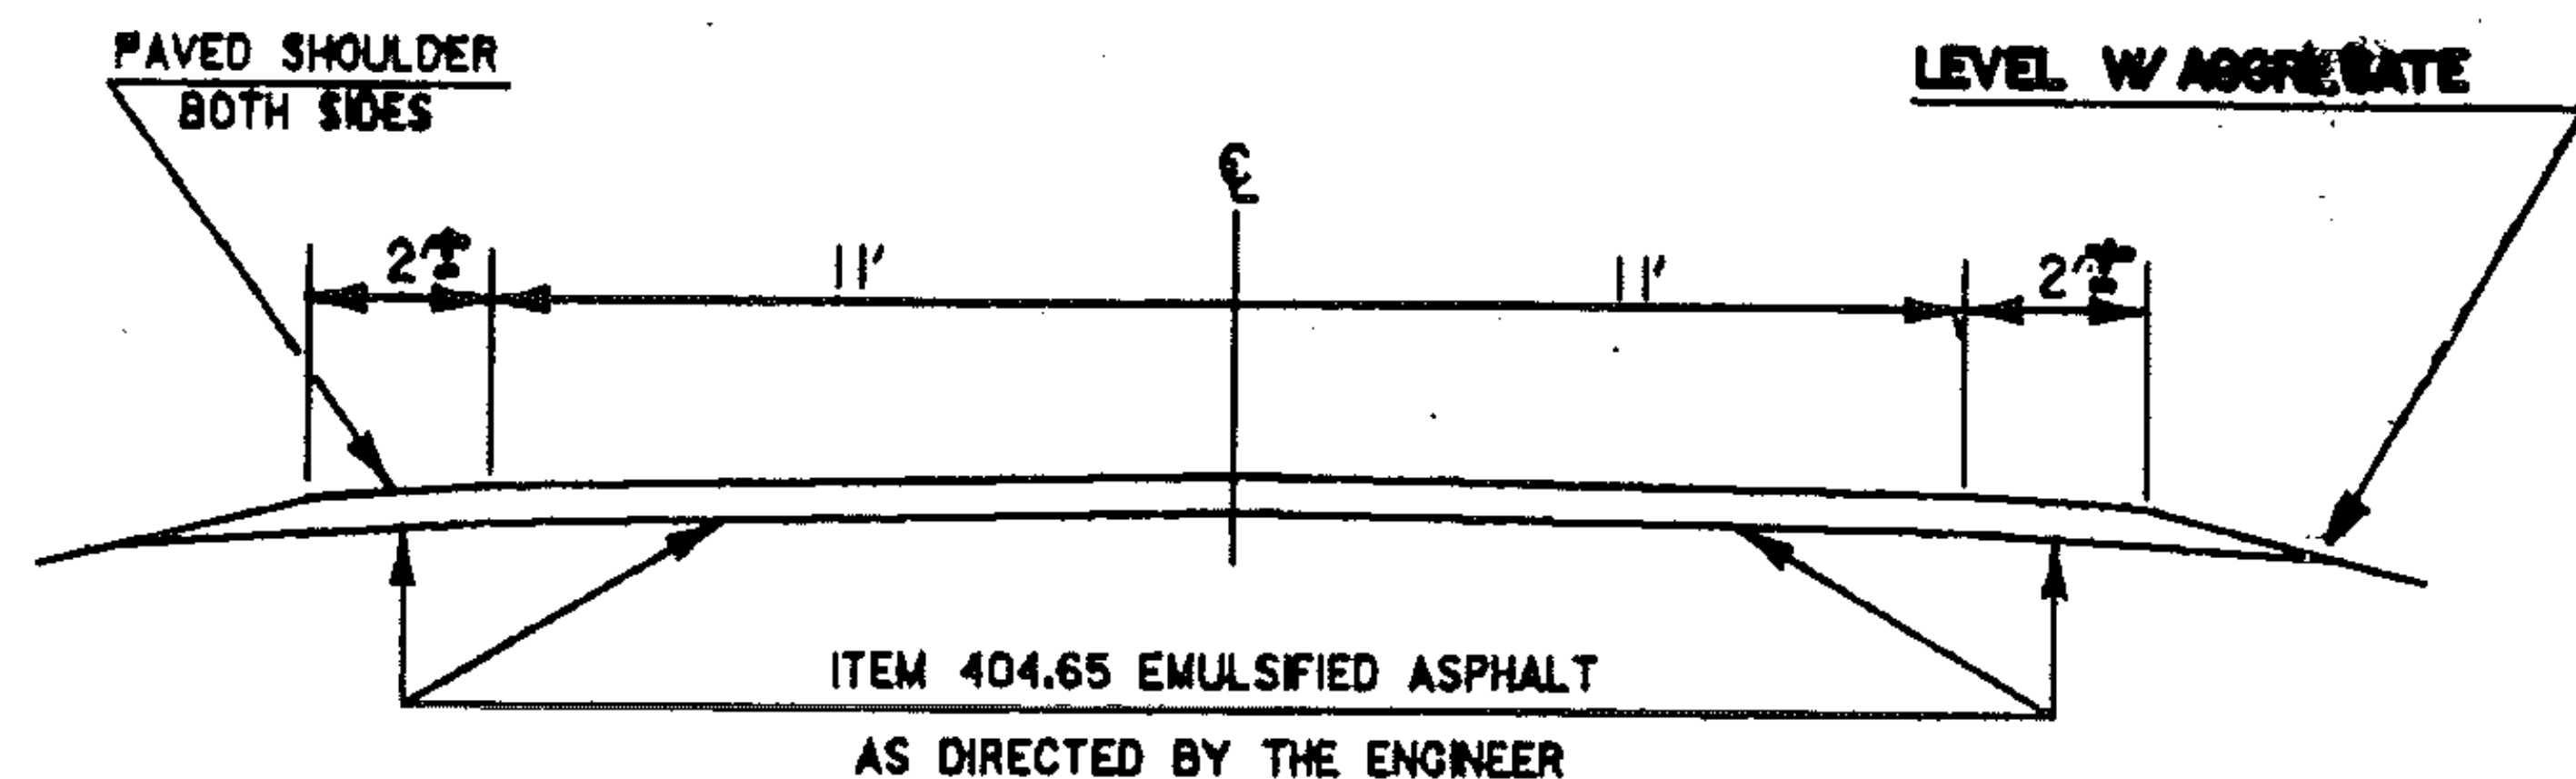

MONTPELIER HMA 2821

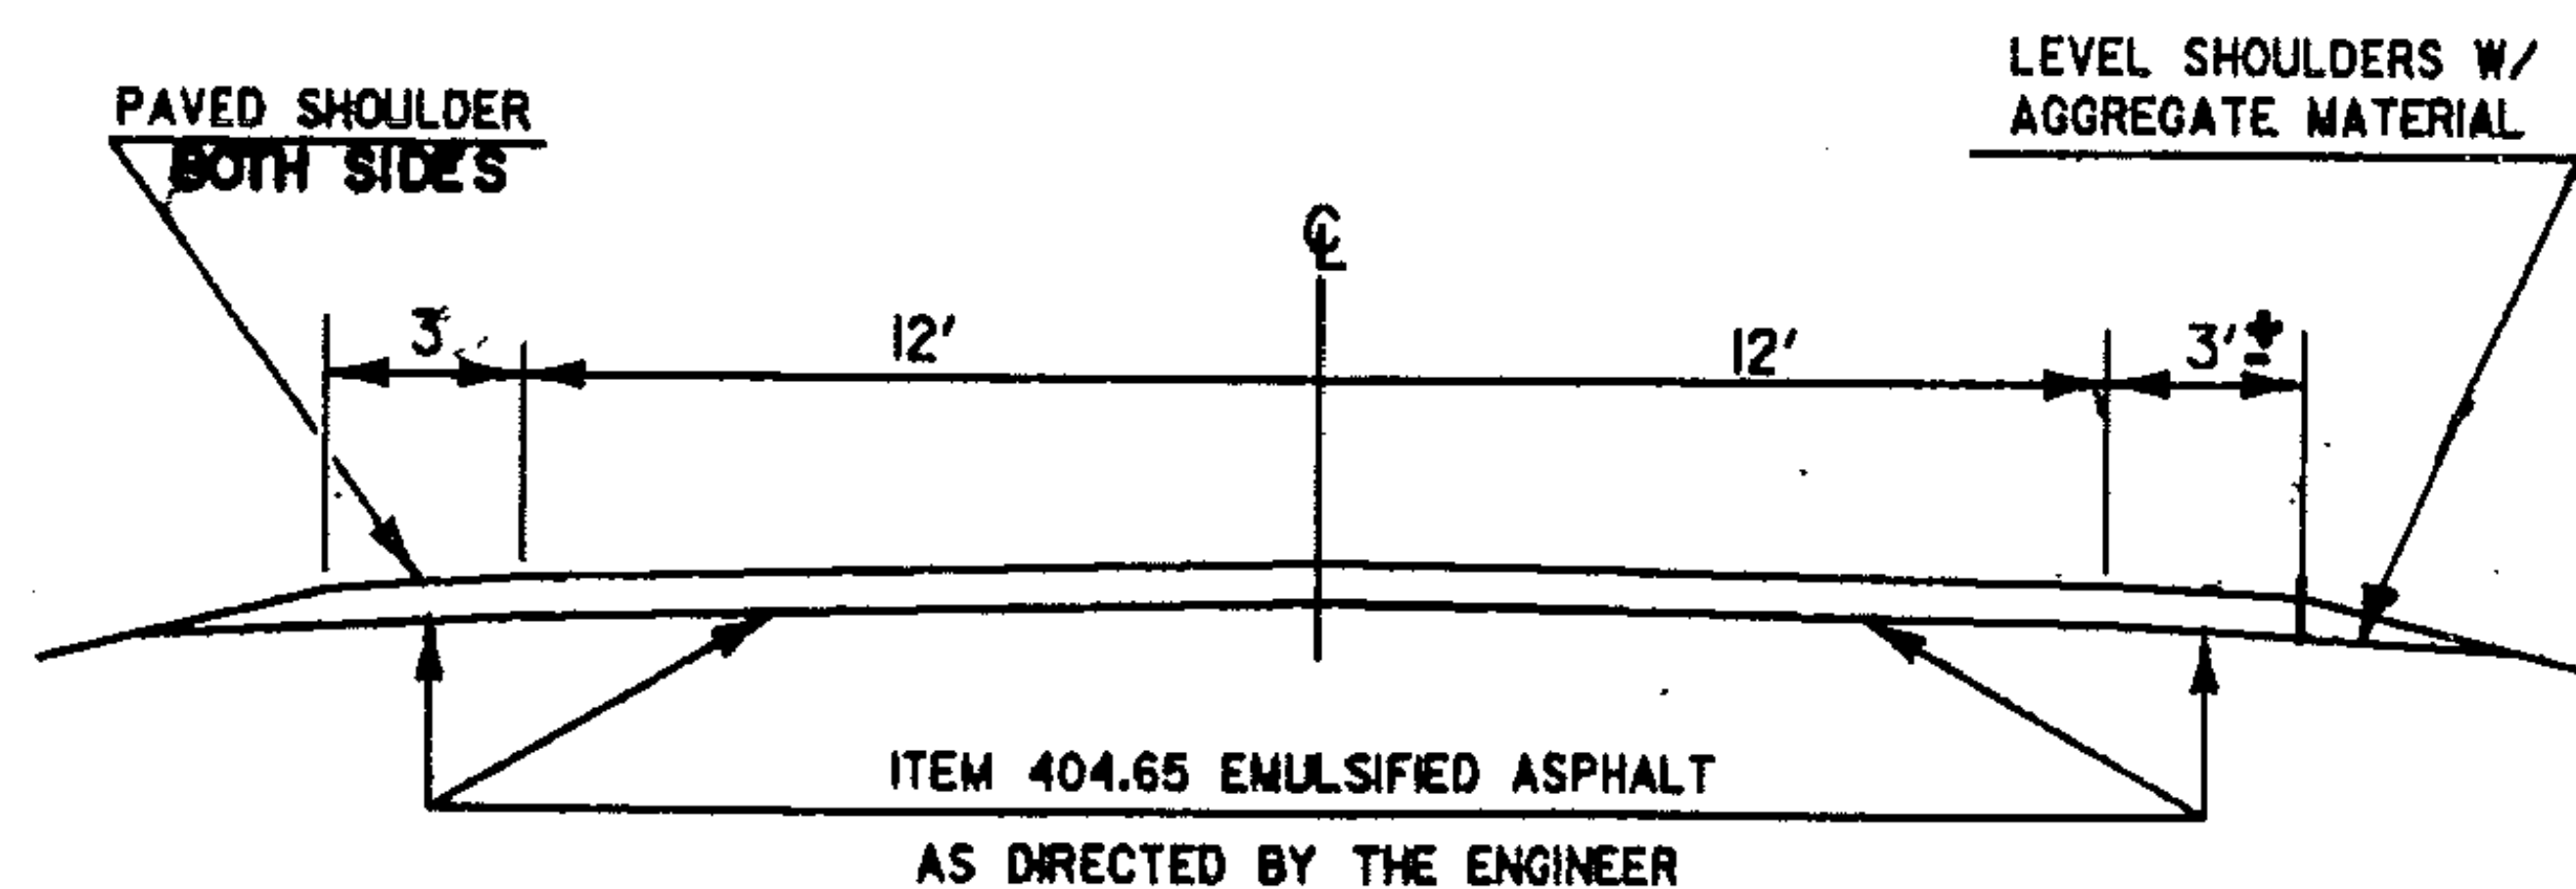

PROJECT WATERFORD-STJOHNSBURY HMA 2842
HARDWICK-WALDEN HMA 2820
MORRISTOWN HMA 2817
MONTPELIER HMA 2821

SHEET 2A OF 81 SHEETS