


DESCRIPTION AND LOCATION

PROJECT LENGTH: 1.36 MILES; 7180 FEET

1986 ADT 2480

BEGINNING IN THE TOWN OF WATERFORD ON U.S. 5
AT M.M. 0.00 AND EXTENDING NORTHERLY THROUGH THE TOWN
TO M.M. 0.269 IN THE TOWN OF ST. JOHNSBURY. RESURFACING
THE EXISTING HIGHWAY AND SHOULDERS, NEW PAVEMENT
MARKINGS, RESURFACE EXISTING GUTTERS, AND RESHAPE AND
RESURFACE EXISTING TIMBER CURB.

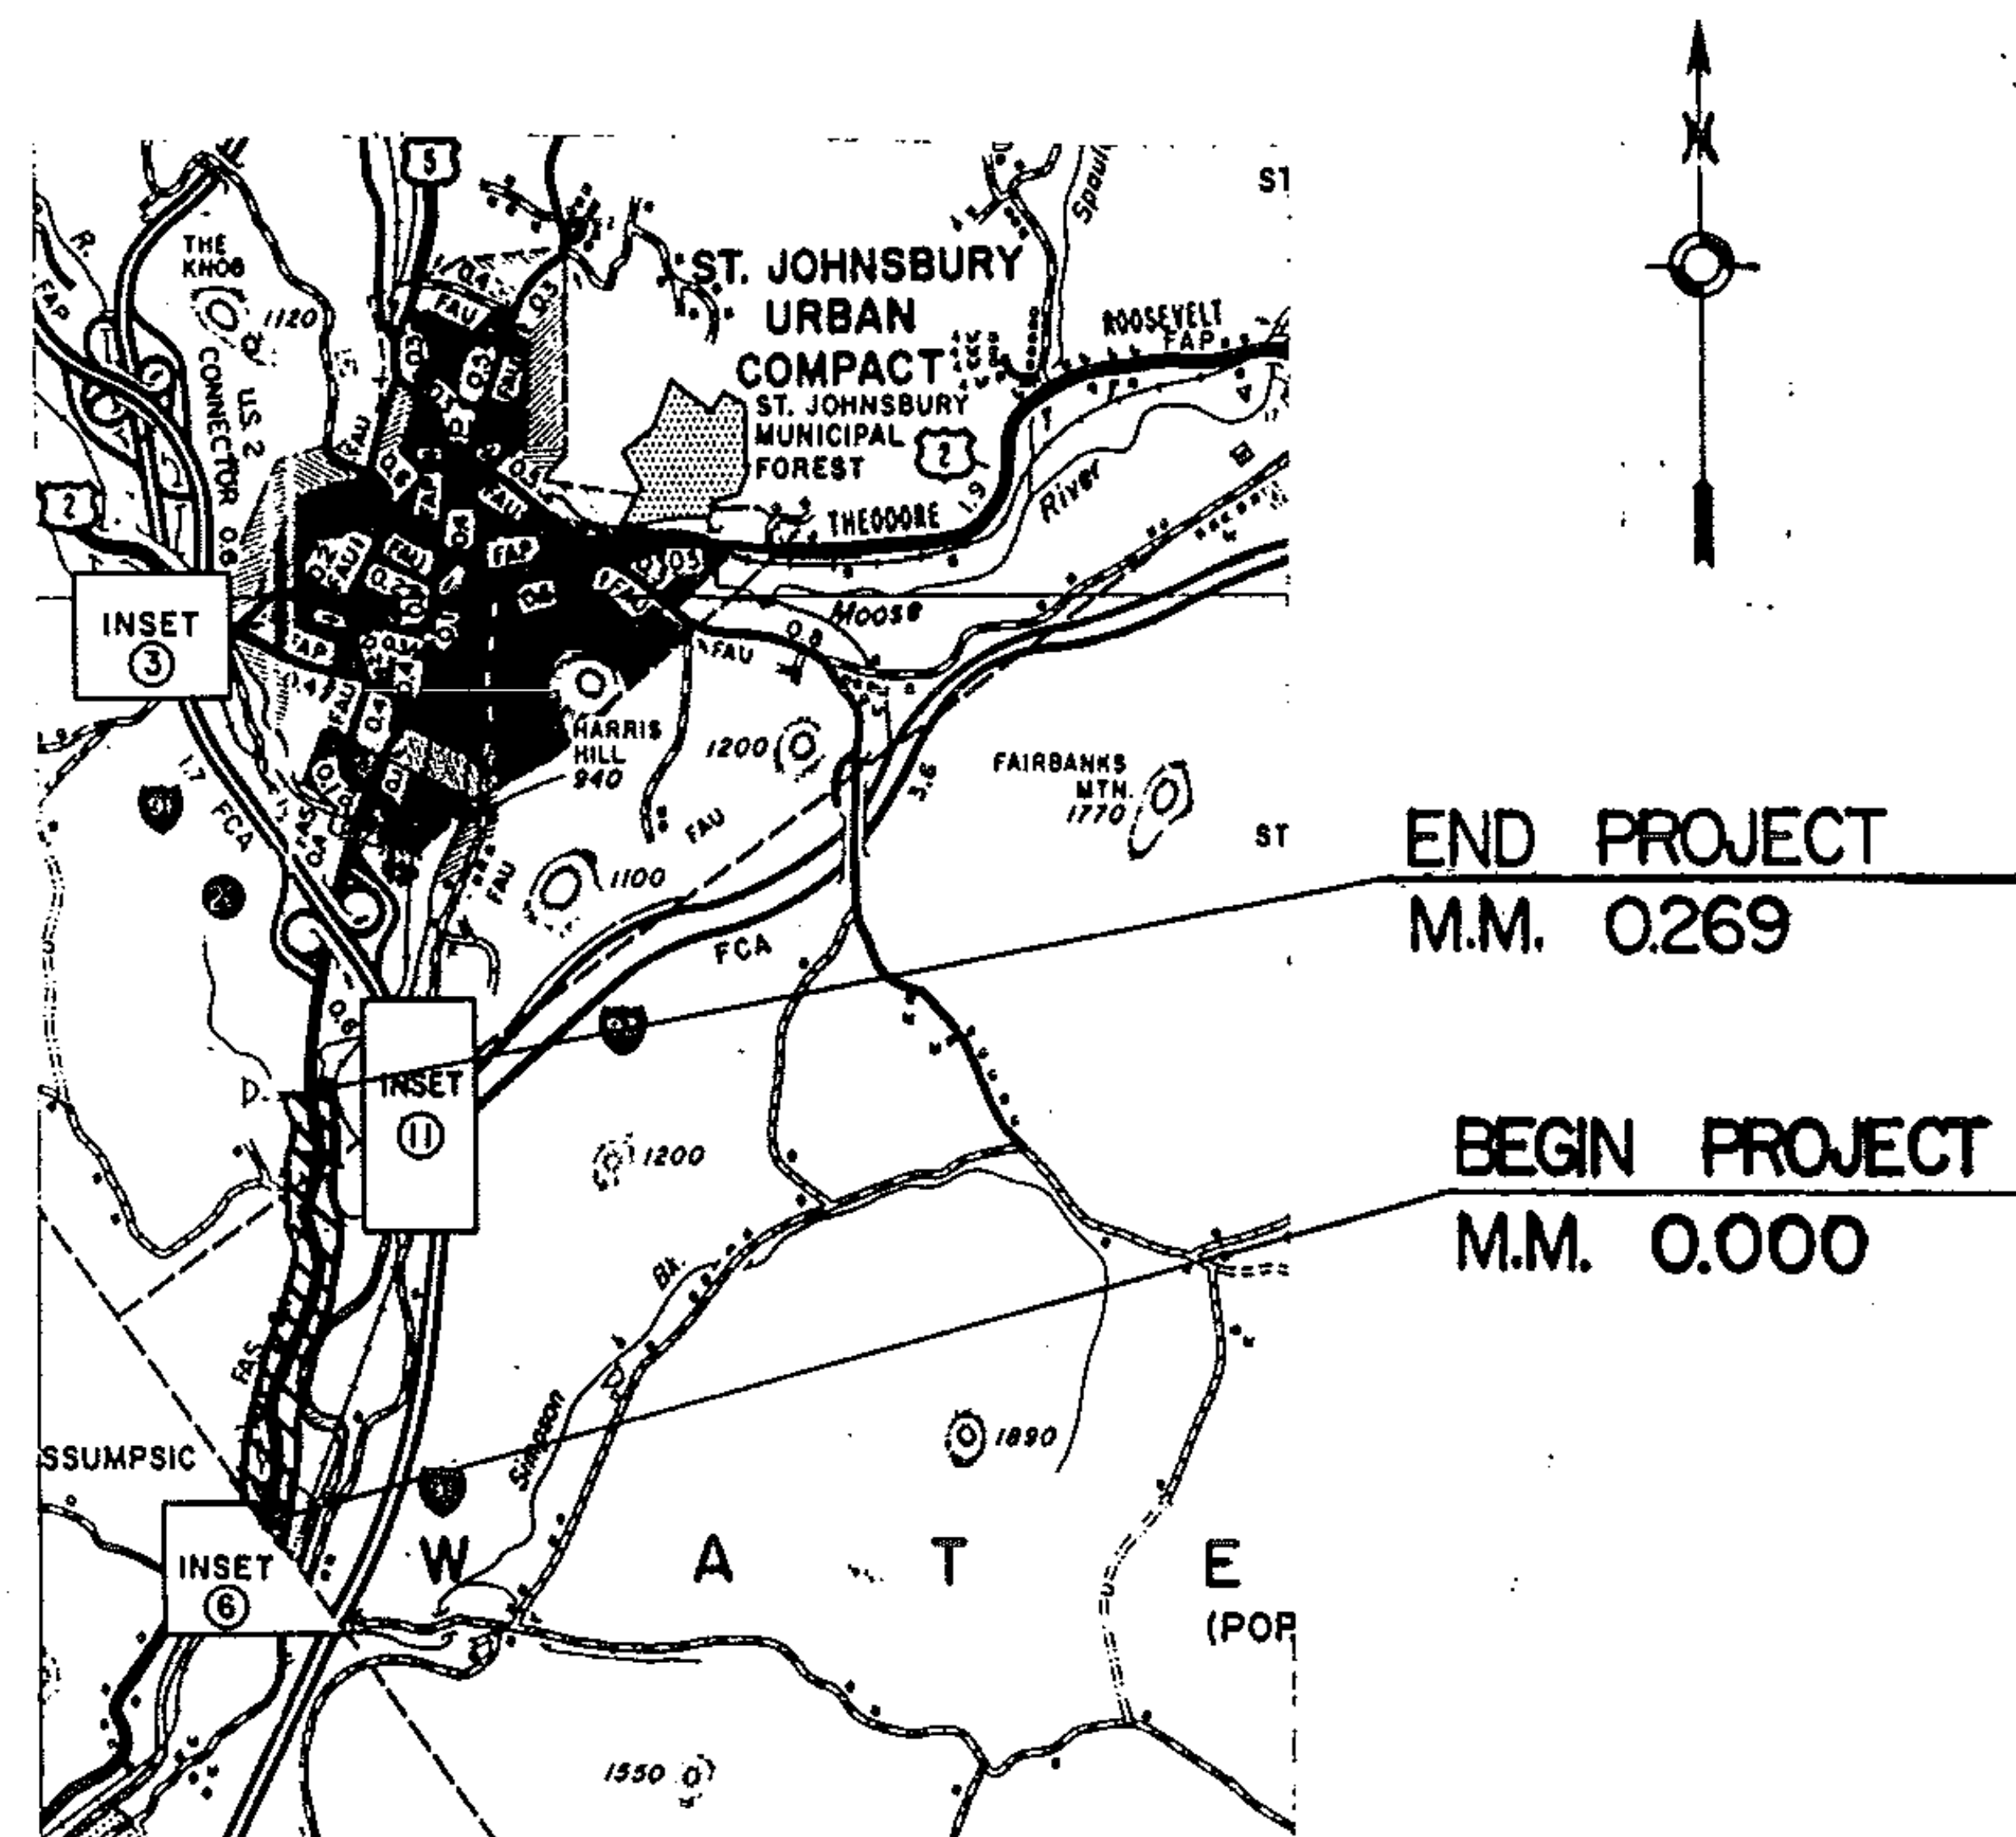

PROJECT WATERFORD-ST. JOHNSBURY

NO. HMA 2842

SHEET 9 OF 8 / SHEETS