


TYPICAL SECTIONS & DESIGN DATA

ITEM 406.25 BITUMINOUS CONCRETE PAVEMENT
LEVELING COURSE TYPE IV (300 TONS/MILE)
1 1/4" WEARING COURSE TYPE III (± 1/4")
AS DIRECTED BY THE ENGINEER

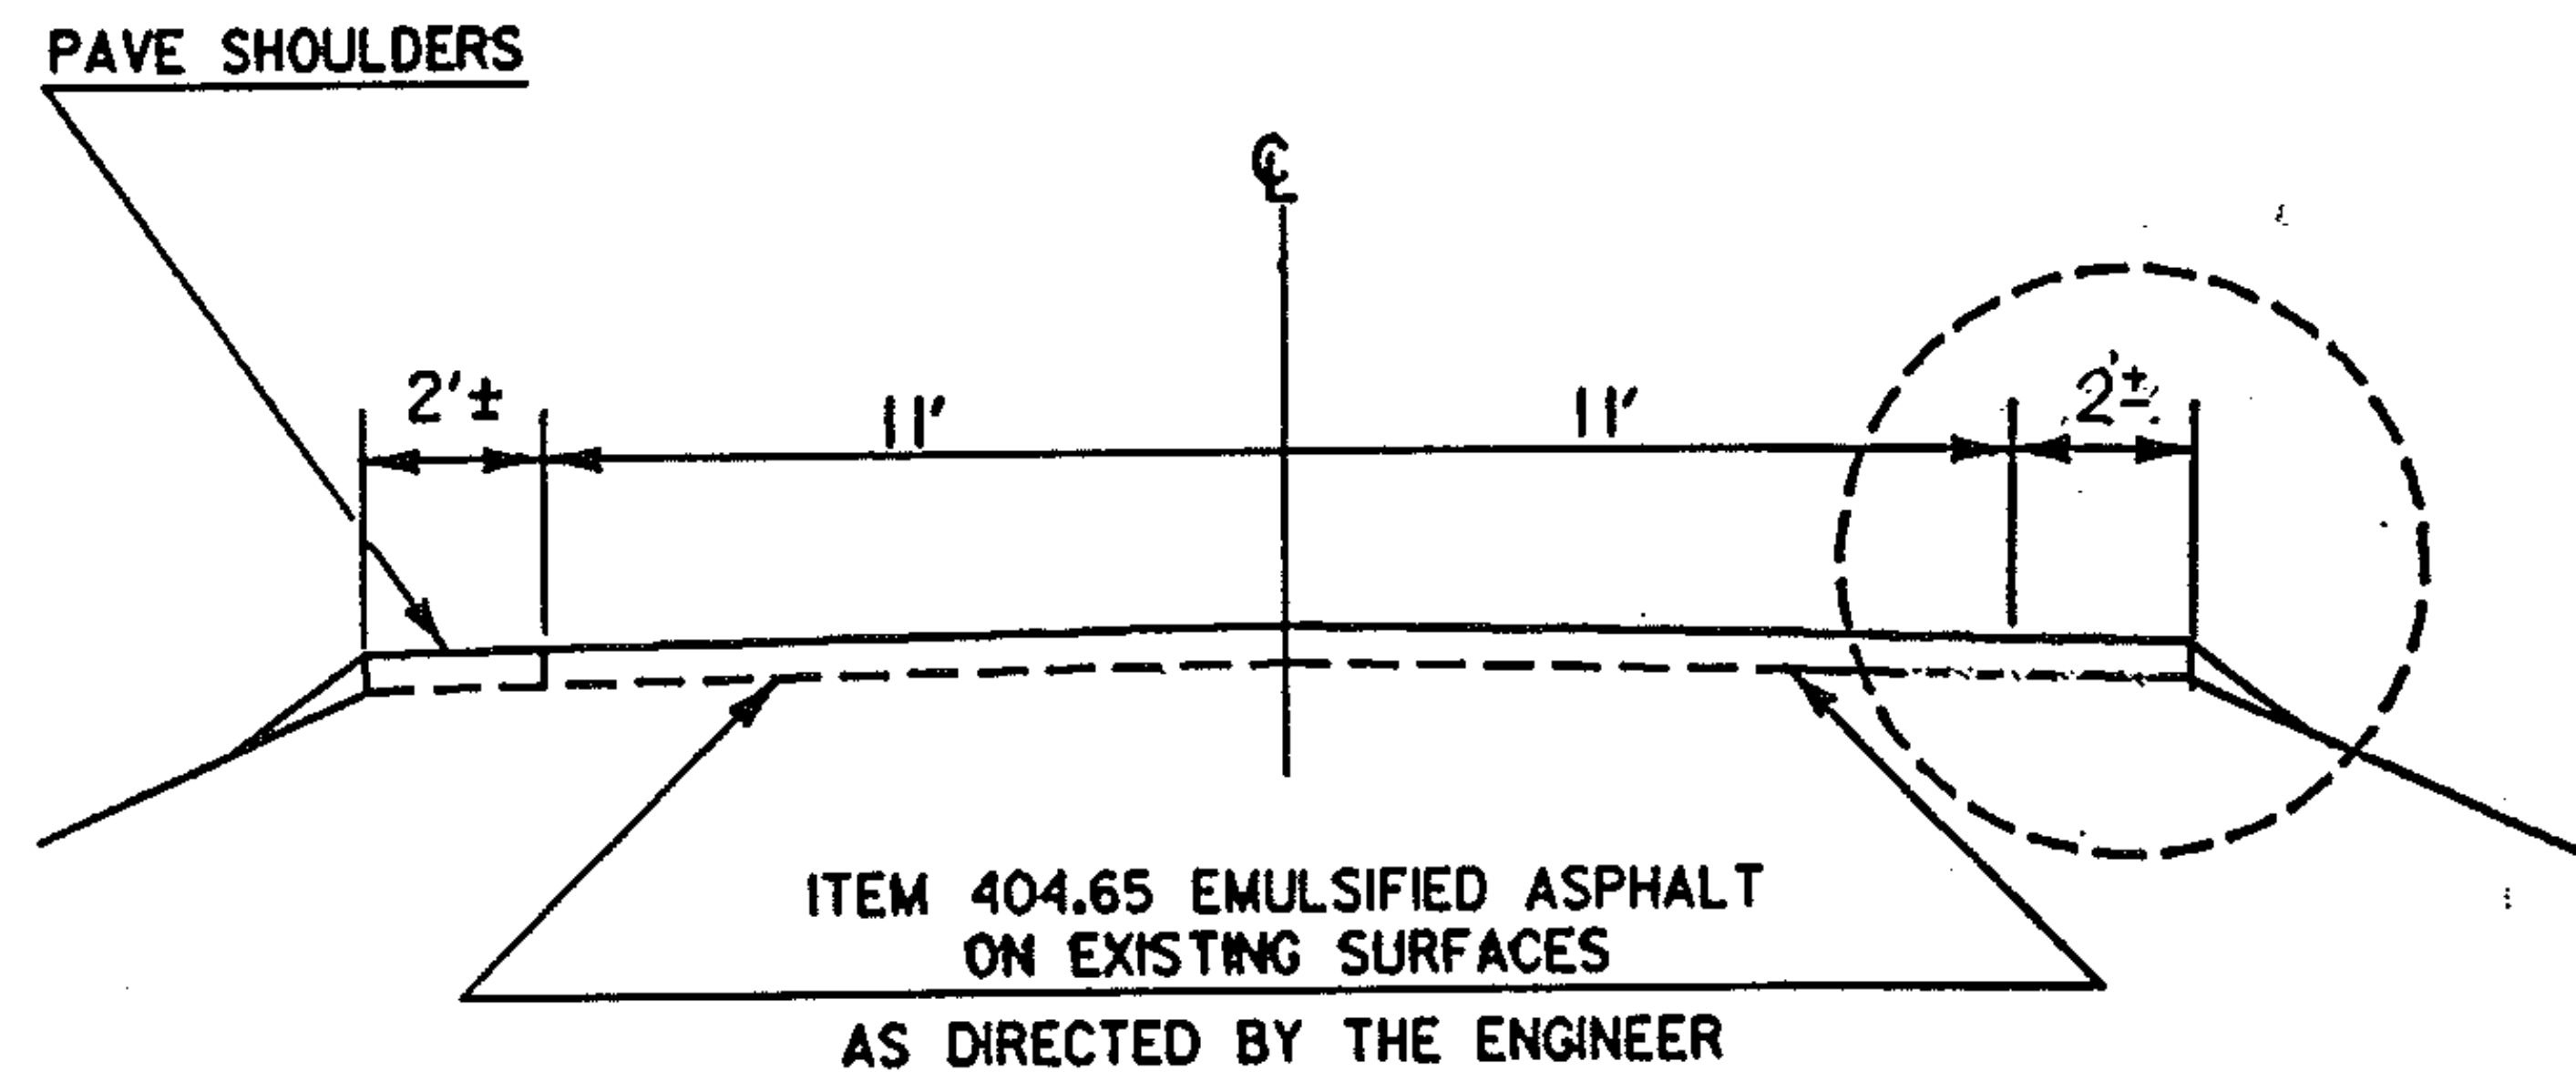

WATERFORD - ST JOHNSBURY
US 5
MM 0.000 ~ MM 0.269

GENERAL NOTES:

MM 0.11± LT. ERODED SHOULDER LEFT SIDE TO BE REPAIRED
AND PAID FOR BY ITEM 402.10 , OR 402.12 GRAVEL SHOULDERS

WATERFORD MM 0.25~0.30± RT. CLEAN, RESHAPE, AND RESURFACE TREATED
TIMBER CURB AS DIRECTED BY THE ENGINEER.

ST. JOHNSBURY MM 0.00~0.269± LT. RESURFACE EXISTING GUTTER WITH 1"
OF ITEM 616.47 BITUMINOUS CONCRETE GUTTERS & TRAFFIC ISLANDS

PROJECT WATERFORD - ST JOHNSBURY

NO. HMA 2842
SHEET 10 OF 81 SHEETS