


TYPICAL SECTIONS & DESIGN DATA

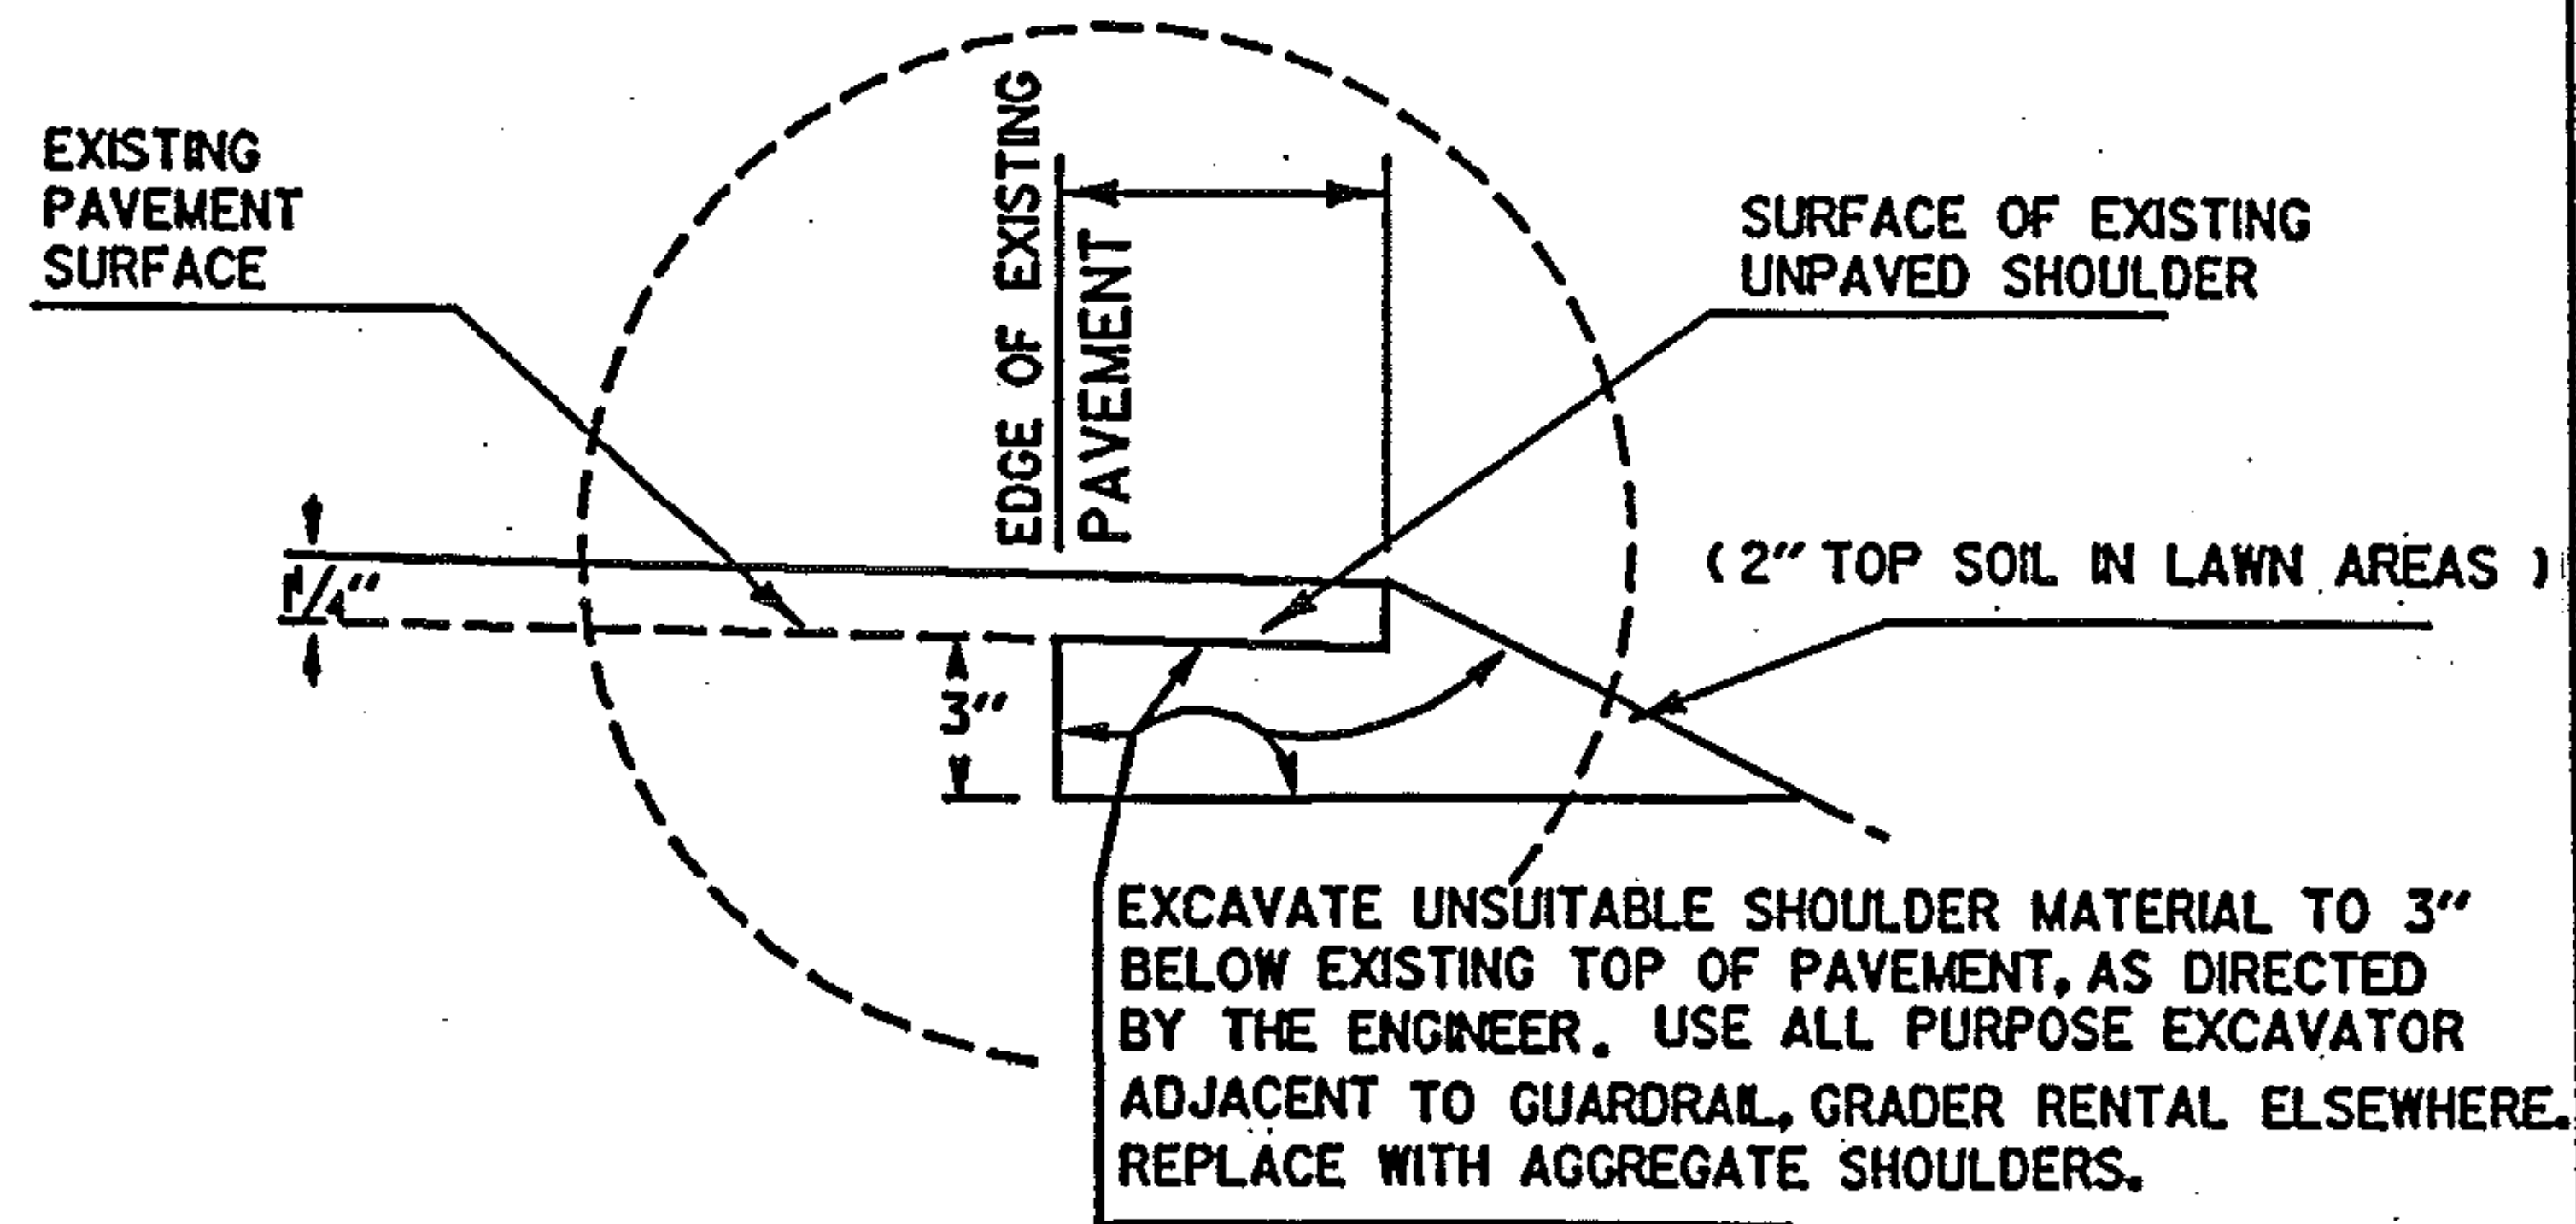

PROJECT Waterford - St. Johnsbury

NO. HMA 2842

SHEET 10A OF 81 SHEETS