


# TYPICAL SECTIONS & DESIGN DATA

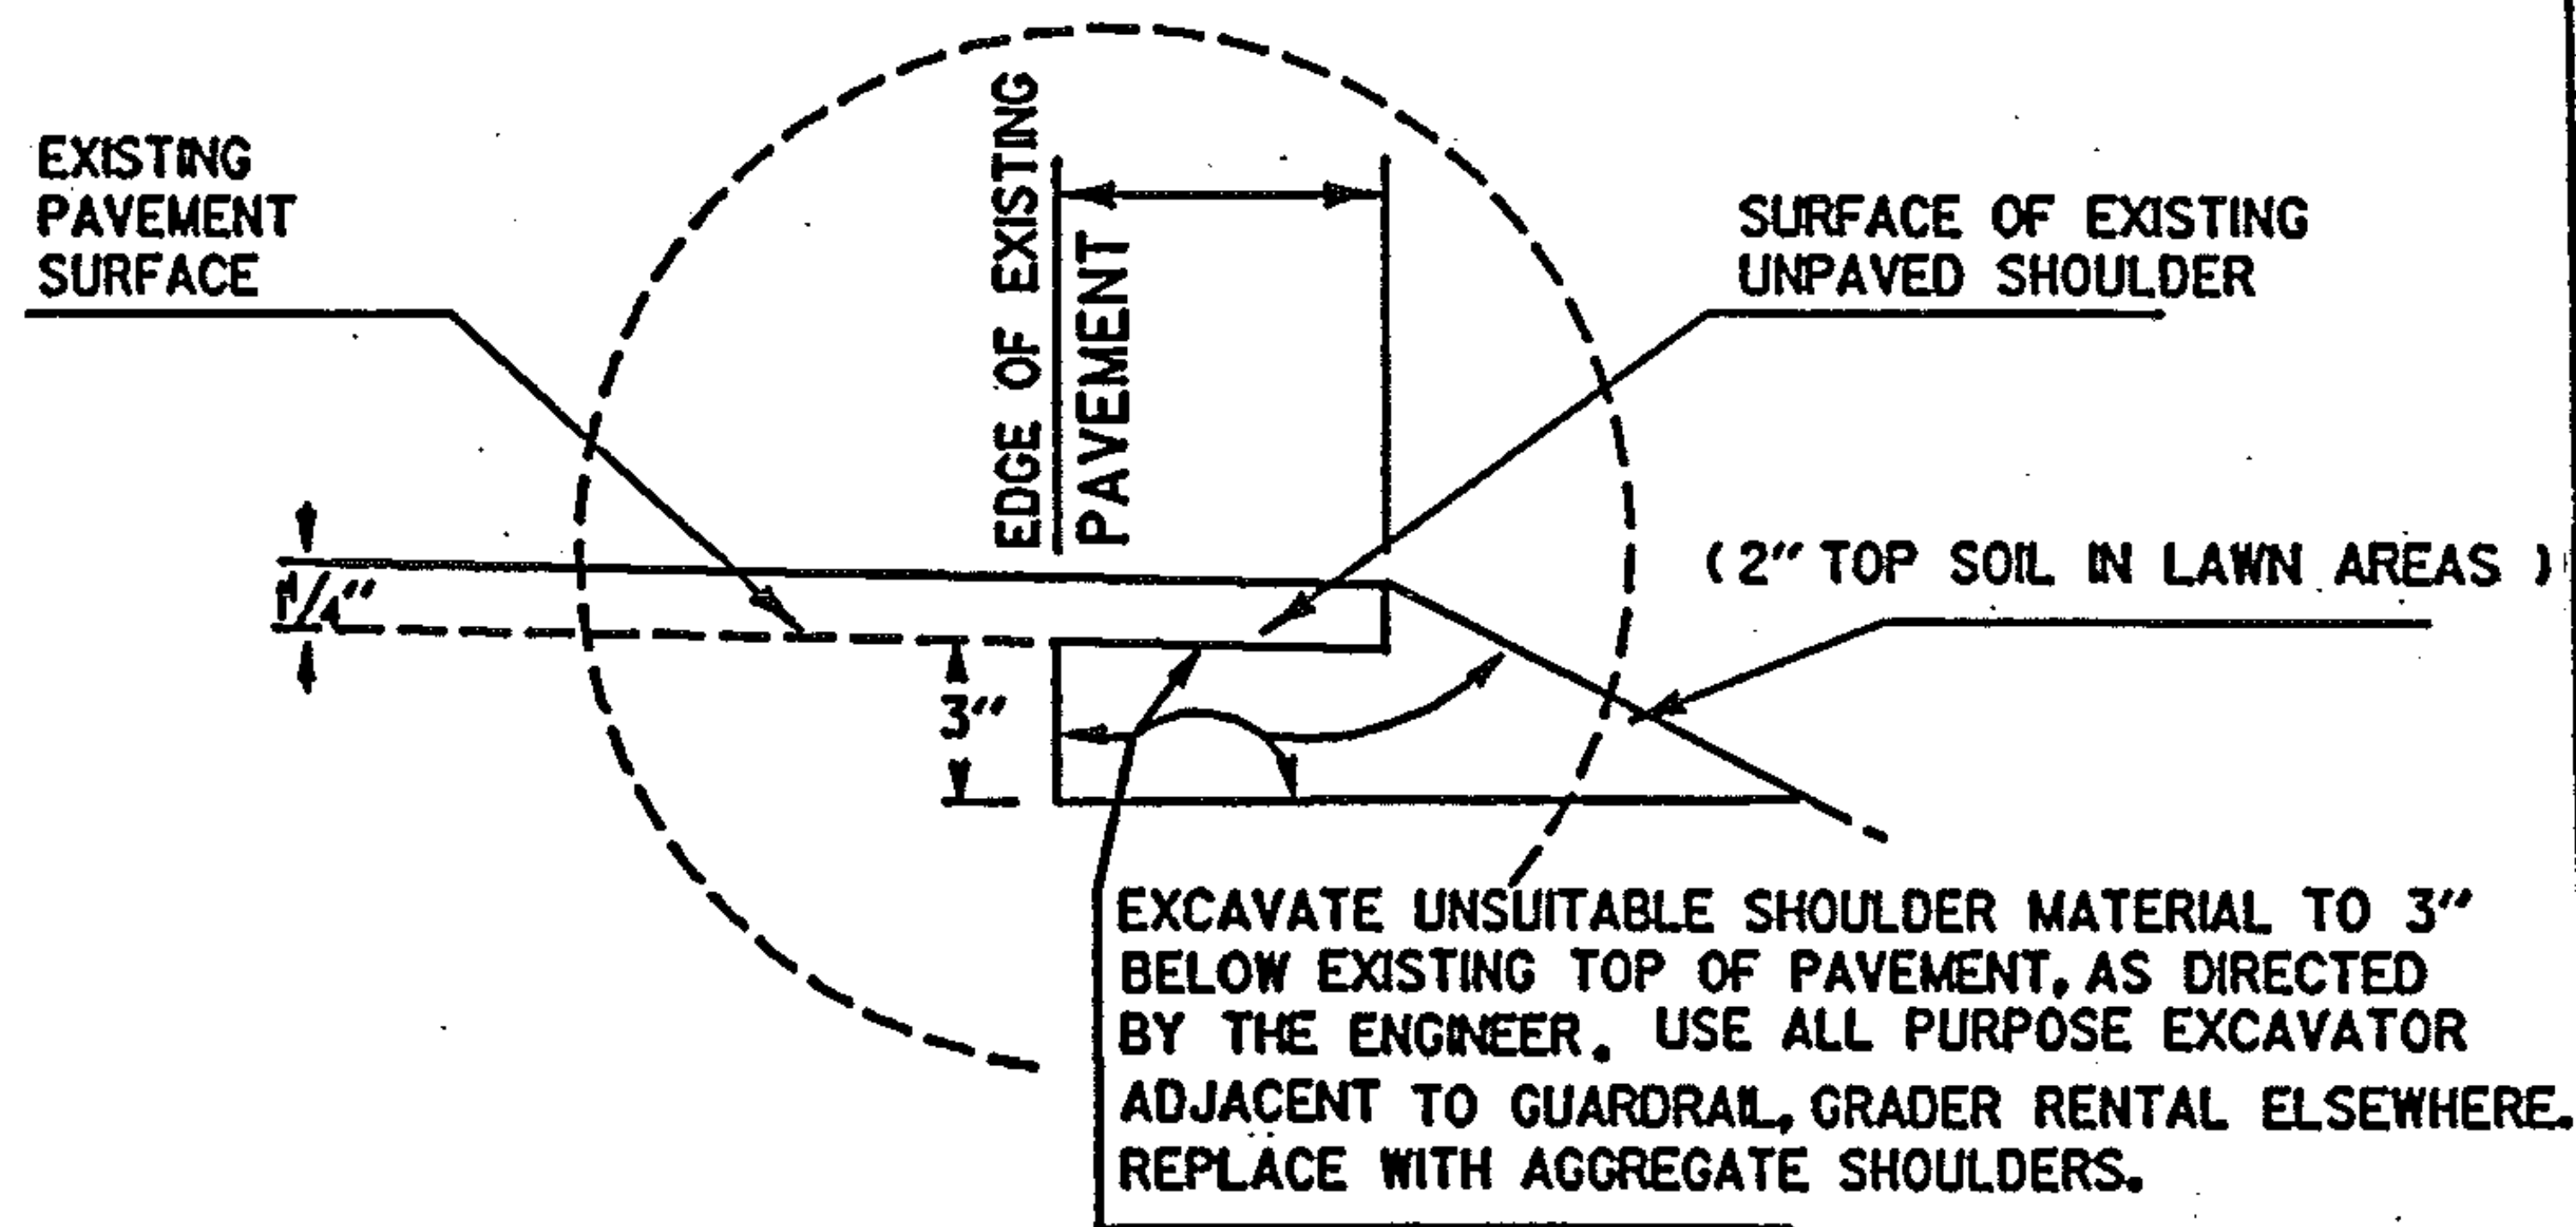

PROJECT Hardwick-Walden

NO. HMA 2820

SHEET 24 OF 61 SHEETS