


BY GCP DATE 2/11/87 SUBJECT Pavement Marking
CHKD. BY _____ DATE _____

SHEET NO. 42 OF 81
JOB NO. HMA 2-21
Montpelier

Edge [REDACTED] in. 2' From Curb.

↓ AHEAD
32' (TYP.)
↑ STOP
16'

See Sht. #47 For
Detail

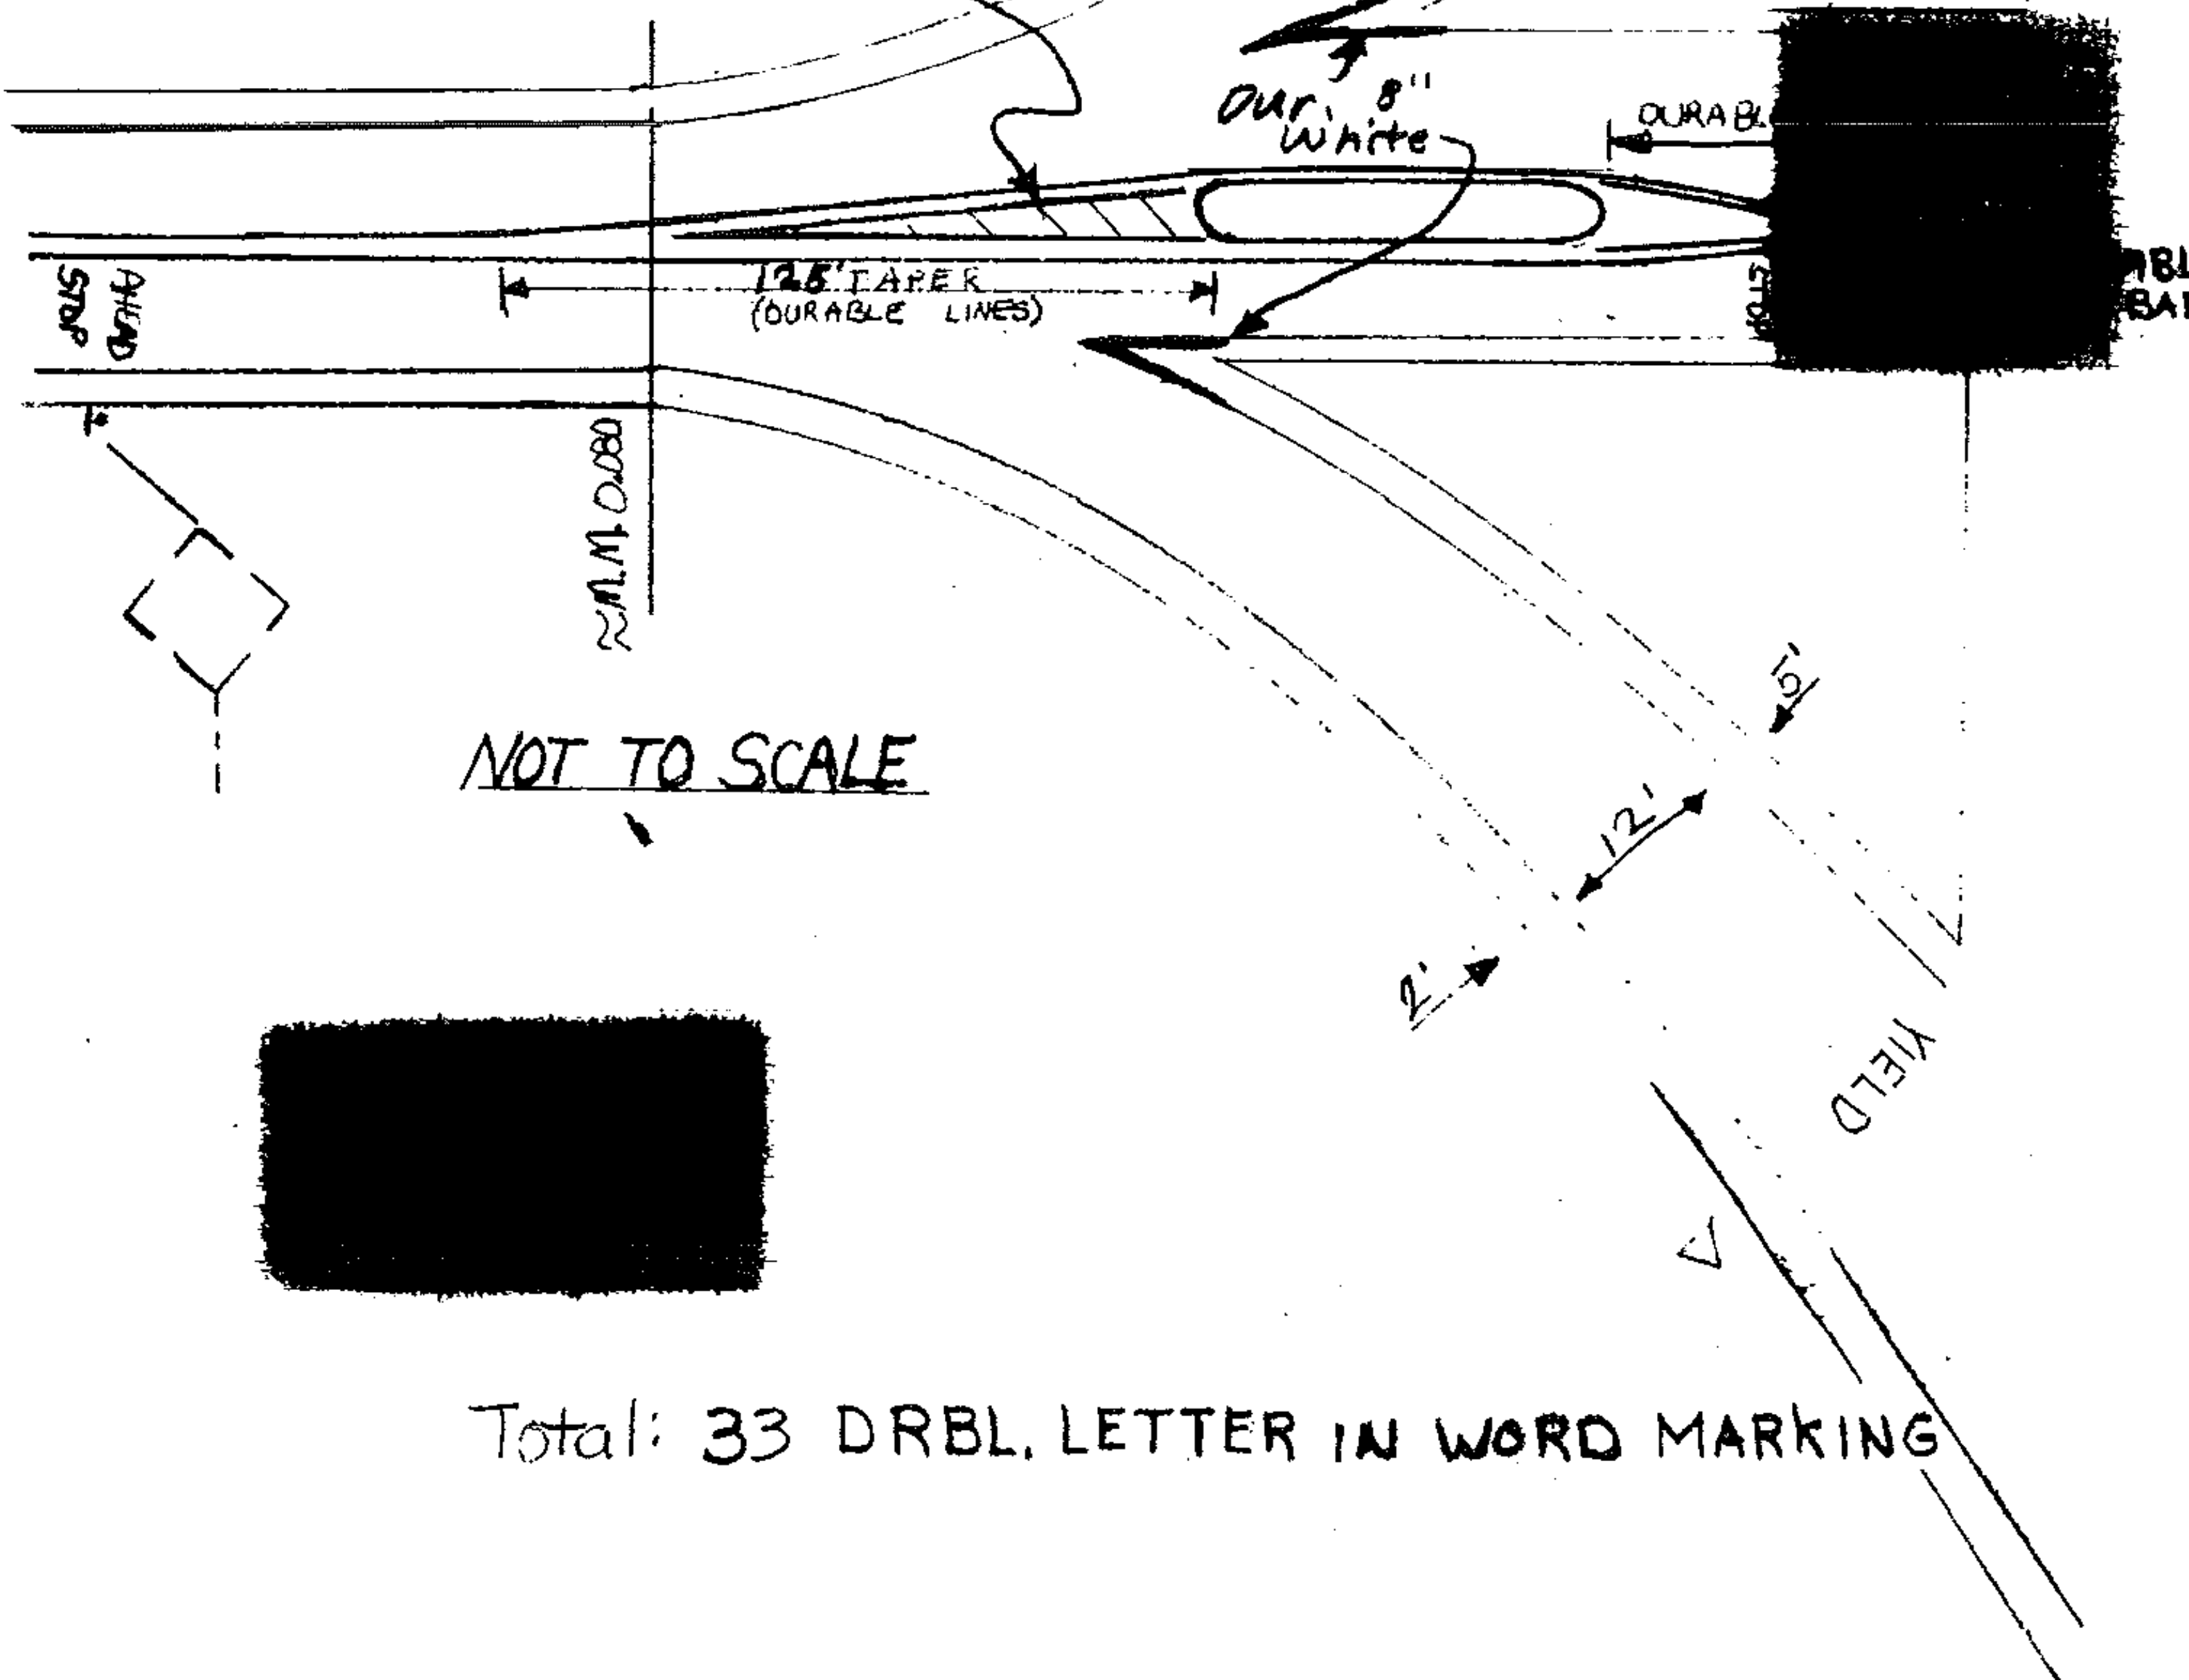

Total: 33 DRBL. LETTER IN WORD MARKING