



SPECIAL MARKING DETAILS

Painted Island Detail

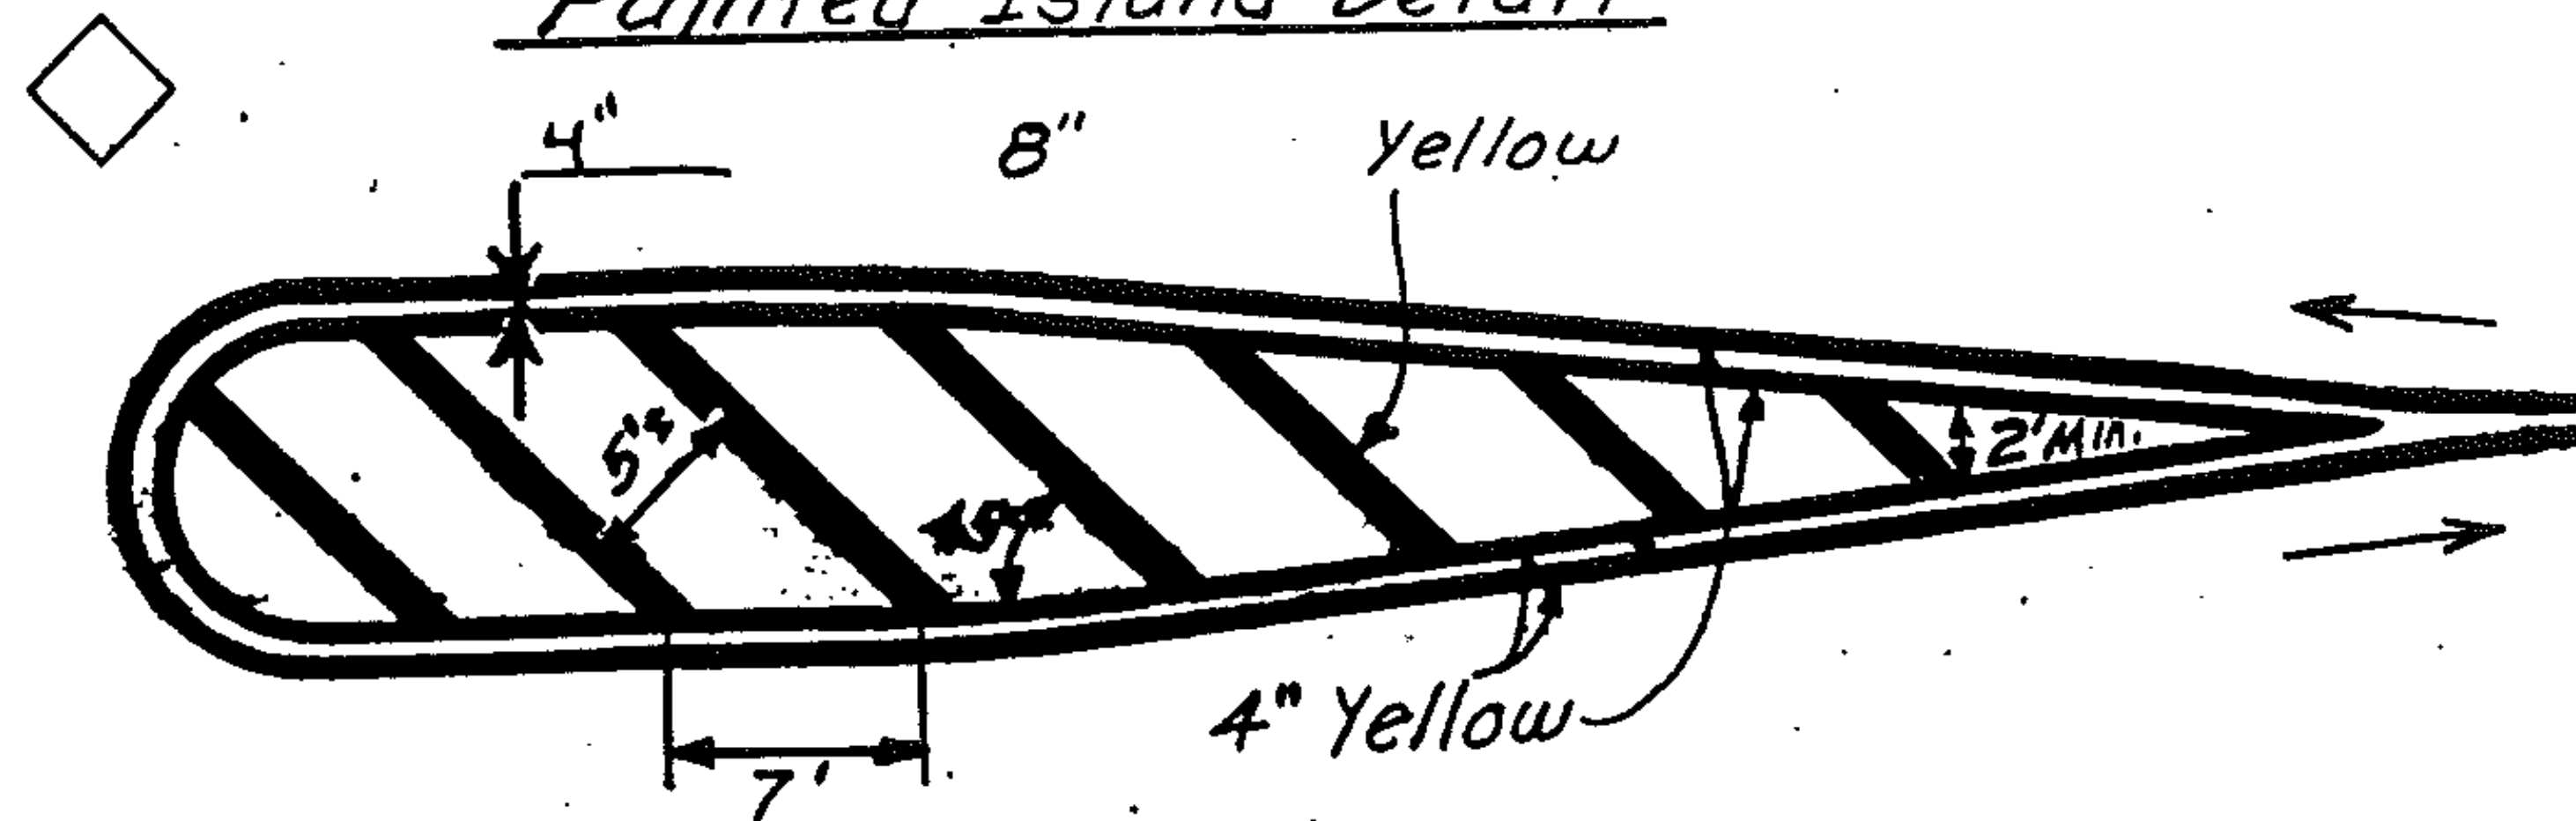


Not to Scale

Gore Marking Detail - EXIT

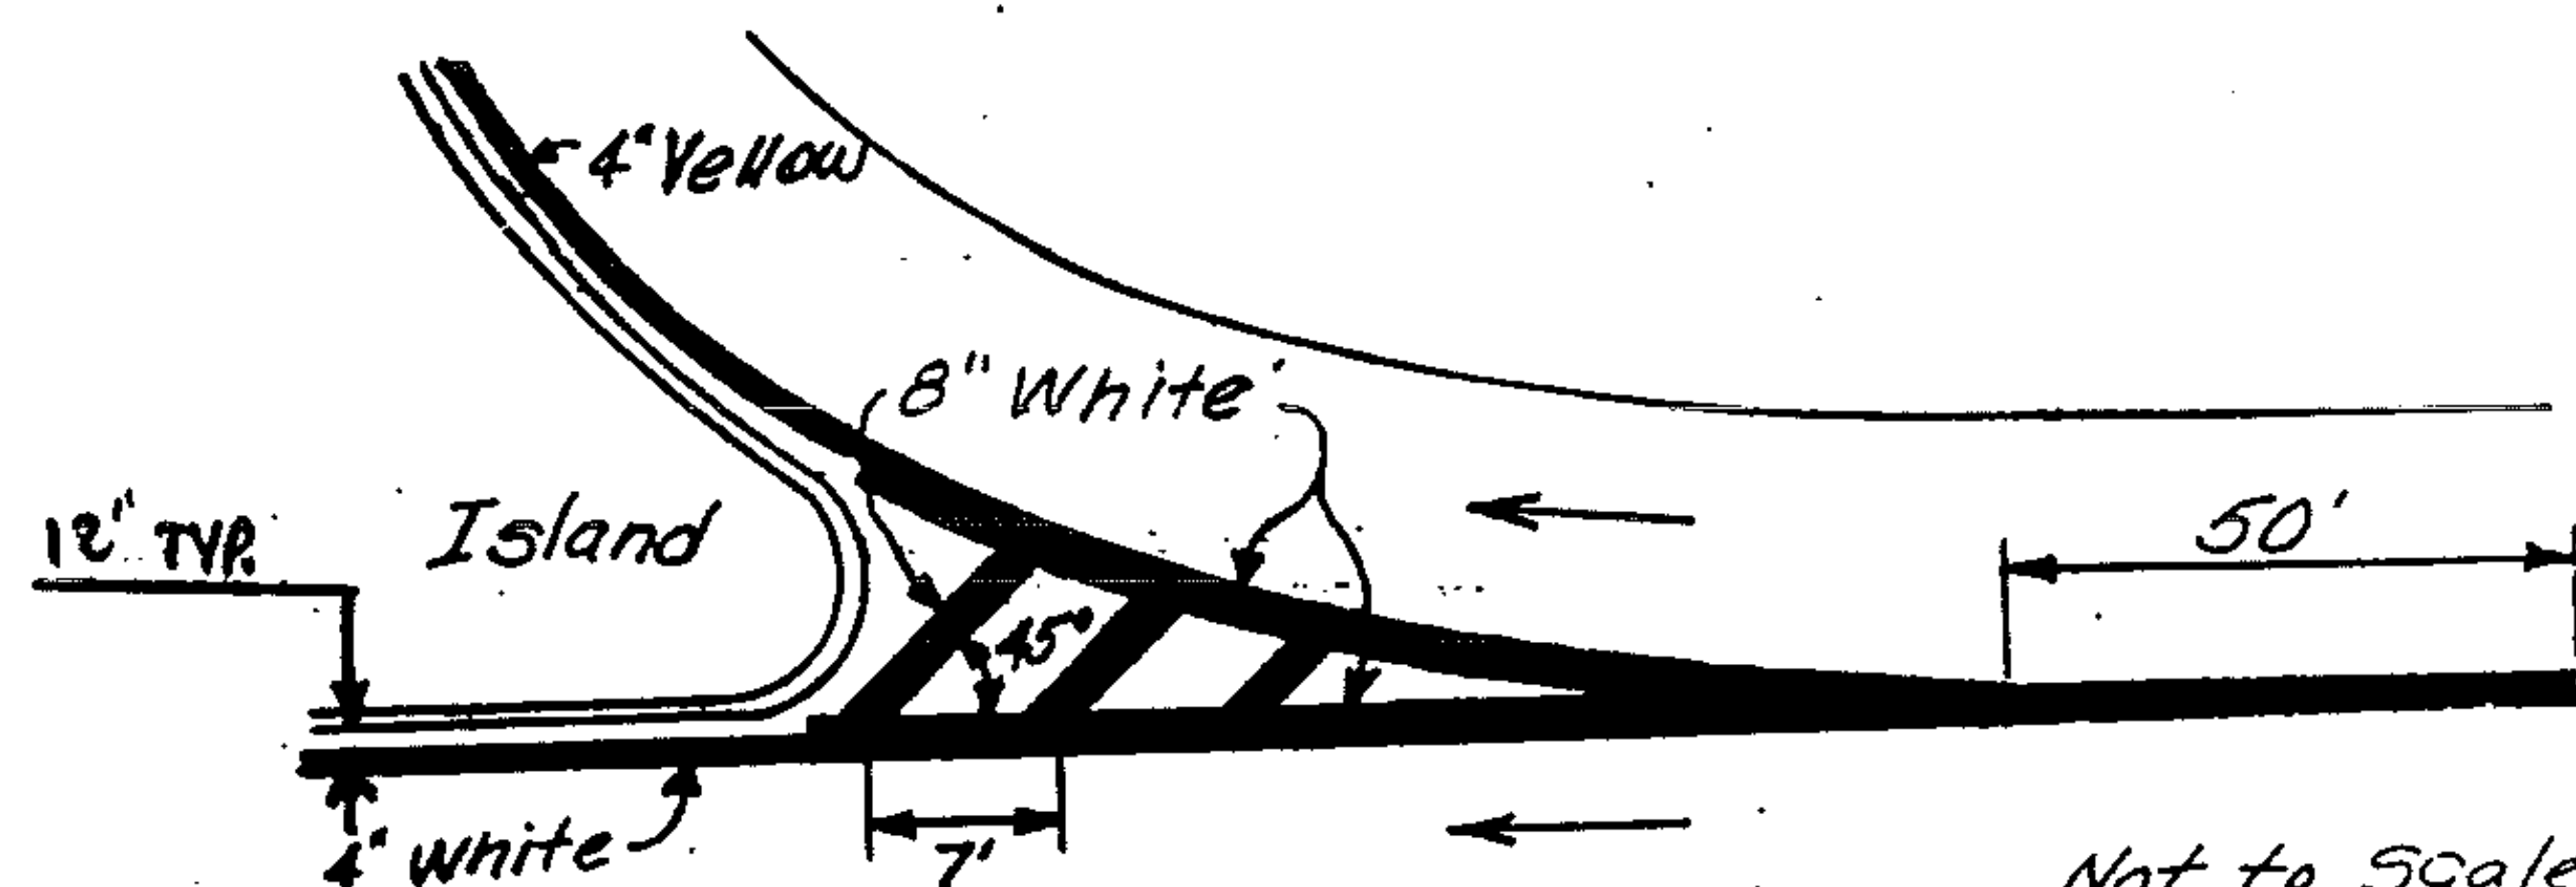

Not to Scale

Turn Lane and Painted Curb Detail

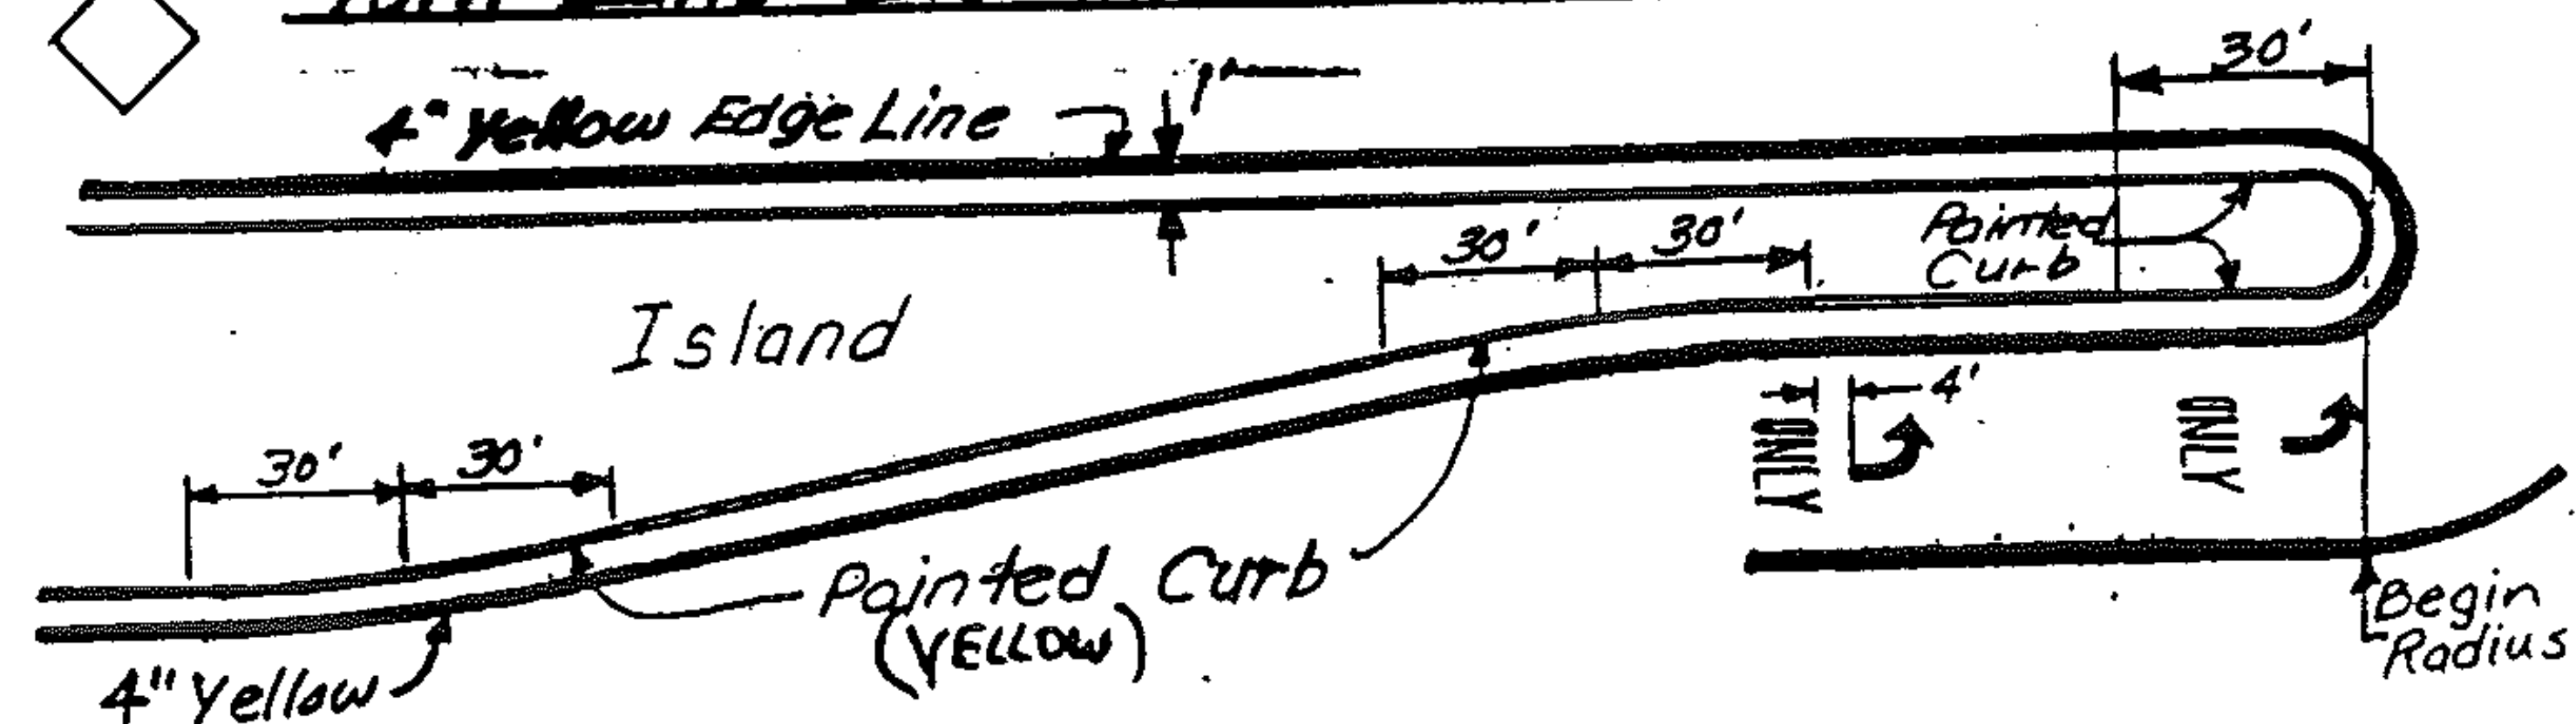

Not to Scale