


STOP BAR DETAILS

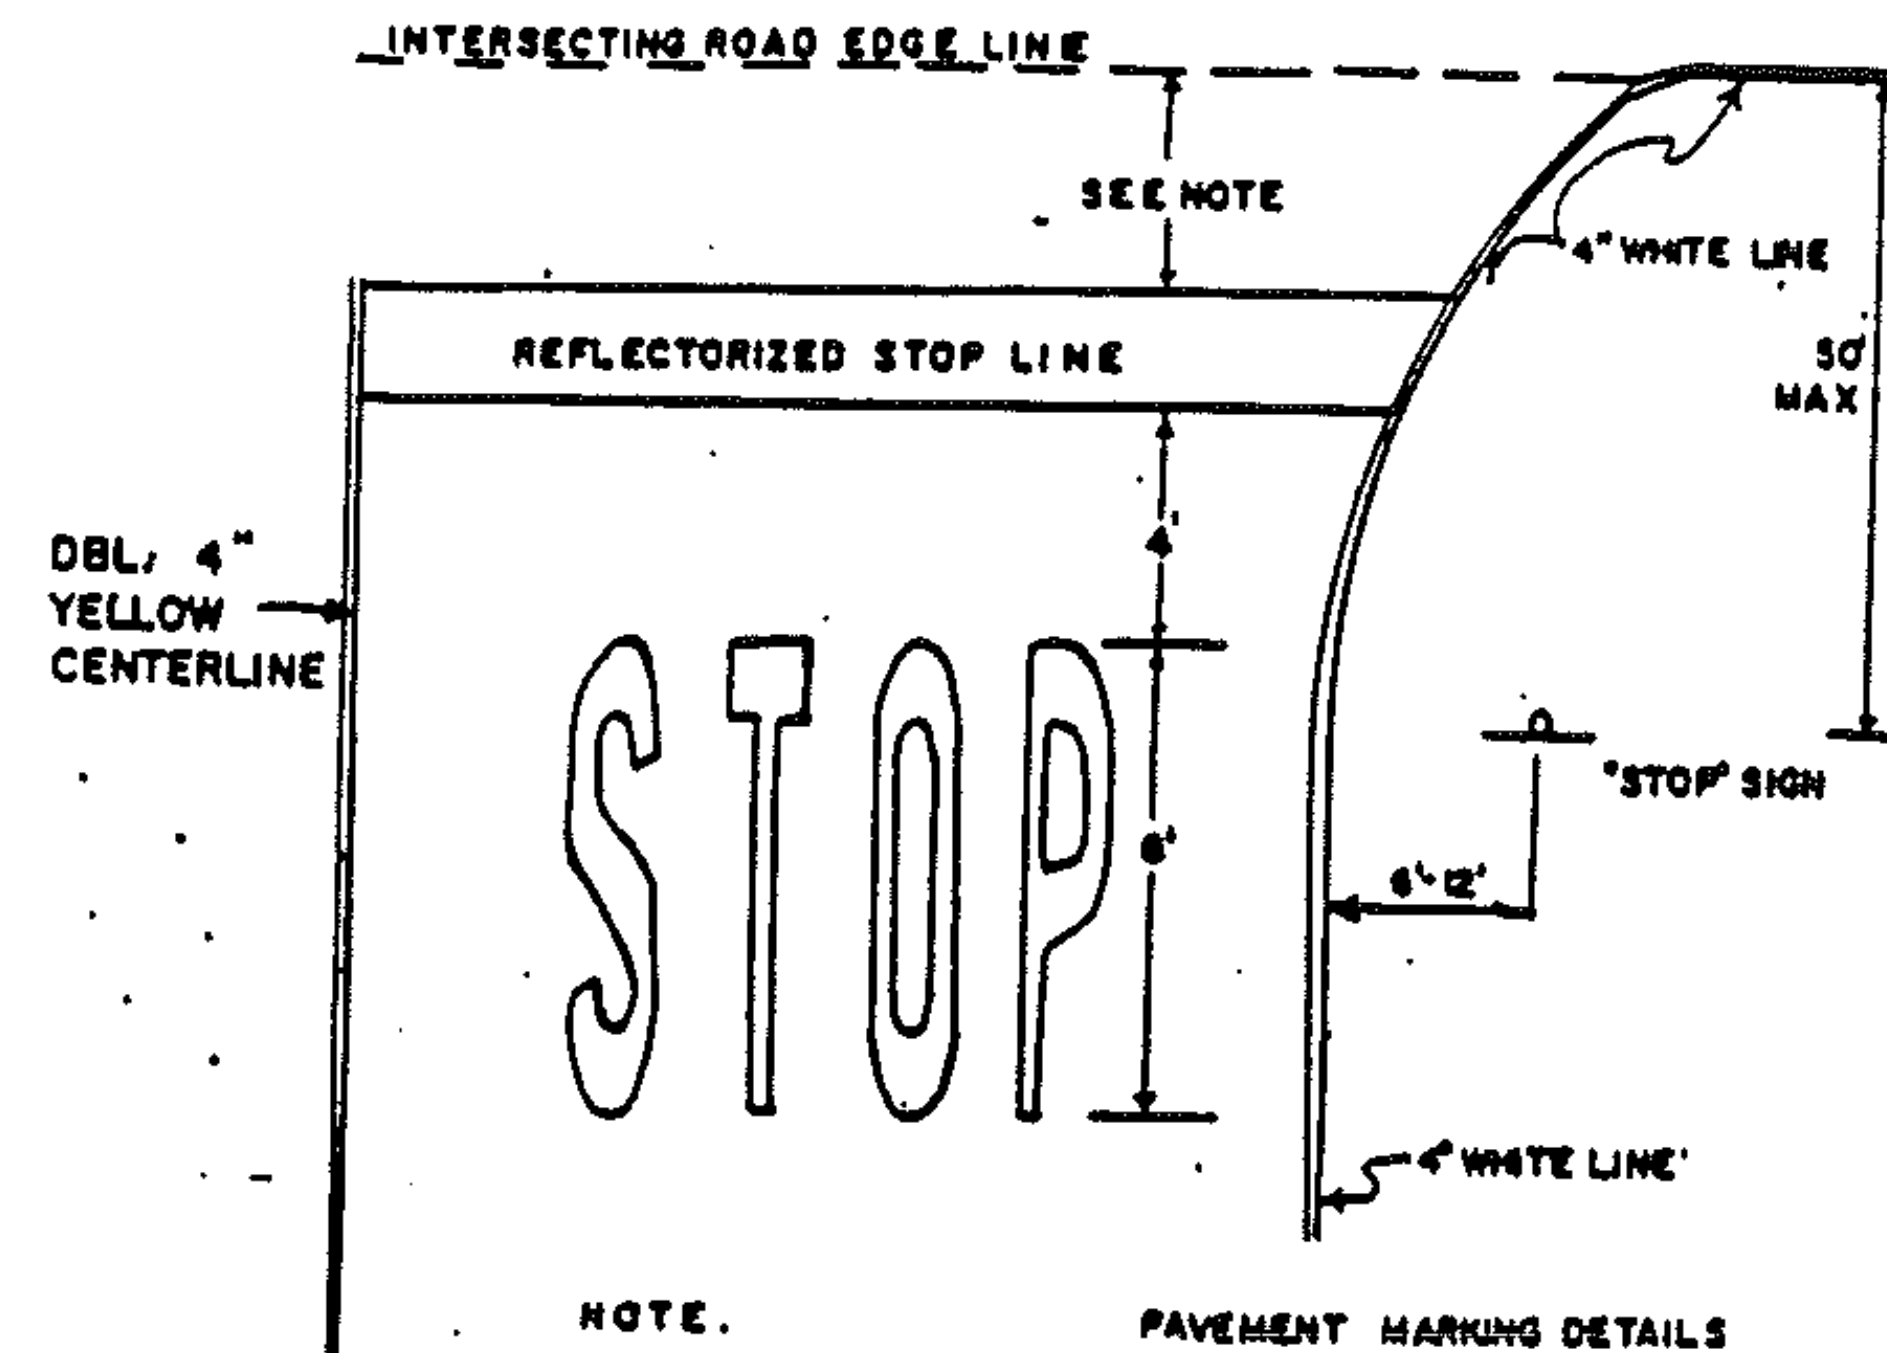

1. THE STOP LINE SHOULD BE PLACED AT THE DESIRED STOPPING POINT; IN NO CASE MORE THAN 30 FEET OR LESS THAN 4' FROM THE NEAREST EDGE OF THE INTERSECTING ROADWAY, OR EDGE OF CROSSWALK.