


STATE OF VERMONT
 AGENCY OF TRANSPORTATION

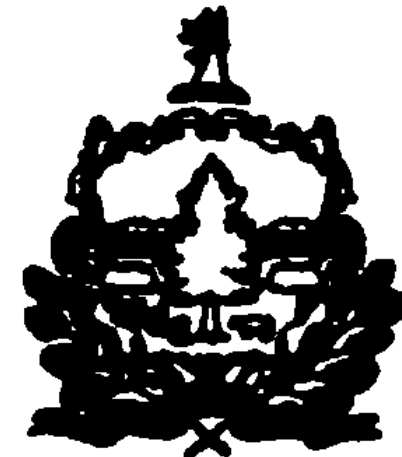



PROPOSED IMPROVEMENT

TOWN OF JAMAICA - WINDHAM

COUNTY OF WINDHAM, BENNINGTON

ROUTE NO. VT. R.T. 30

ROUTE CLASS F.A.P.

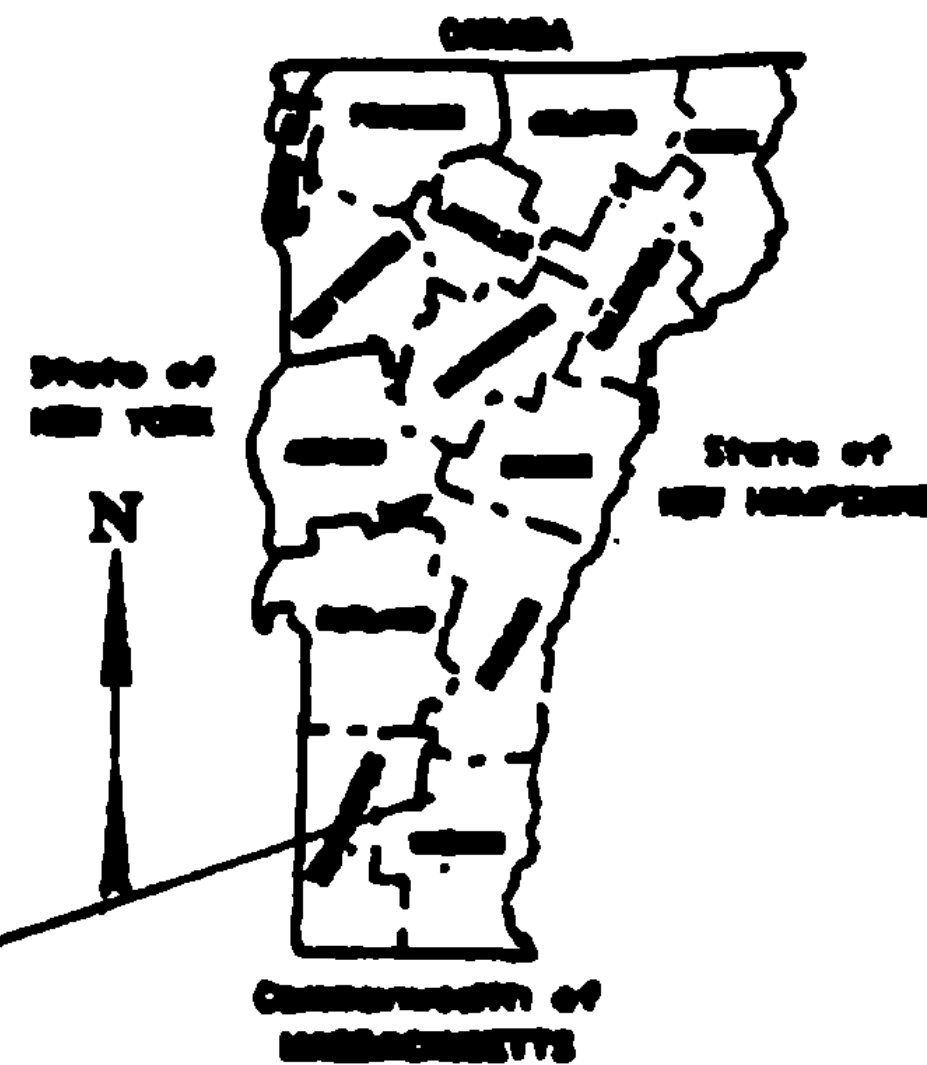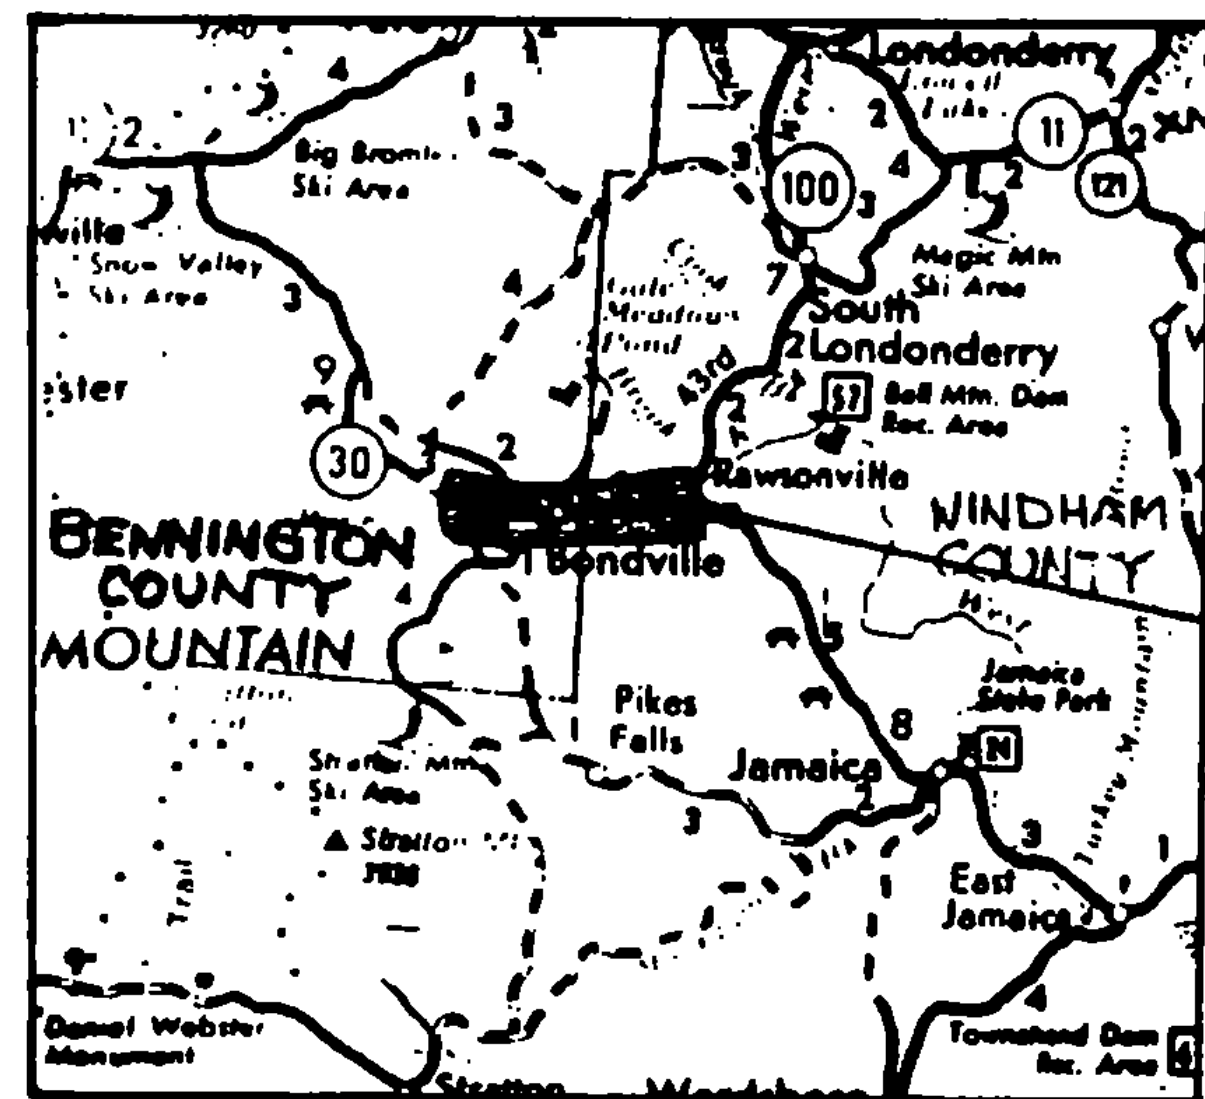

PROJECT
HMA 2818

THESE PLANS ARE SUBJECT TO SUCH ENGINEERING CHANGES AS MAY BE REQUIRED BY THE FEDERAL HIGHWAY ADMINISTRATION OR THE CHIEF ENGINEER. CONSTRUCTION IS TO BE CARRIED ON IN ACCORDANCE WITH THESE PLANS AND THE STANDARD SPECIFICATIONS FOR CONSTRUCTION DATED 1966, AS APPROVED BY THE FEDERAL HIGHWAY ADMINISTRATION ON NOVEMBER 2, 1966 FOR USE ON THIS PROJECT, INCLUDING ALL SUBSEQUENT REVISIONS AND SUCH REVISED SPECIFICATIONS AND SPECIAL PROVISIONS AS ARE INCORPORATED IN THESE PLANS.

REMITTED BY ORDER OF THE STATE TRANSPORTATION BOARD

APPROVED _____ DATE _____
 CHIEF ENGINEER

DEPARTMENT OF TRANSPORTATION
 FEDERAL HIGHWAY ADMINISTRATION

APPROVED _____ DATE _____
 DIVISION ADMINISTRATOR

PROJECT HMA 2818

SHEET 1 OF 10 SHEETS



SCALE IN MILES

FOR INDEX OF SHEETS, SEE SHT. 2

SHT. 9 OF 64 SHEETS