


PROJECT DESCRIPTION AND LOCATION

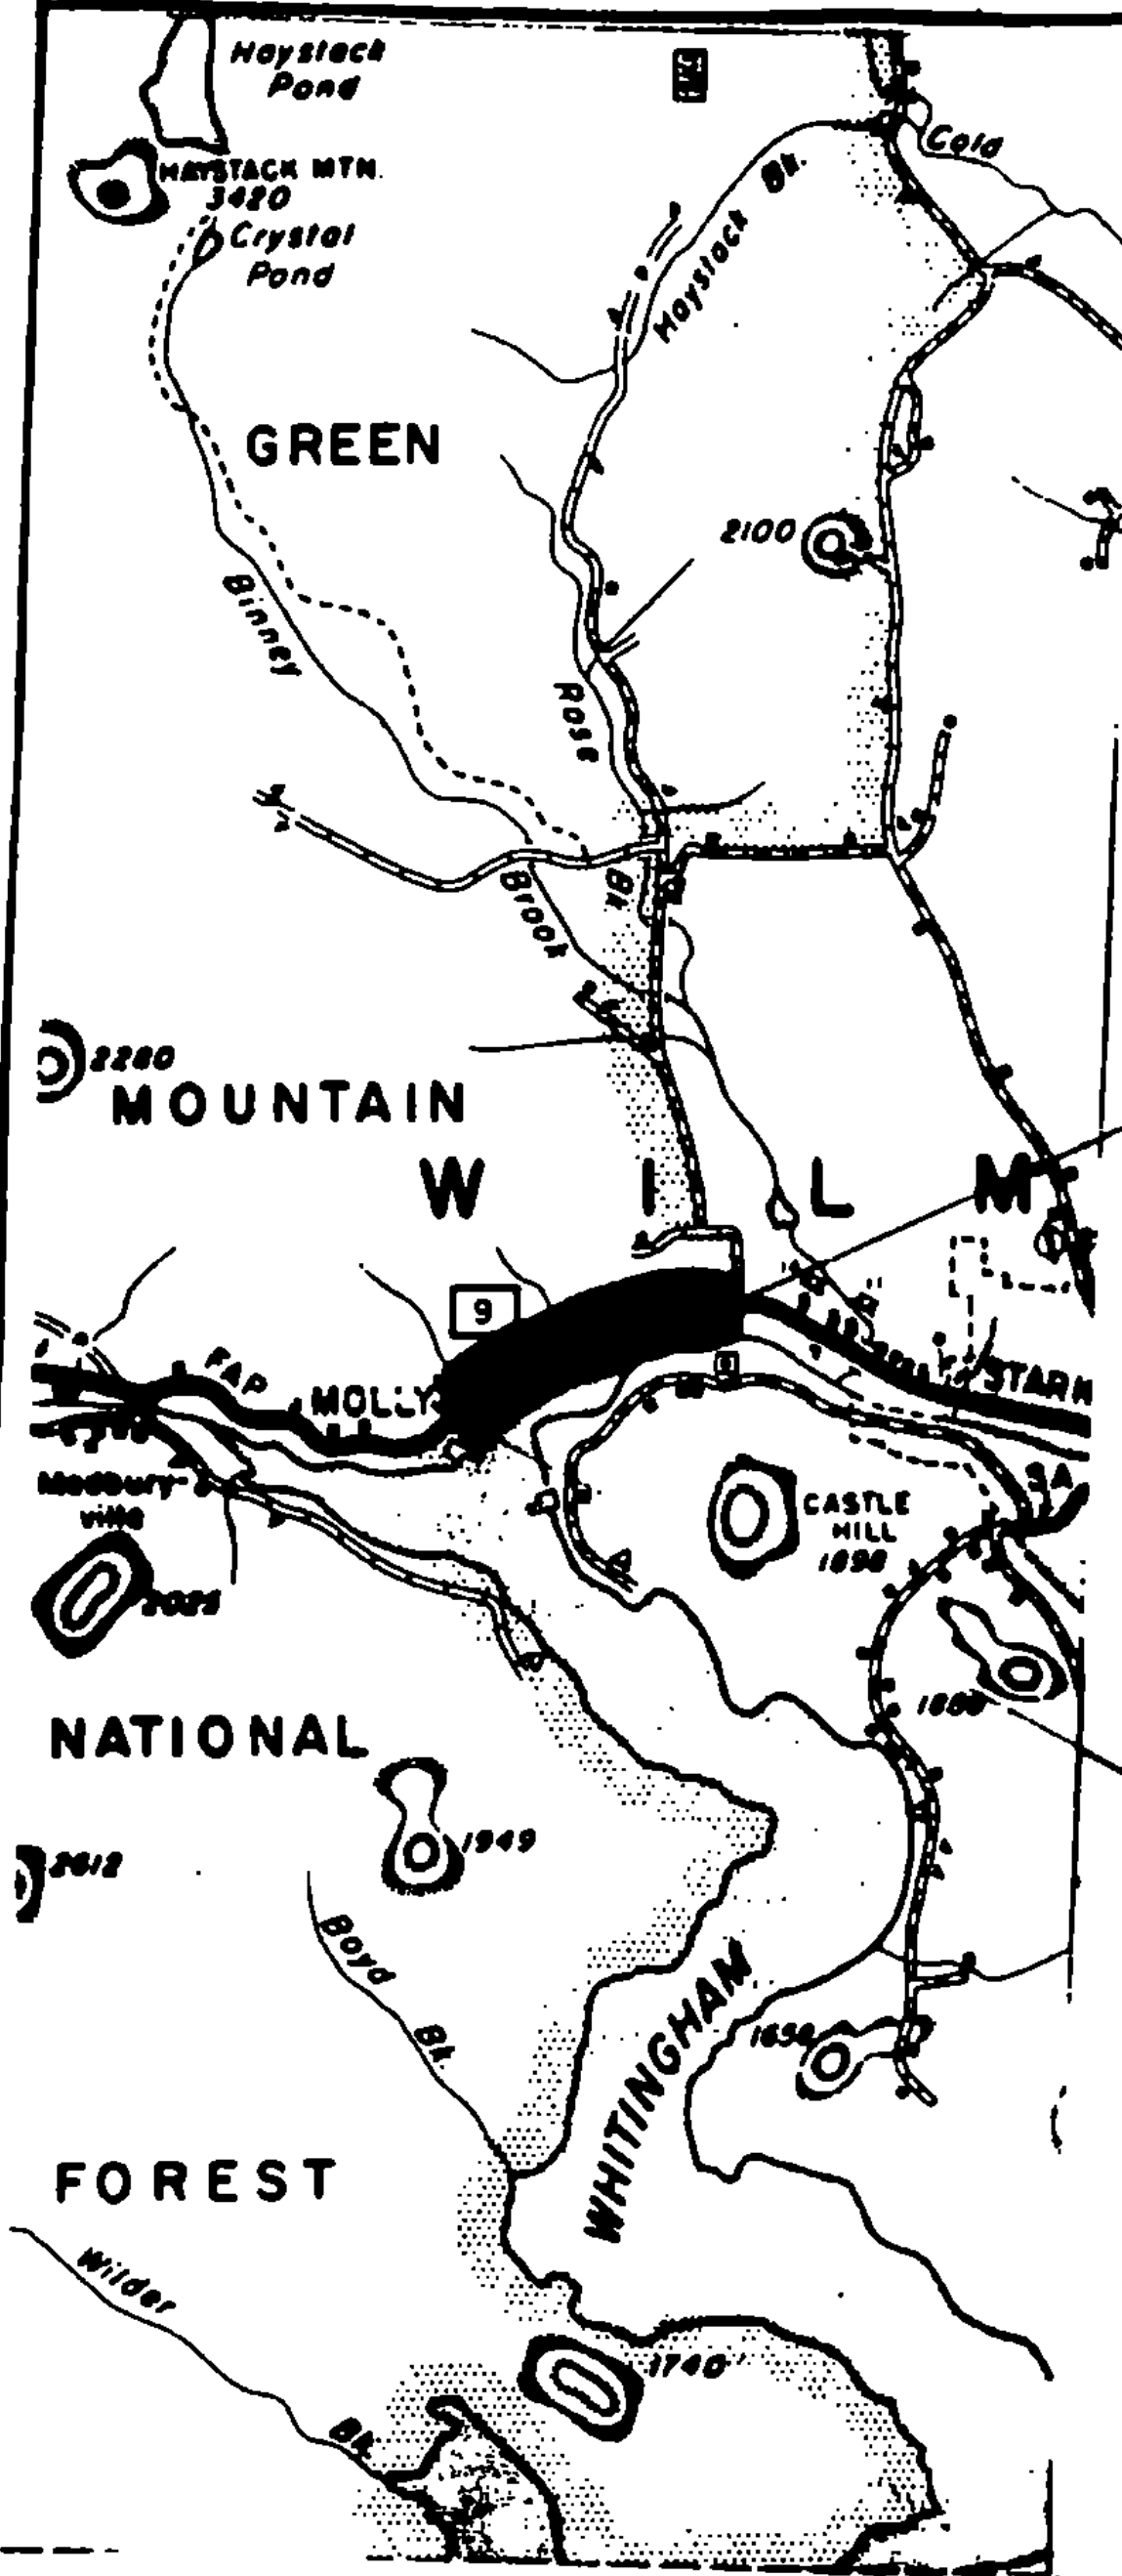


TRAFFIC DATA

1986 AADT = 2940
V = 50 MPH

END PROJECT HMA 2830
MM 1.978

PROJECT INCLUDES OVERLAYMENT OF
EXISTING BIT. CONC. PAVT. (SHOULDERS INCL.)
WITH 1 1/4" BIT. CONC. PAVT. EXISTING
GRAVEL SHOULDERS SHALL BE EXCAVATED,
FILLED WITH AGGREGATE SHOULDER MATERIAL
AND OVERLAYED WITH 1 1/4" BIT. CONC. PAVT.

BEGIN PROJECT HMA 2830
MM 1.270

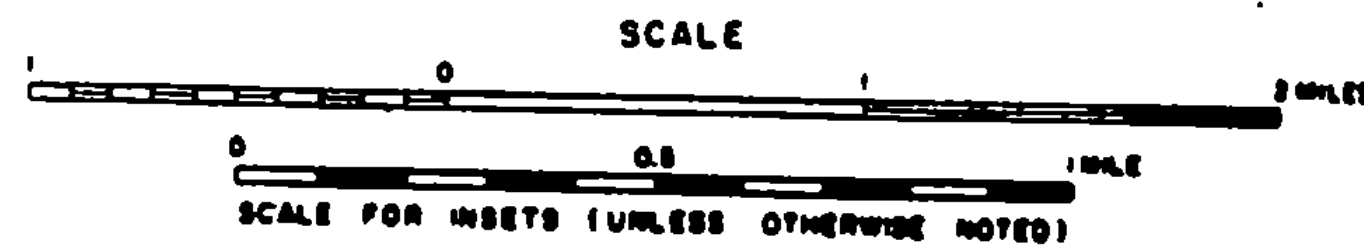

BEGINNING IN THE TOWN
OF WILMINGTON, ON VT. 9
AT MM 1.270 AND
EXTENDING EASTERLY 0.708
MILES, TO MM 1.978.

PROJECT LENGTH = 0.708 MI.
= 3738.24 FT.

PROJECT WILMINGTON

NO. HMA 2830 SHT. 32 OF 67
SHEET 3 OF 7 SHEETS