

STATE OF VERMONT

AGENCY OF TRANSPORTATION

Date

JAN 25 1988

F.W. Whitcomb CONSTRUCTION CORPORATION
Contractor

[Signature]

Signature

President

Title

[Signature]
Transportation Secretary's Signature



PROPOSED IMPROVEMENT

TOWN OF JAMAICA, MARLBORO, VERNON, WILMINGTON,
WINHALL

COUNTY OF BENNINGTON, WINDHAM

ROUTE NO. VT. RTS. 9, 30, & 142

ROUTE CLASS (F.A.P.-VT. 9, 30) (F.A.S.-VT. 142)

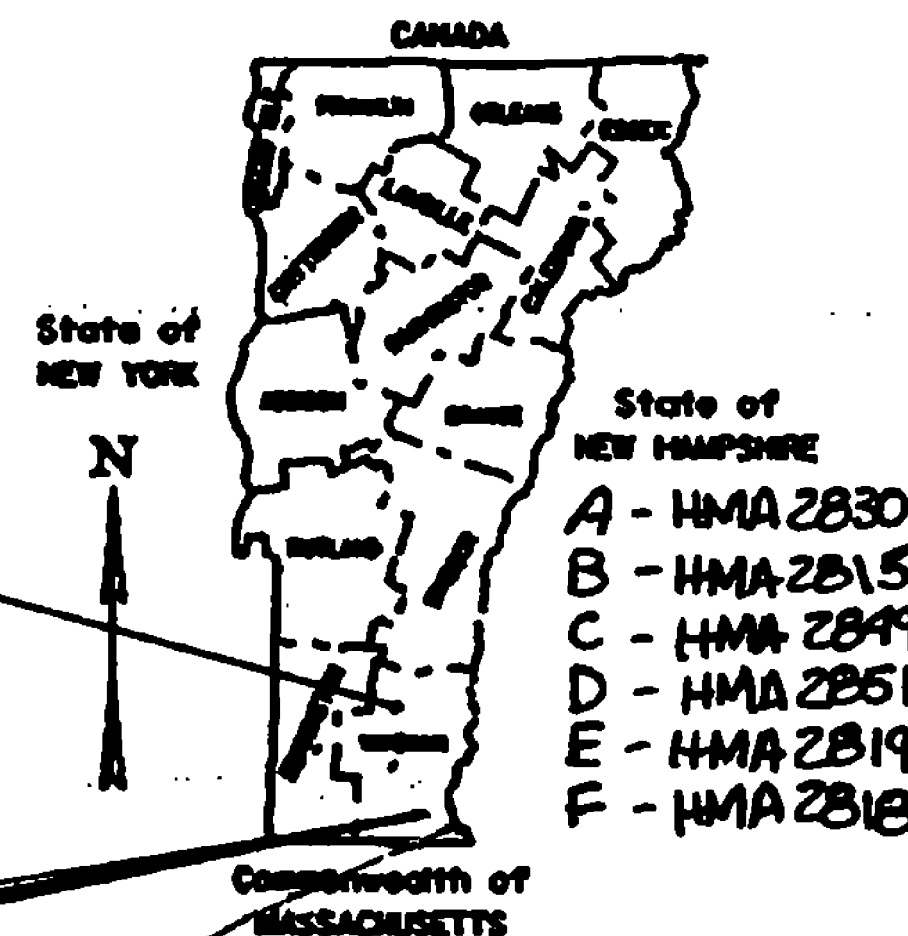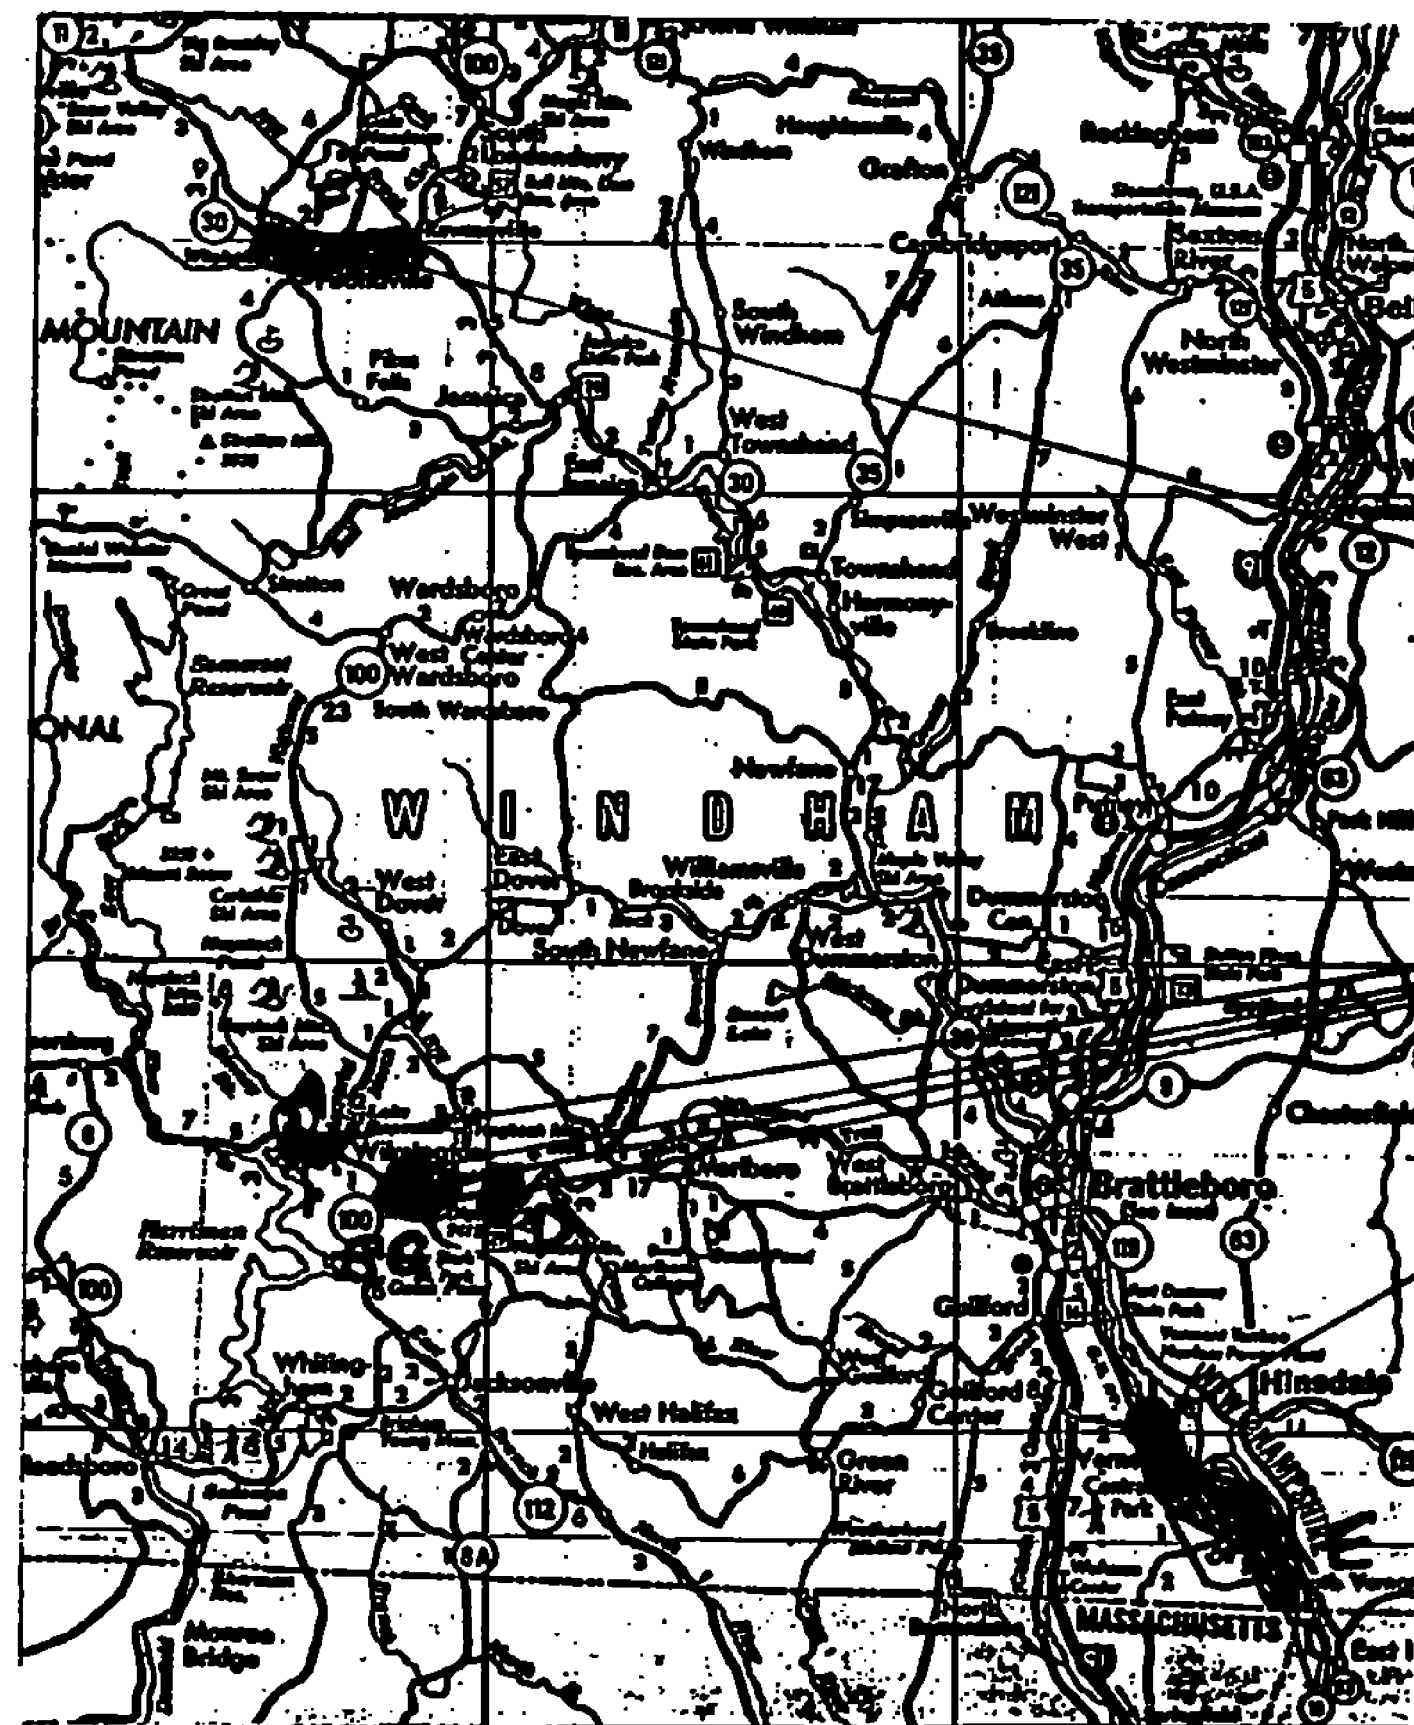

THESE PLANS ARE SUBJECT TO SUCH ENGINEERING CHANGES AS MAY BE REQUIRED BY THE FEDERAL HIGHWAY ADMINISTRATION OR THE CHIEF ENGINEER. CONSTRUCTION IS TO BE CARRIED ON IN ACCORDANCE WITH THESE PLANS AND THE STANDARD SPECIFICATIONS FOR CONSTRUCTION DATED 1986, AS APPROVED BY THE FEDERAL HIGHWAY ADMINISTRATION ON NOVEMBER 3, 1985 FOR USE ON THIS PROJECT, INCLUDING ALL SUBSEQUENT REVISIONS AND SUCH REVISED SPECIFICATIONS AND SPECIAL PROVISIONS AS ARE INCORPORATED IN THESE PLANS.

SUBMITTED BY ORDER OF THE STATE TRANSPORTATION BOARD

APPROVED David B. Kelly DATE 8/25/87
CHIEF ENGINEER

DEPARTMENT OF TRANSPORTATION
FEDERAL HIGHWAY ADMINISTRATION

APPROVED _____ DATE _____
DIVISION ADMINISTRATOR

PROJECT HMA # DIST. #2 PAVING

SHEET 1 OF 64 SHEETS

FOR INDEX OF SHEETS, SEE SHEET 2