


PAVING LIMITS FOR TOWN ROADS & DRIVES


PAVING LIMITS FOR TOWN ROADS

TRAVEL LANE

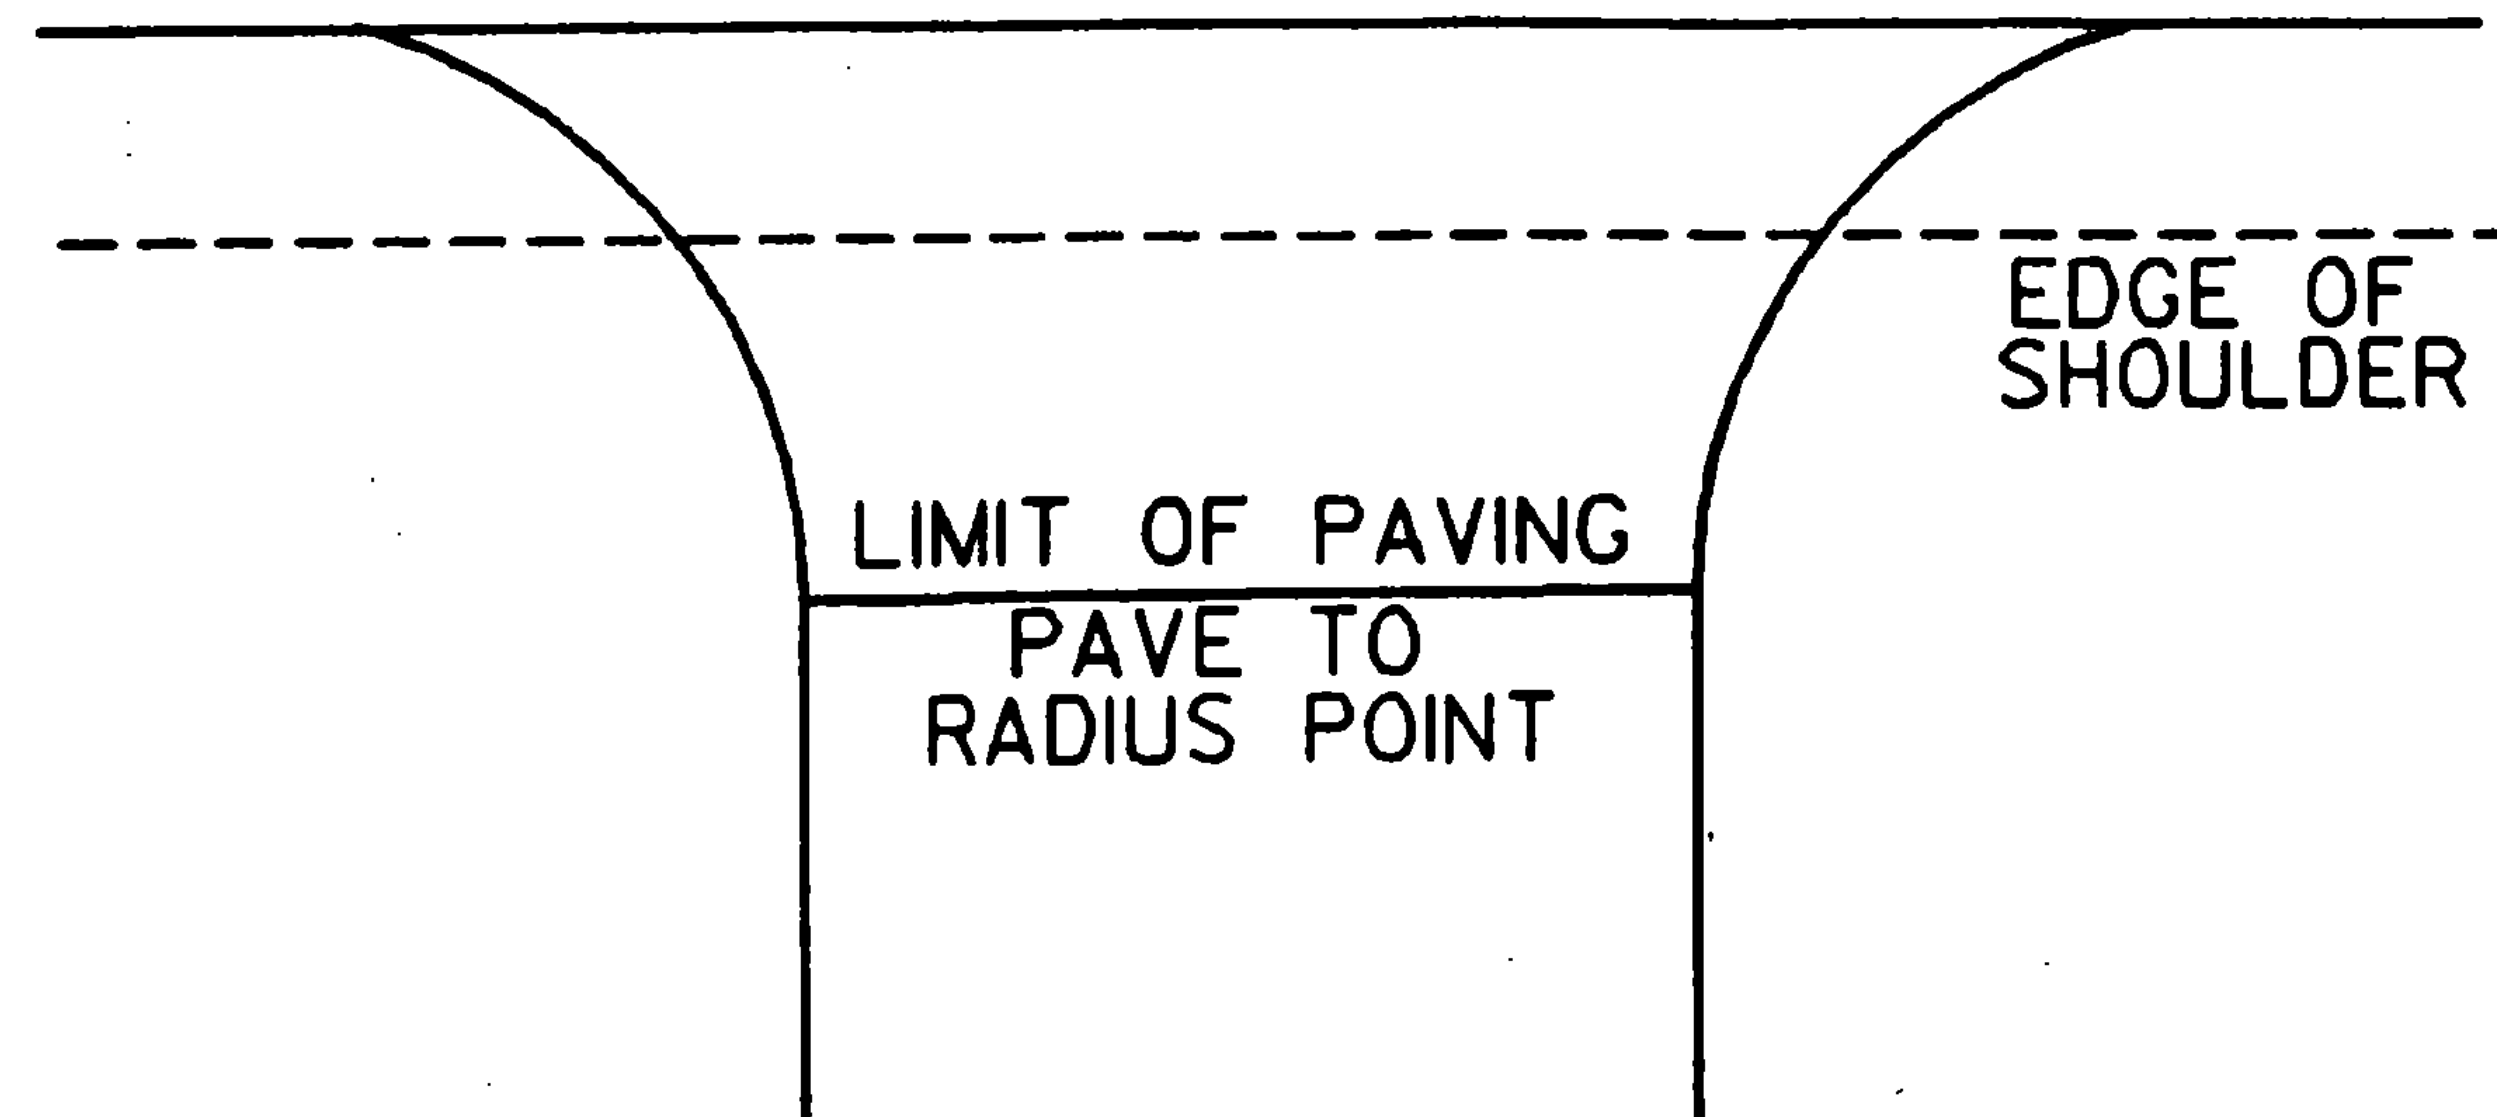

PAVING LIMITS FOR DRIVES

TRAVEL LANE

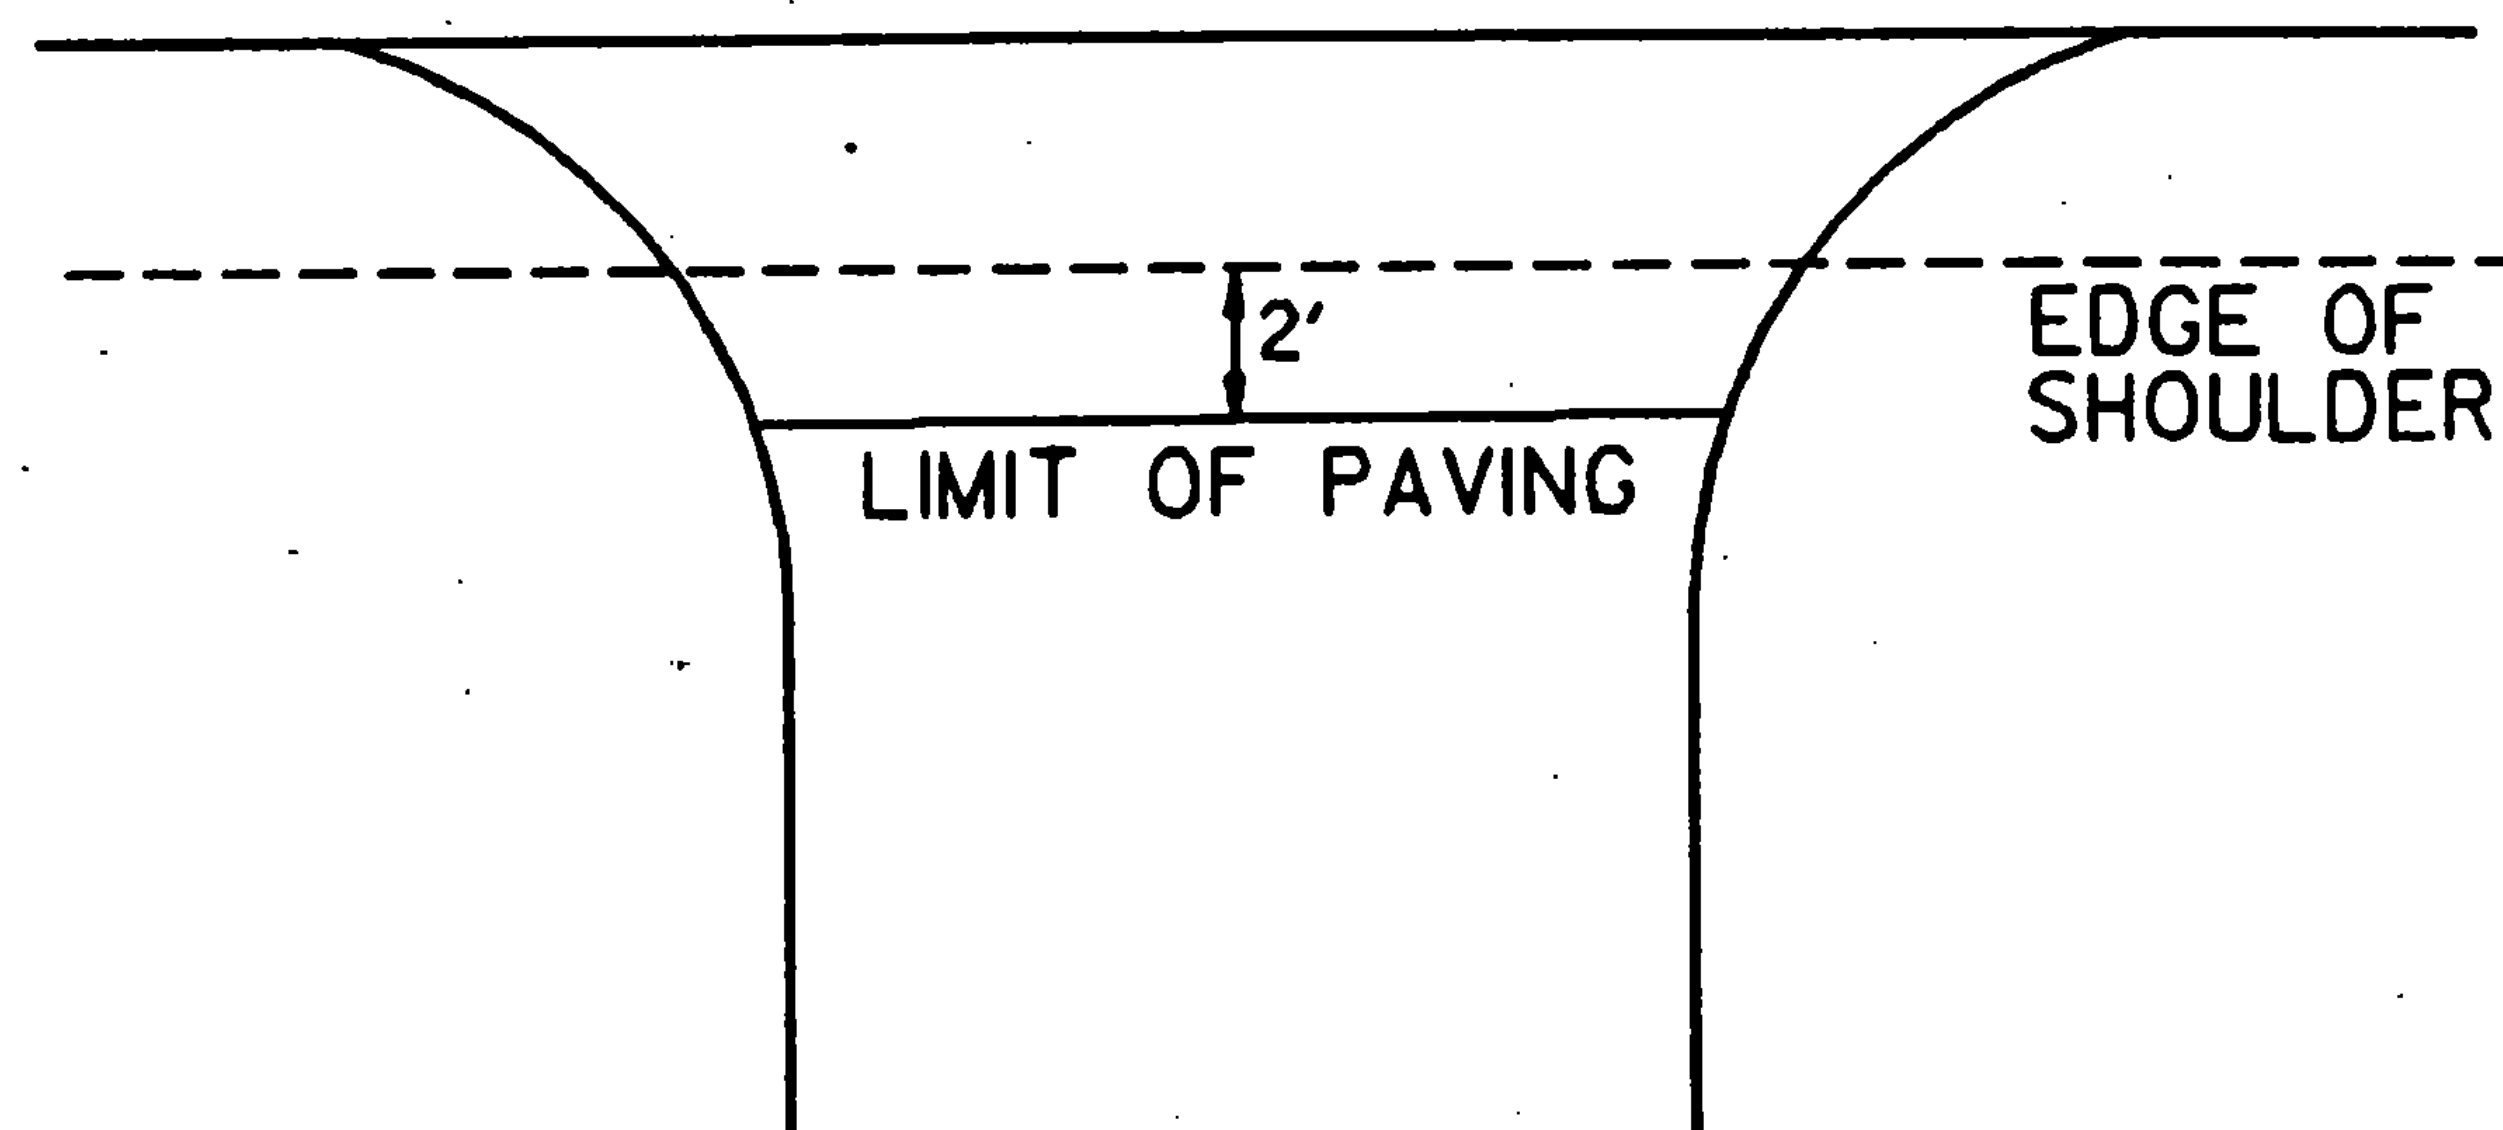

PROJECT 1987 DIST. 2 PAVING

NO. HMA PROJECTS

SHEET 6 OF 64 SHEETS