


TYPICAL SECTIONS & DESIGN DATA

BITUMINOUS CONCRETE PAVEMENT

TYPE IV MIX WILL BE USED FOR LEVELING
UNLESS OTHERWISE DETERMINED BY THE
RESIDENT ENGINEER.

1 1/4" WEARING COURSE, TYPE III

TYPE IV MIX (28' WIDE @ 250 TONS/MI.)

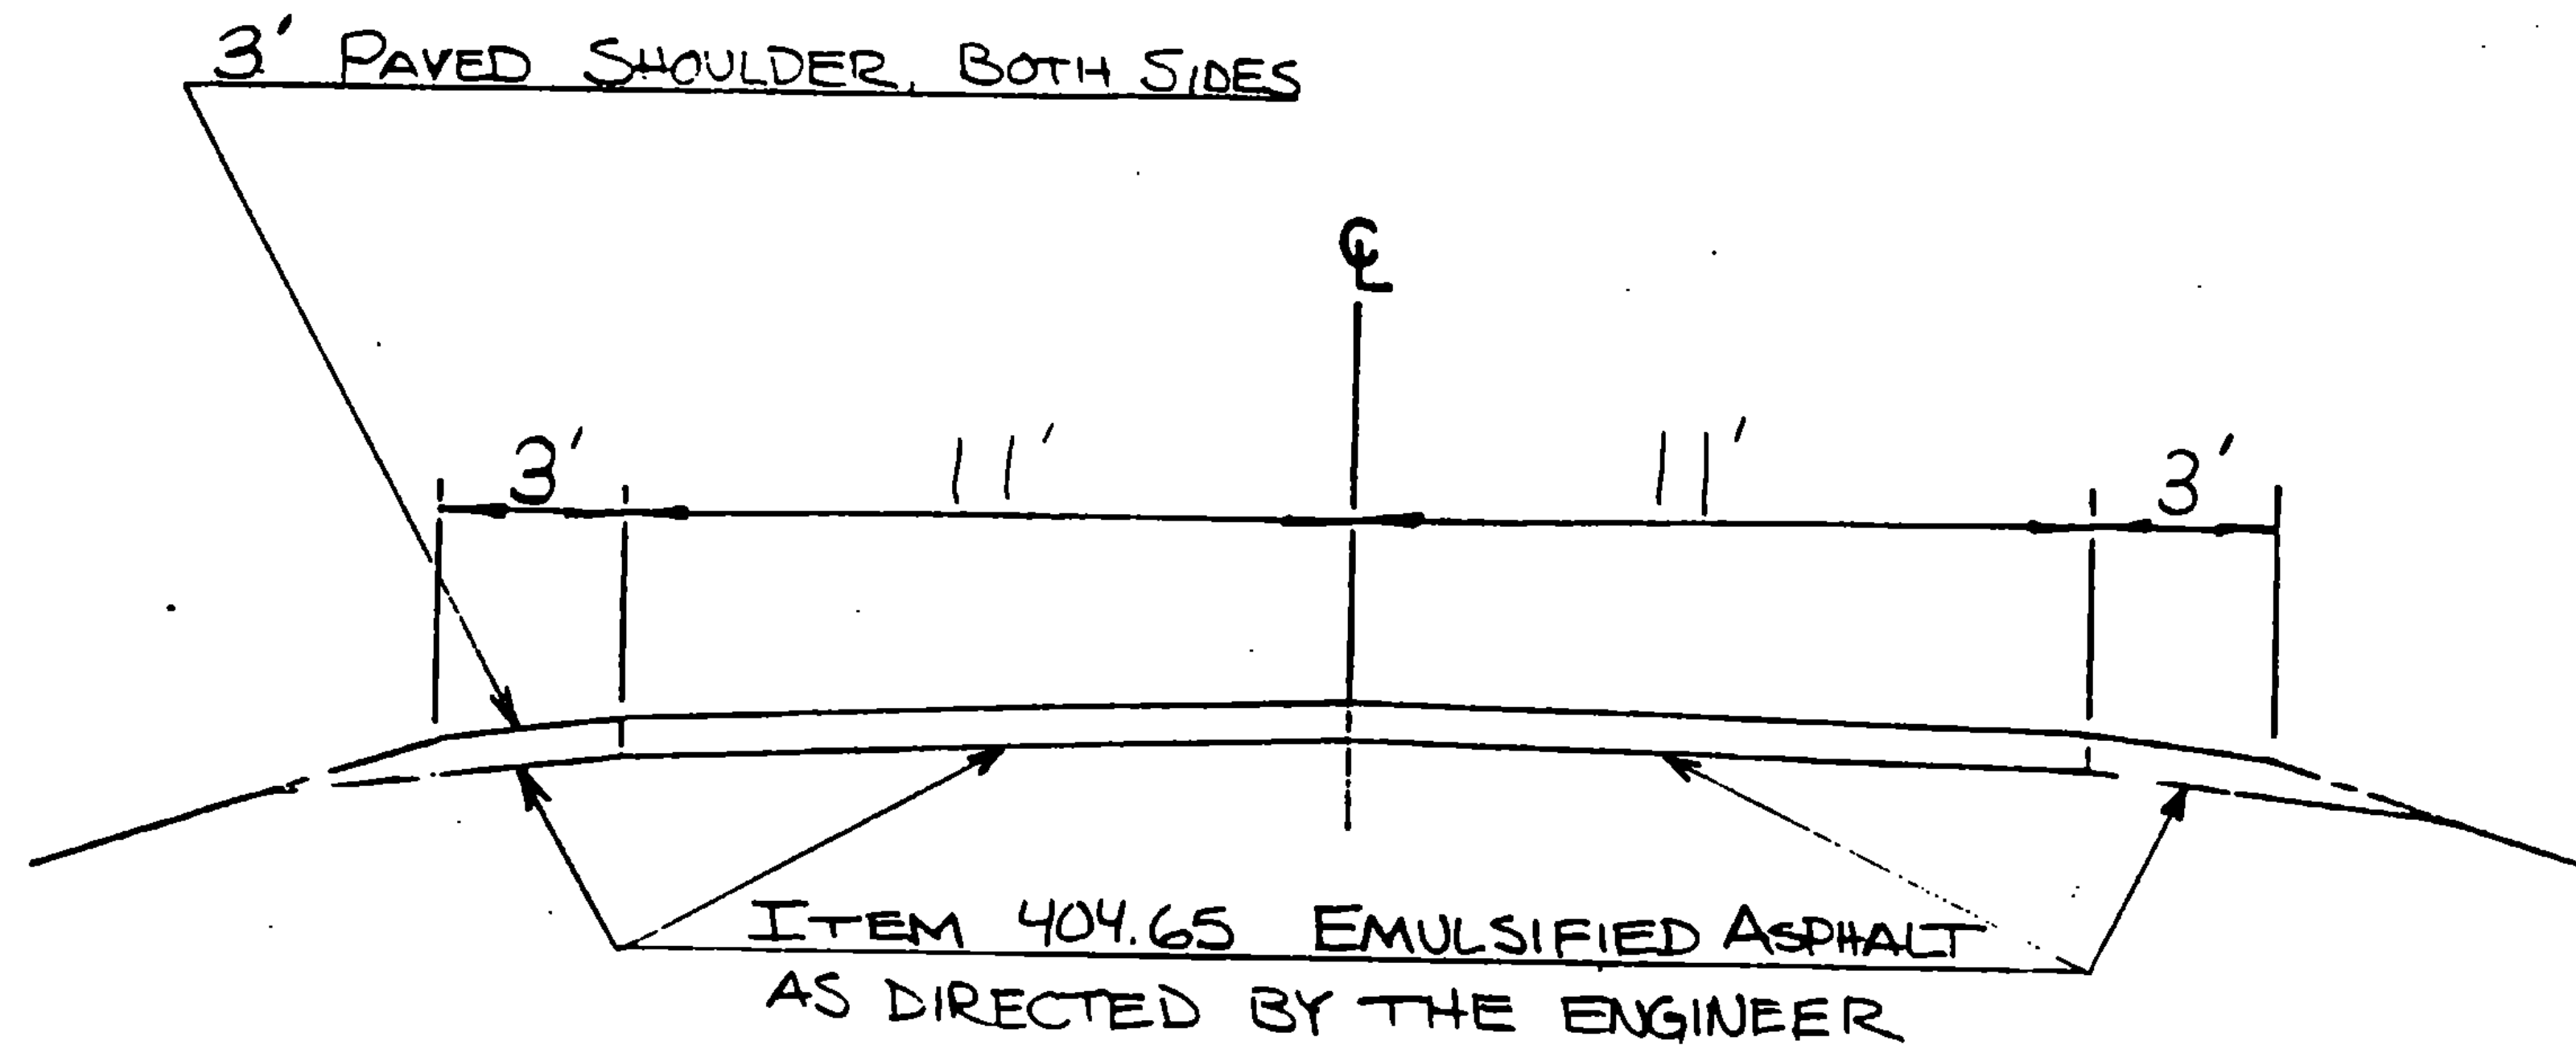

JAMAICA MM 8.825 ~ JAMAICA MM 9.220

JAMAICA MM 9.450 ~ JAMAICA MM 9.746

JAMAICA MM 9.766 ~ WINHALL MM 0.000

PROJECT - JAMAICA - WINHALL

~~SHEET 12 OF 64 SHEETS~~
NO. HMA 2818
~~SHEET 4 OF 10 SHEETS~~