


TYPICAL SECTIONS & DESIGN DATA

WINHALL 0.000 ~ 0.272
ITEM 406.25 BITUMINOUS CONCRETE PAVEMENT
LEVELING COURSE TYPE IV (250 TONS/MILE)
1 1/4" WEARING COURSE TYPE III ($\pm 1/4"$)
AS DIRECTED BY THE ENGINEER

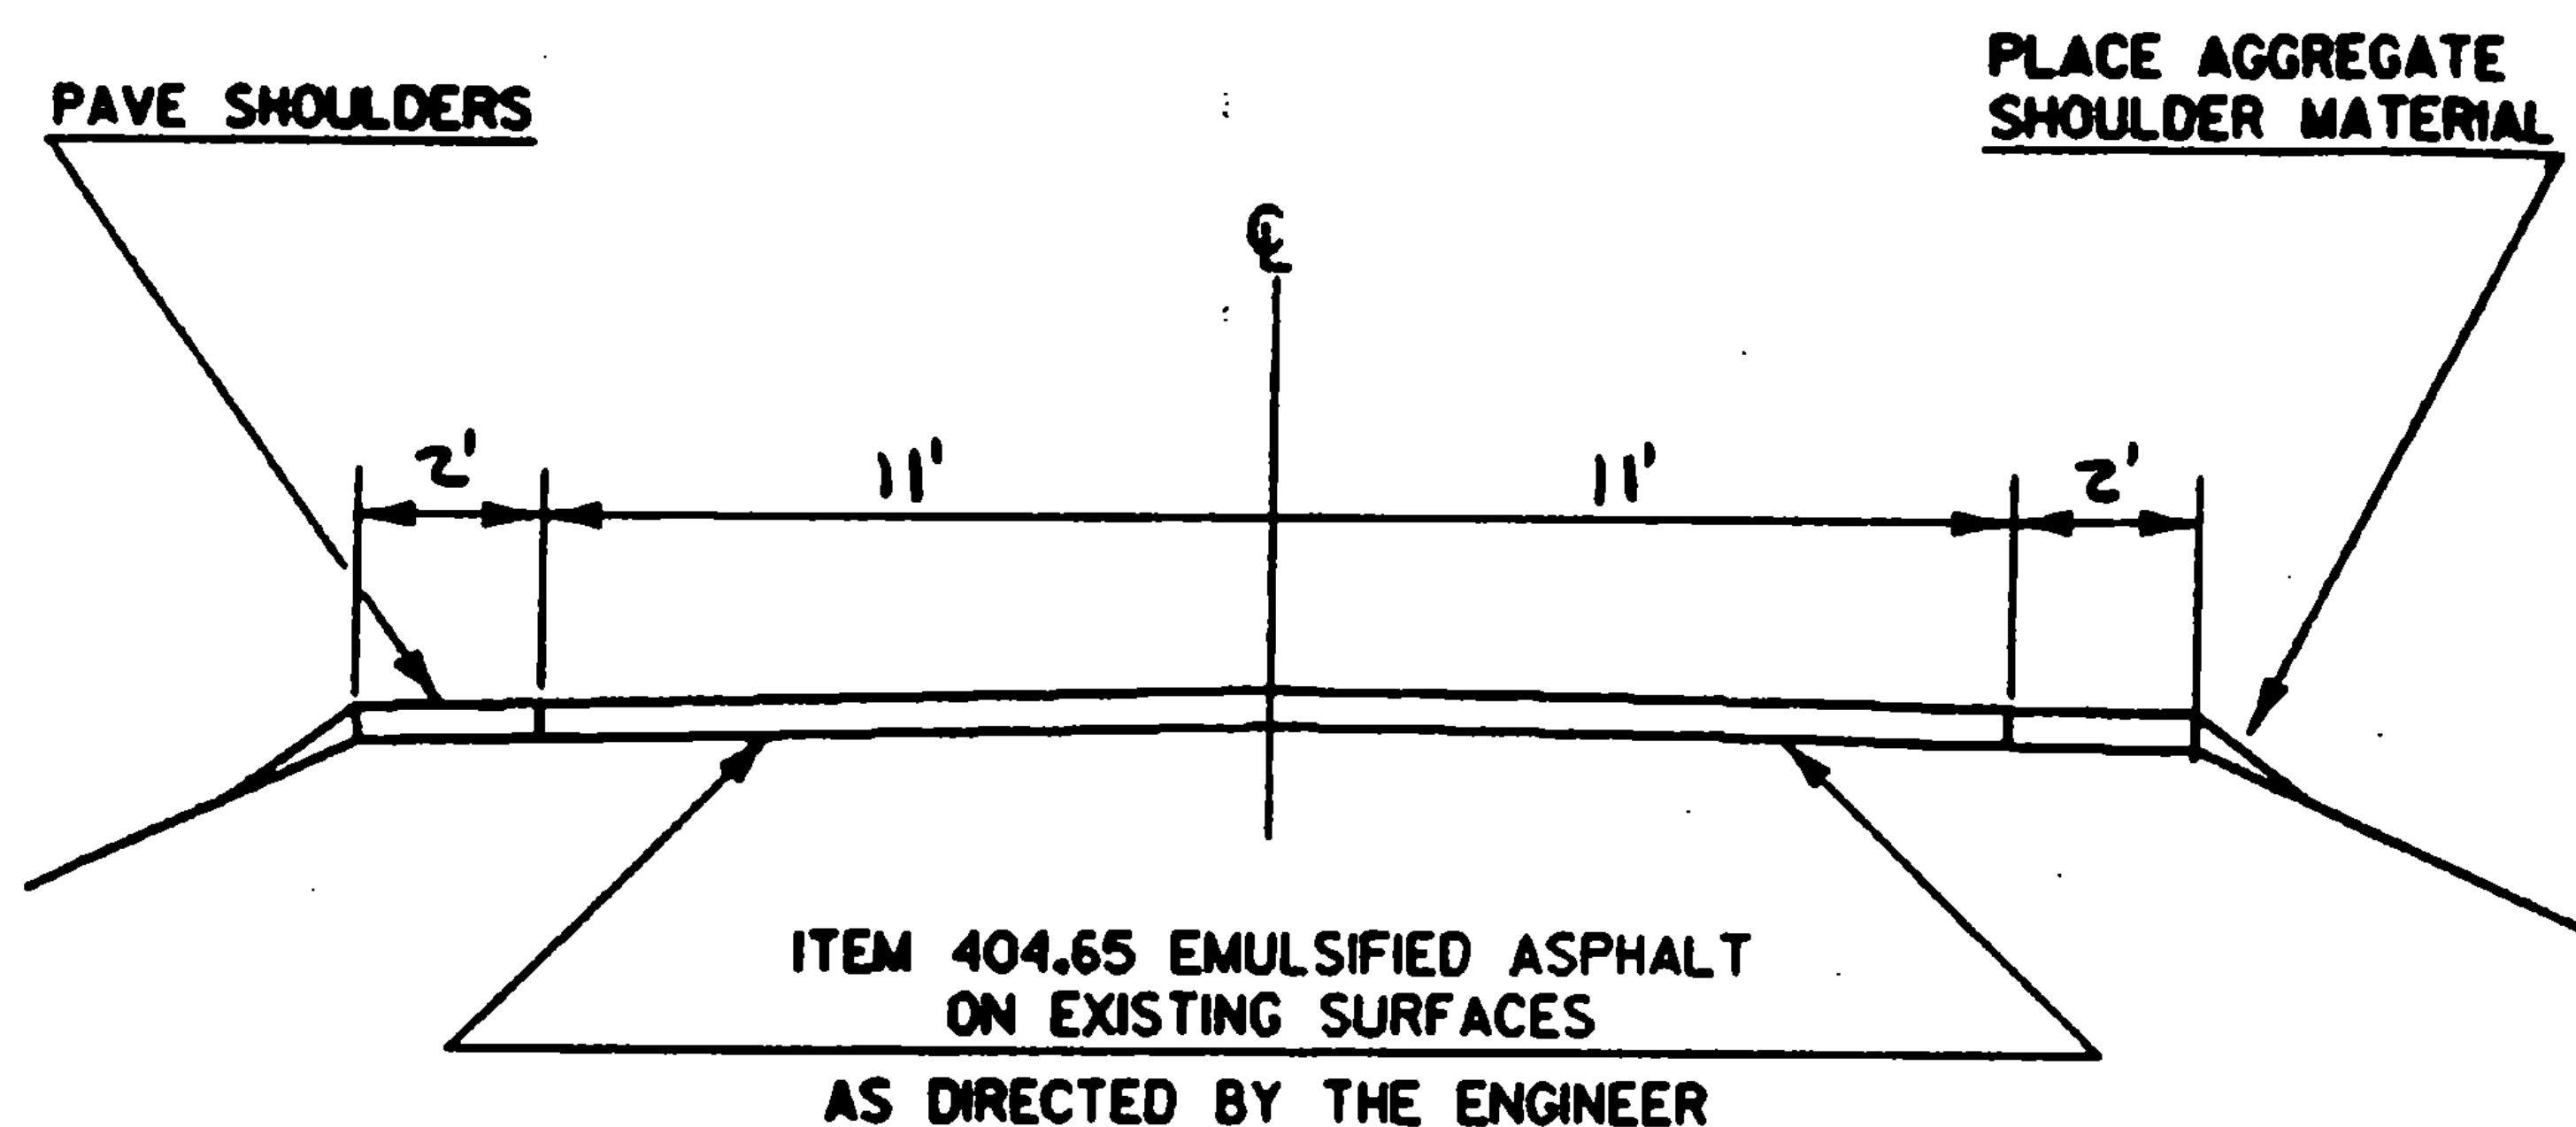

PROJECT JAMAICA-WINHALL

NO. HMA 2818
SHEET 13 OF 64 SHEETS
SHEET 5 OF 10 SHEETS