


PAYEMENT MARKING DETAIL SHEET

* SEE STANDARD
E-50 FOR
LETTERING DIMENSIONS.

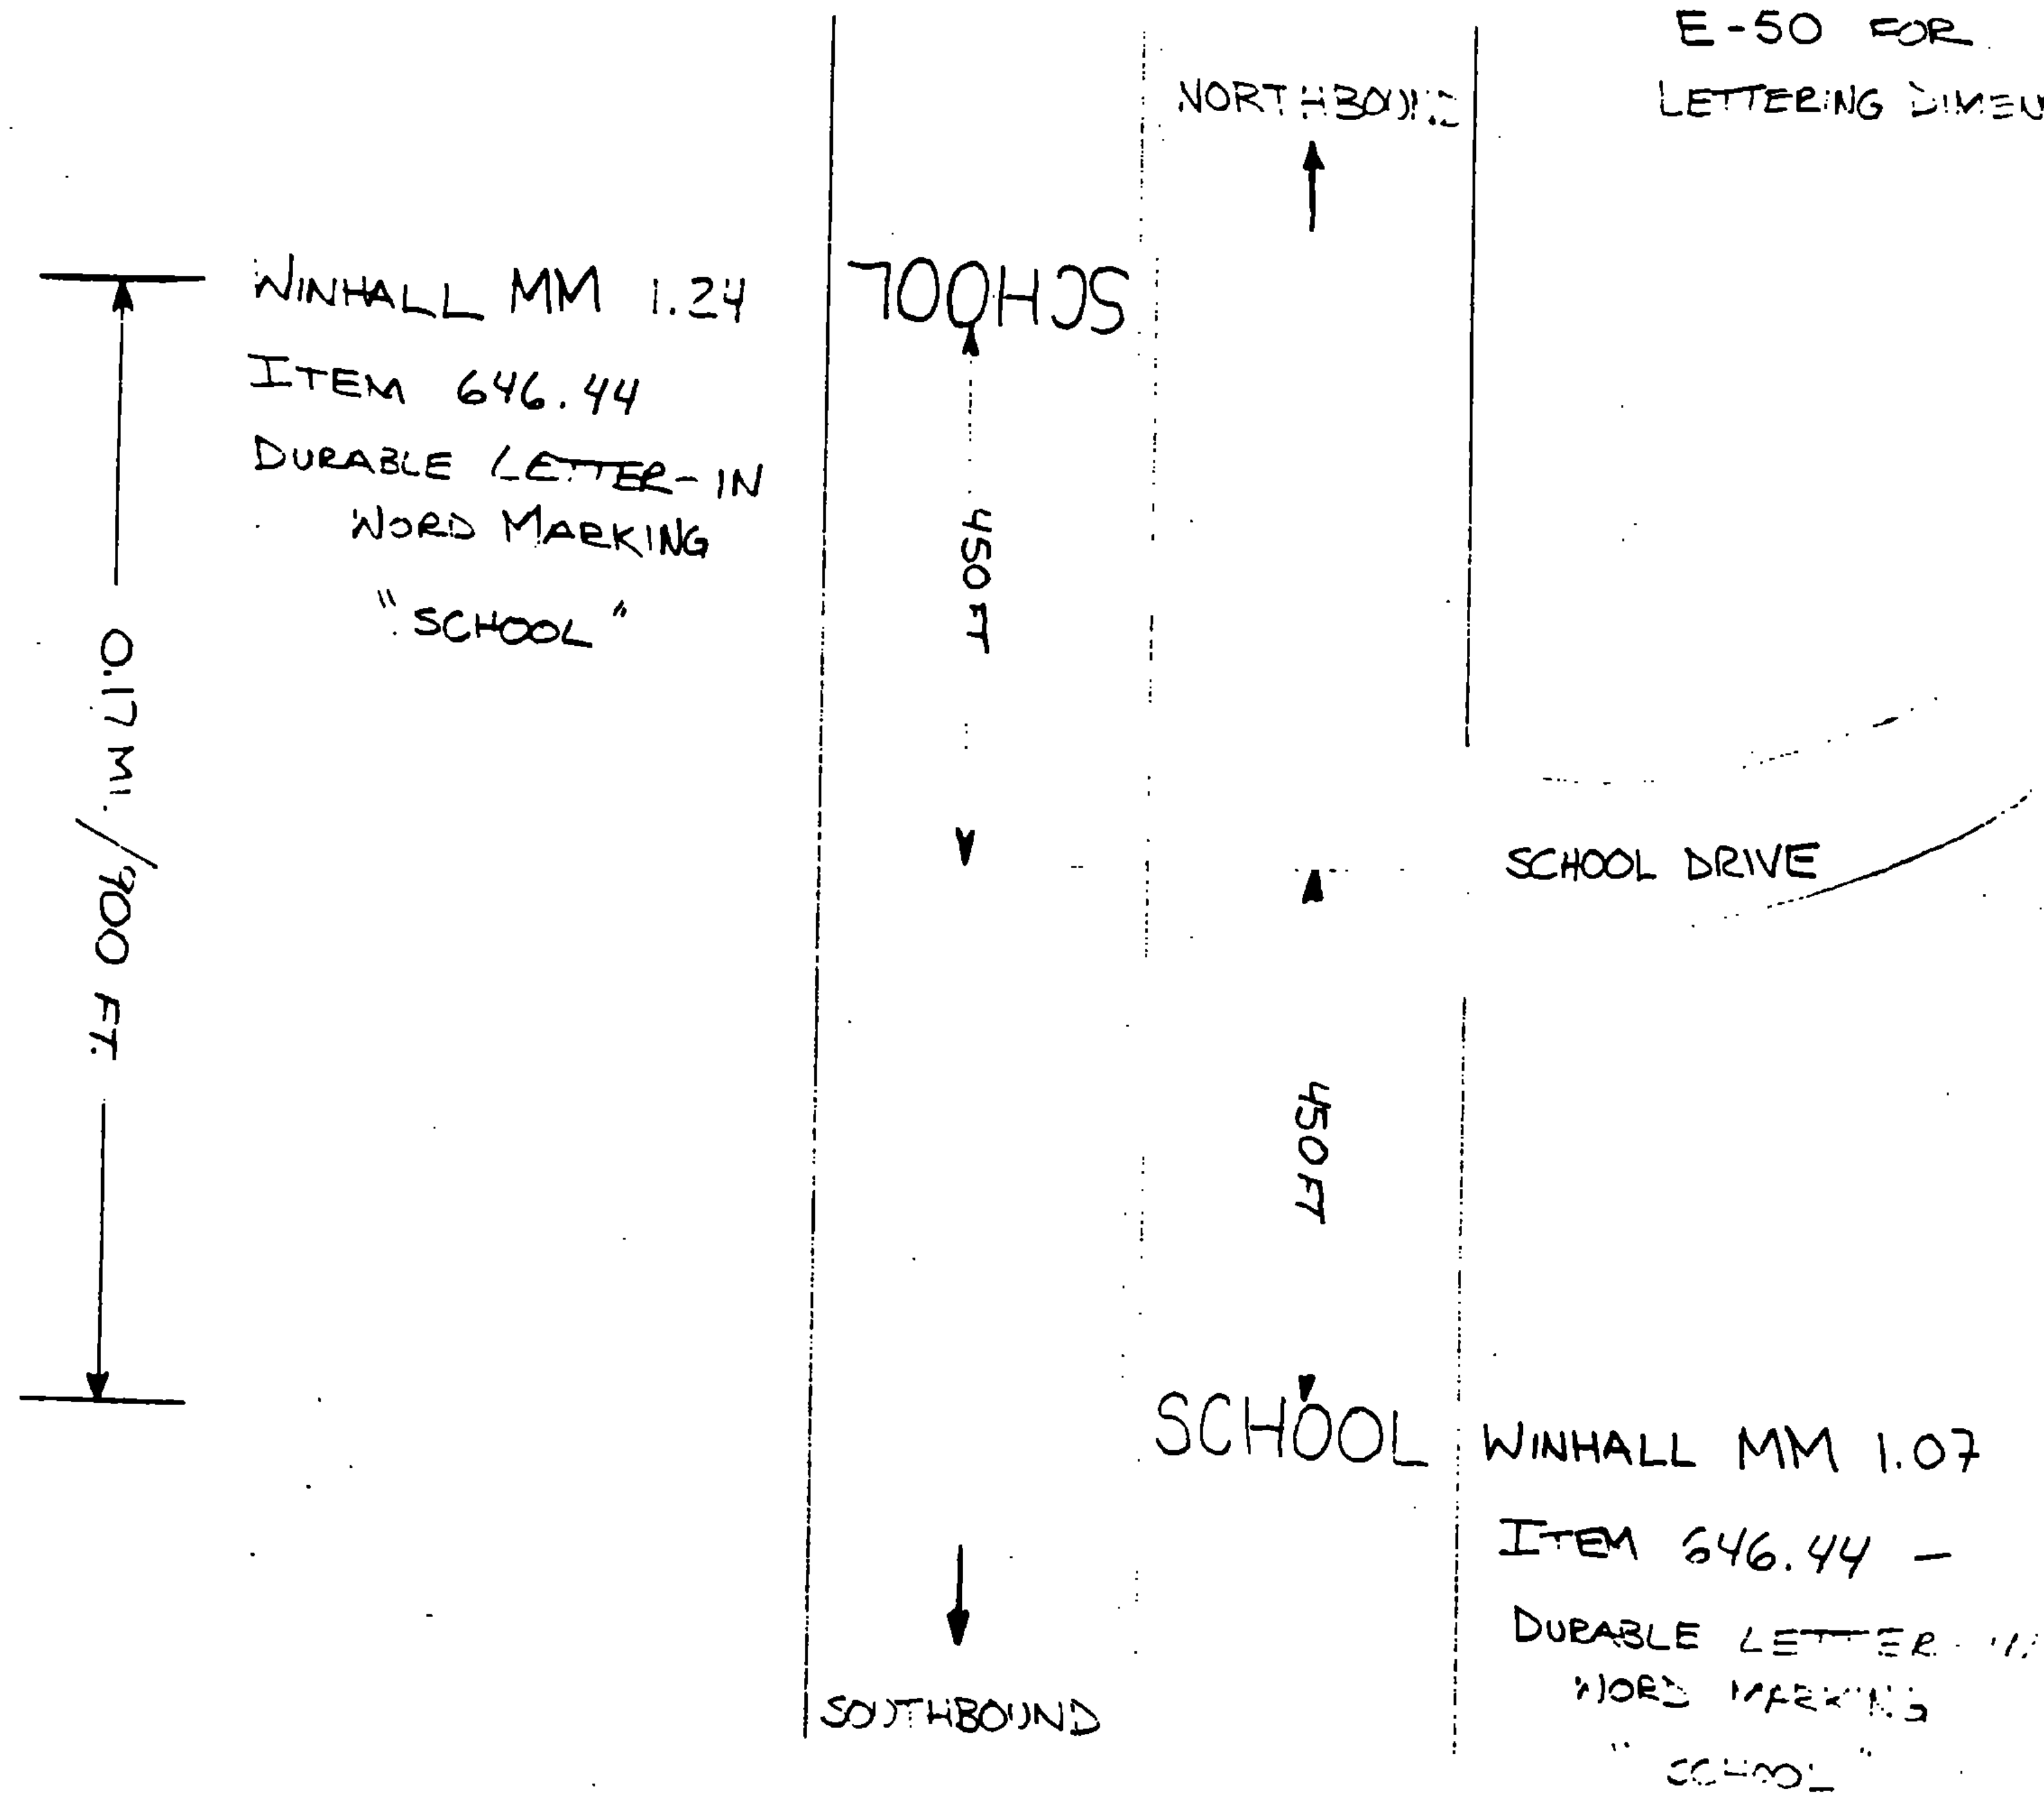

NOTE: DRAWING NOT TO SCALE

PROJECT JAMAICA - WINHALL

NO. HMA 818
SHT. 18 OF 64 SHTS.
SHT. 10 OF 10 SHTS.