
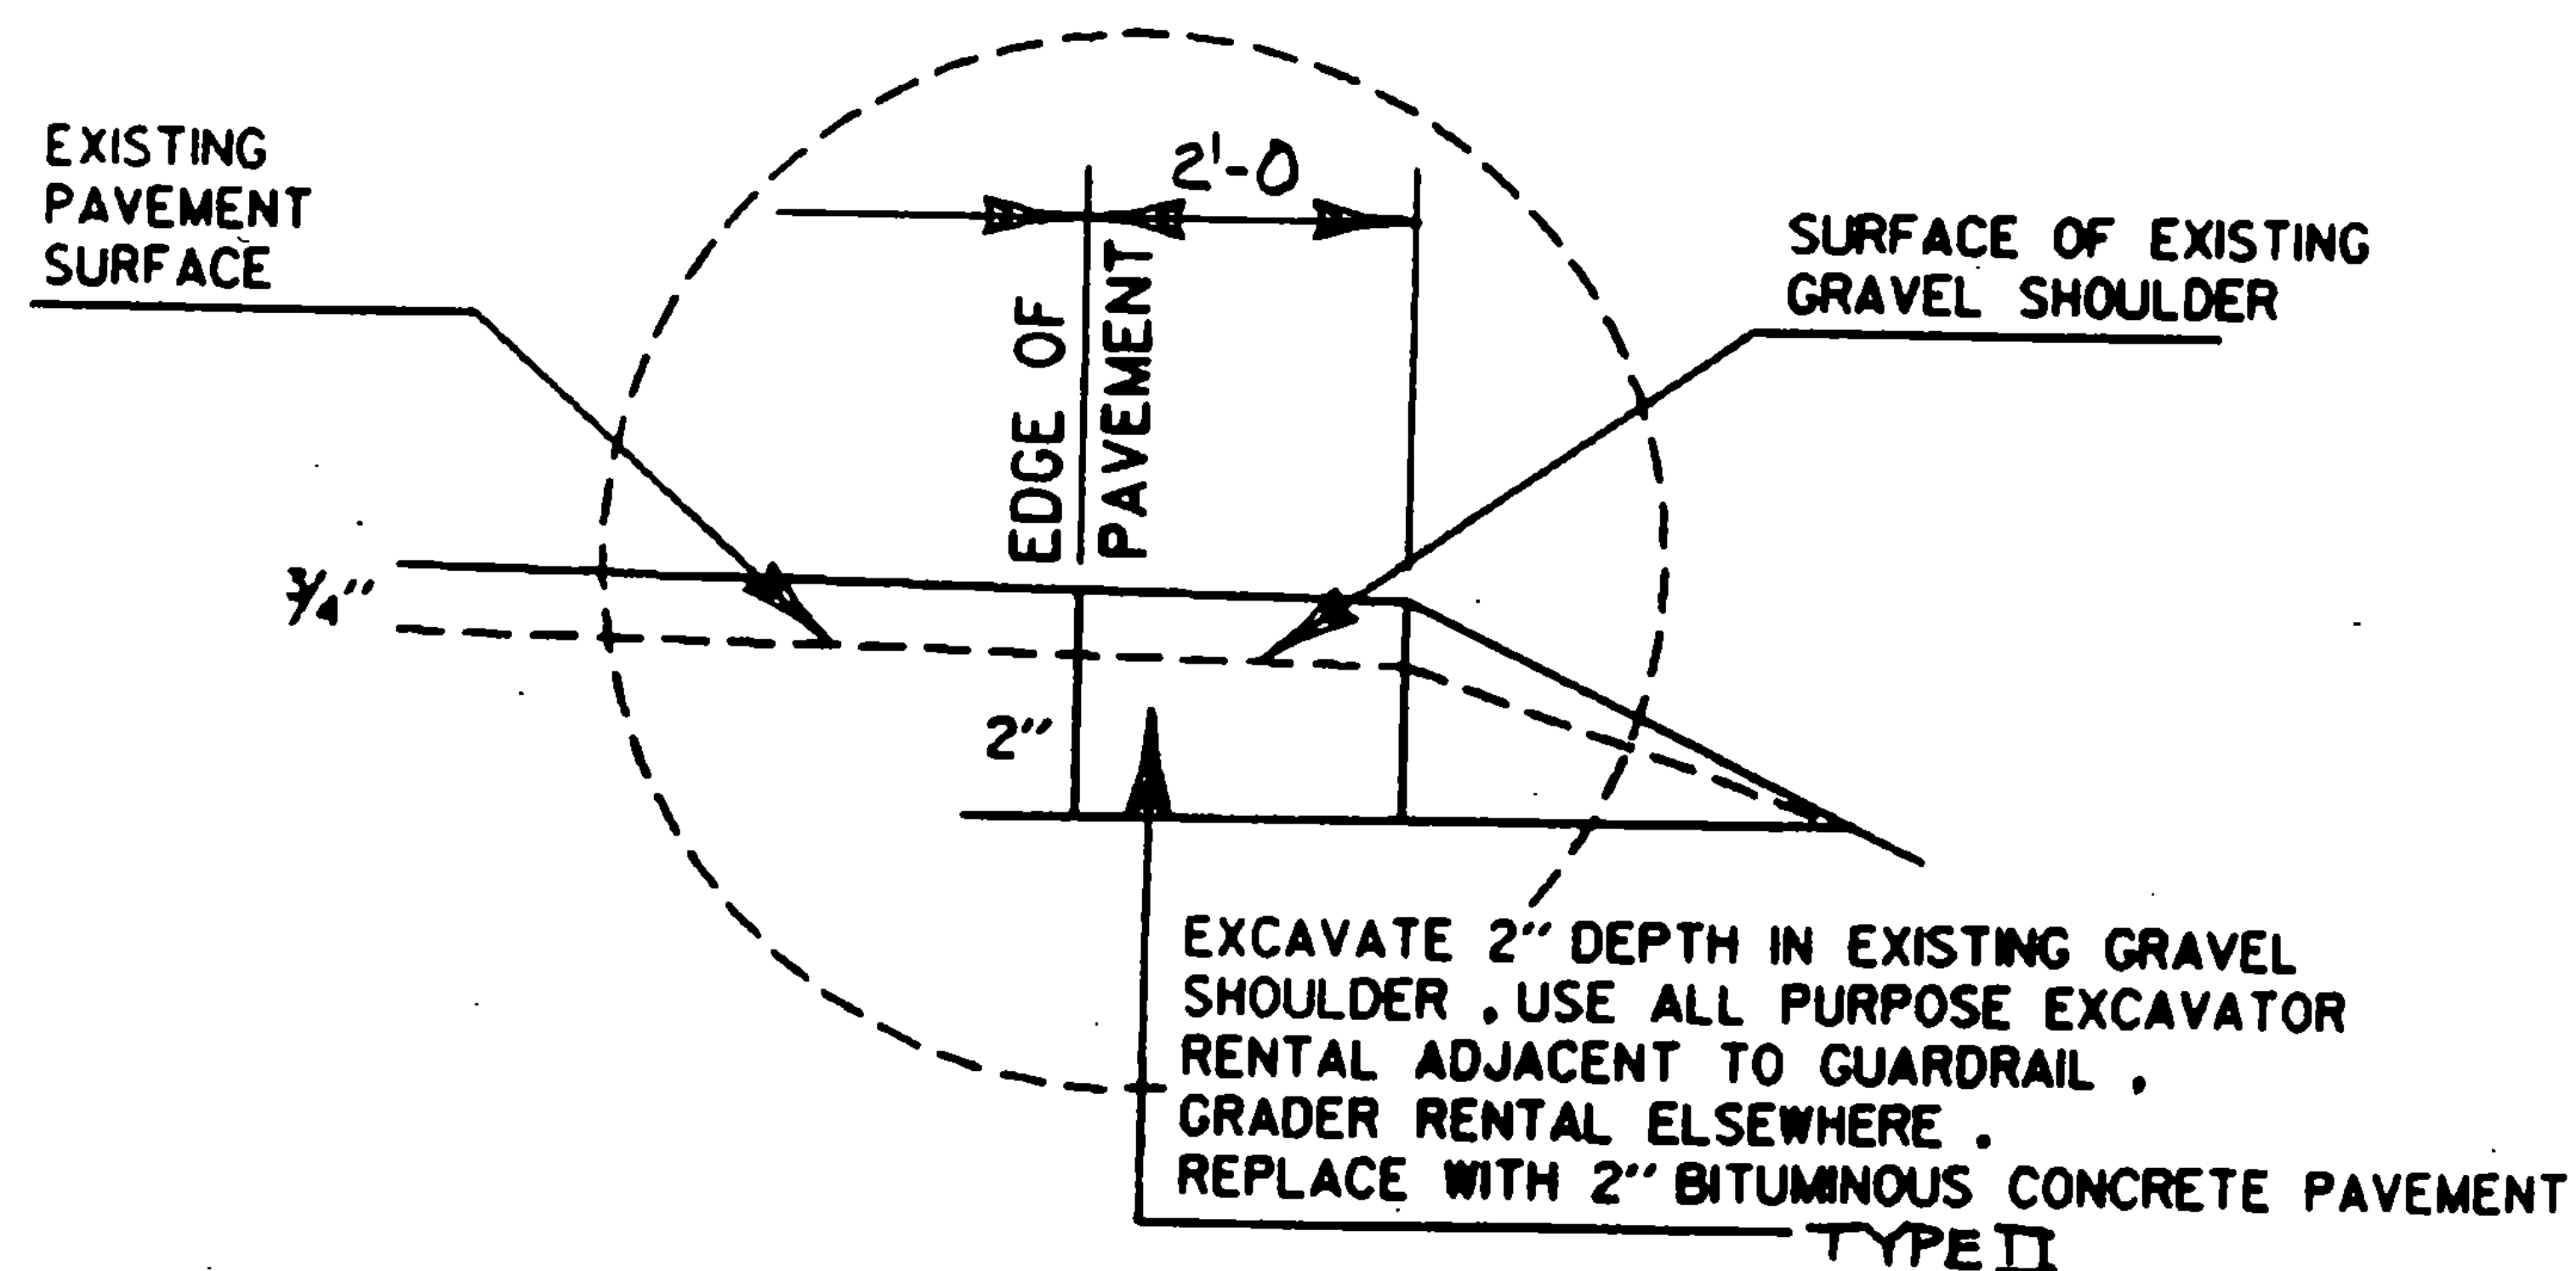


TYPICAL SECTIONS & DESIGN DATA

VERNON MM 3.62 ~ MM 3.73
 ITEM 406.25 BITUMINOUS CONCRETE PAVEMENT
 LEVELING COURSE TYPE IV (477 TONS/MILE)
 1 1/4" WEARING COURSE TYPE III ($\pm 1/4"$)
 AS DIRECTED BY THE ENGINEER

*NOTE: EXISTING RT. SHOULDER IS PAVED.
 DETAILED BLOW-UP BELOW
 APPLIES TO LEFT SHOULDER
 ONLY.

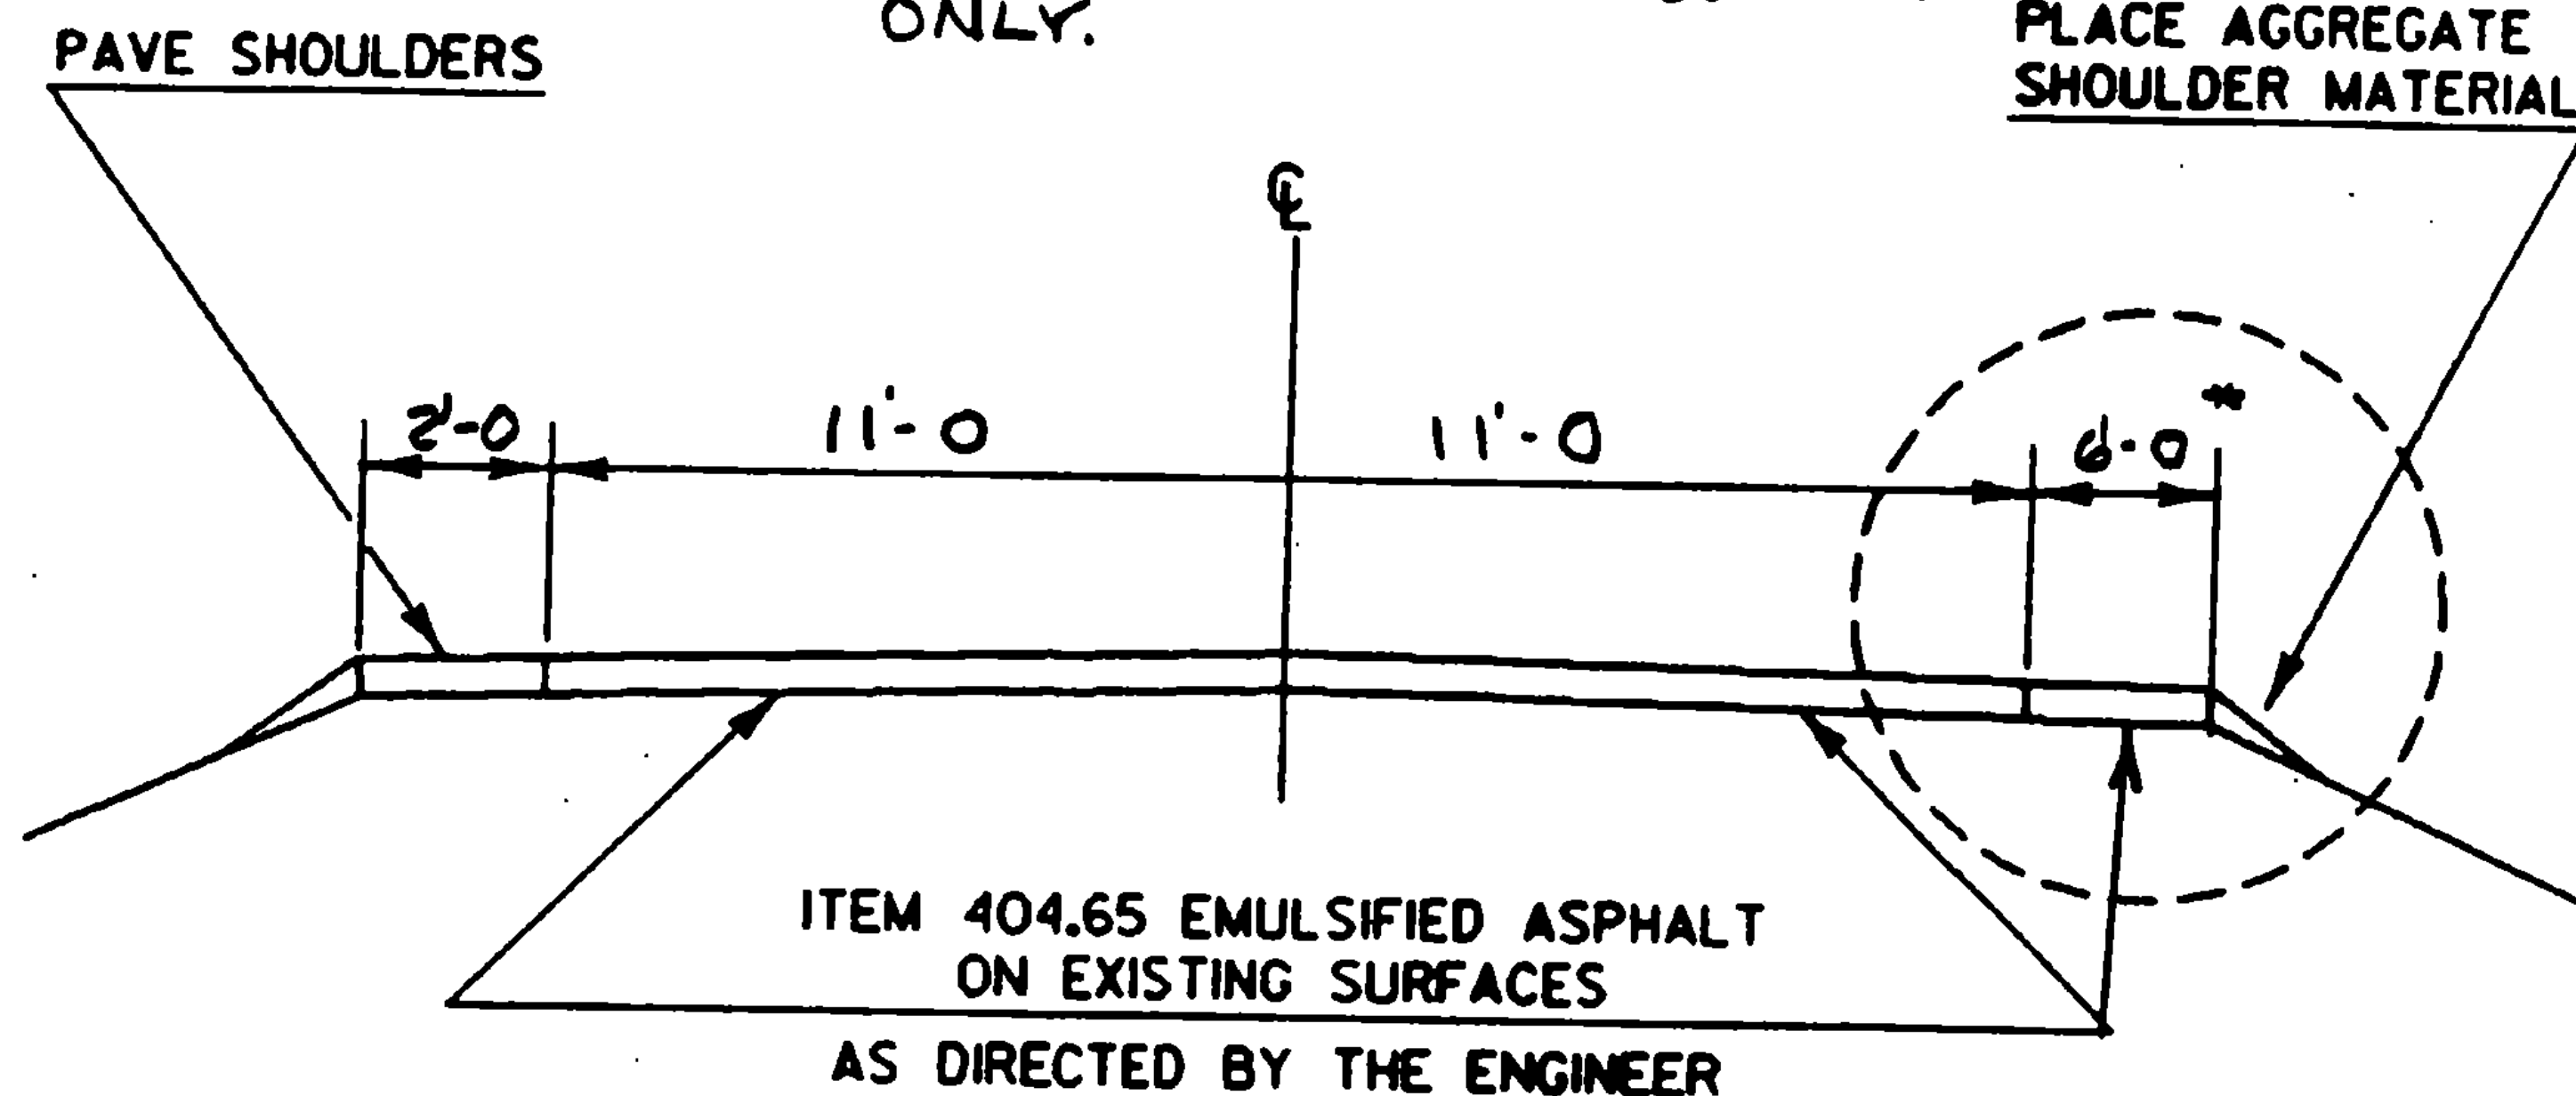

PROJECT Vernon

NO. HMA 2819

SHEET 6 OF 10 SHEETS

SHEET 25 OF 64 SHEETS