


STATE OF VERMONT
AGENCY OF TRANSPORTATION

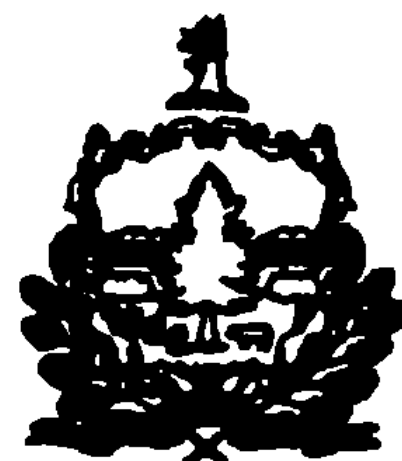



PROPOSED IMPROVEMENT

TOWN OF WILMINGTON

COUNTY OF WINDHAM

ROUTE NO. VT. RT. 9

ROUTE CLASS F.A.P.

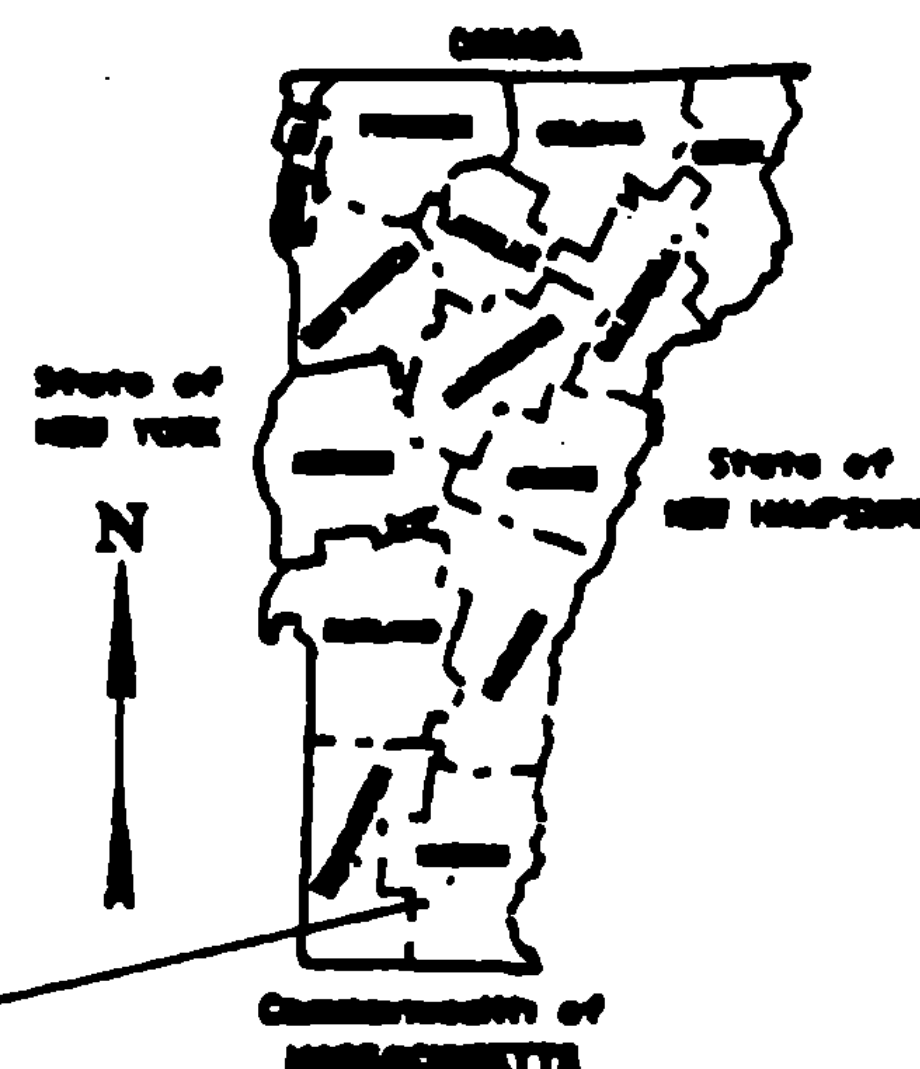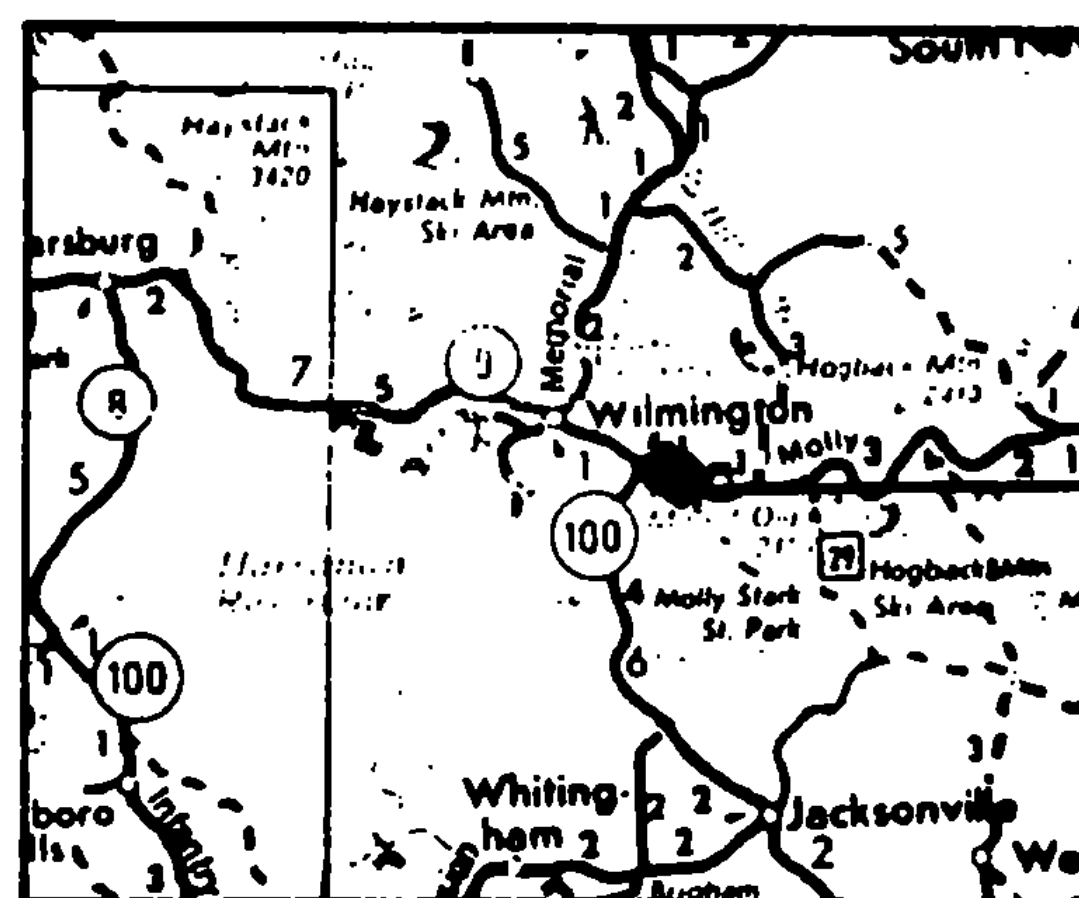

PROJECT
HMA 2849

THESE PLANS ARE SUBJECT TO SUCH ENGINEERING CHANGES AS MAY BE REQUIRED BY THE FEDERAL HIGHWAY ADMINISTRATION OR THE CHIEF ENGINEER. CONSTRUCTION IS TO BE CARRIED ON IN ACCORDANCE WITH THESE PLANS AND THE STANDARD SPECIFICATIONS FOR CONSTRUCTION DATED 1966, AS APPROVED BY THE FEDERAL HIGHWAY ADMINISTRATION ON NOVEMBER 8, 1965 FOR USE ON THIS PROJECT, INCLUDING ALL SUBSEQUENT REVISIONS AND SUCH REVISED SPECIFICATIONS AND SPECIAL PROVISIONS AS ARE INCORPORATED IN THESE PLANS.

REVIEWED BY ORDER OF THE STATE TRANSPORTATION BOARD

APPROVED CHIEF ENGINEER DATE _____

DEPARTMENT OF TRANSPORTATION
FEDERAL HIGHWAY ADMINISTRATION

APPROVED _____ DATE _____
DIVISION ADMINISTRATOR

PROJECT HMA 2849

SHEET 1 OF 7 SHEETS

SHT. 43 OF 64 SHTS



SCALE IN MILES

FOR INDEX OF SHEETS, SEE SHT. 2