
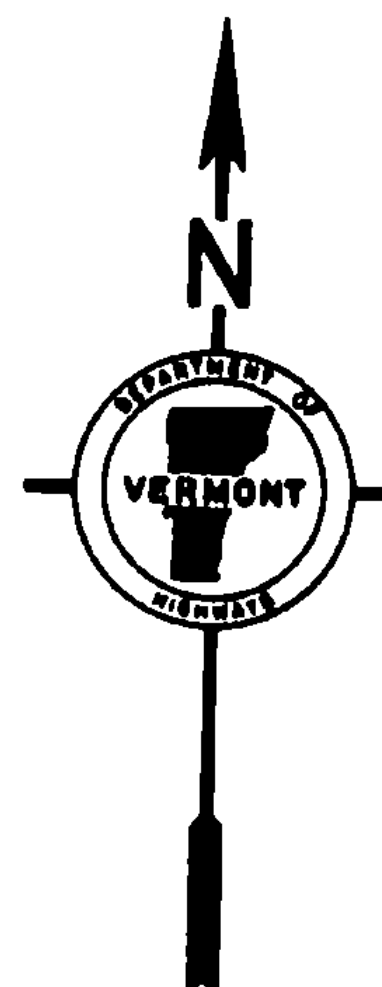


PROJECT DESCRIPTION AND LOCATION

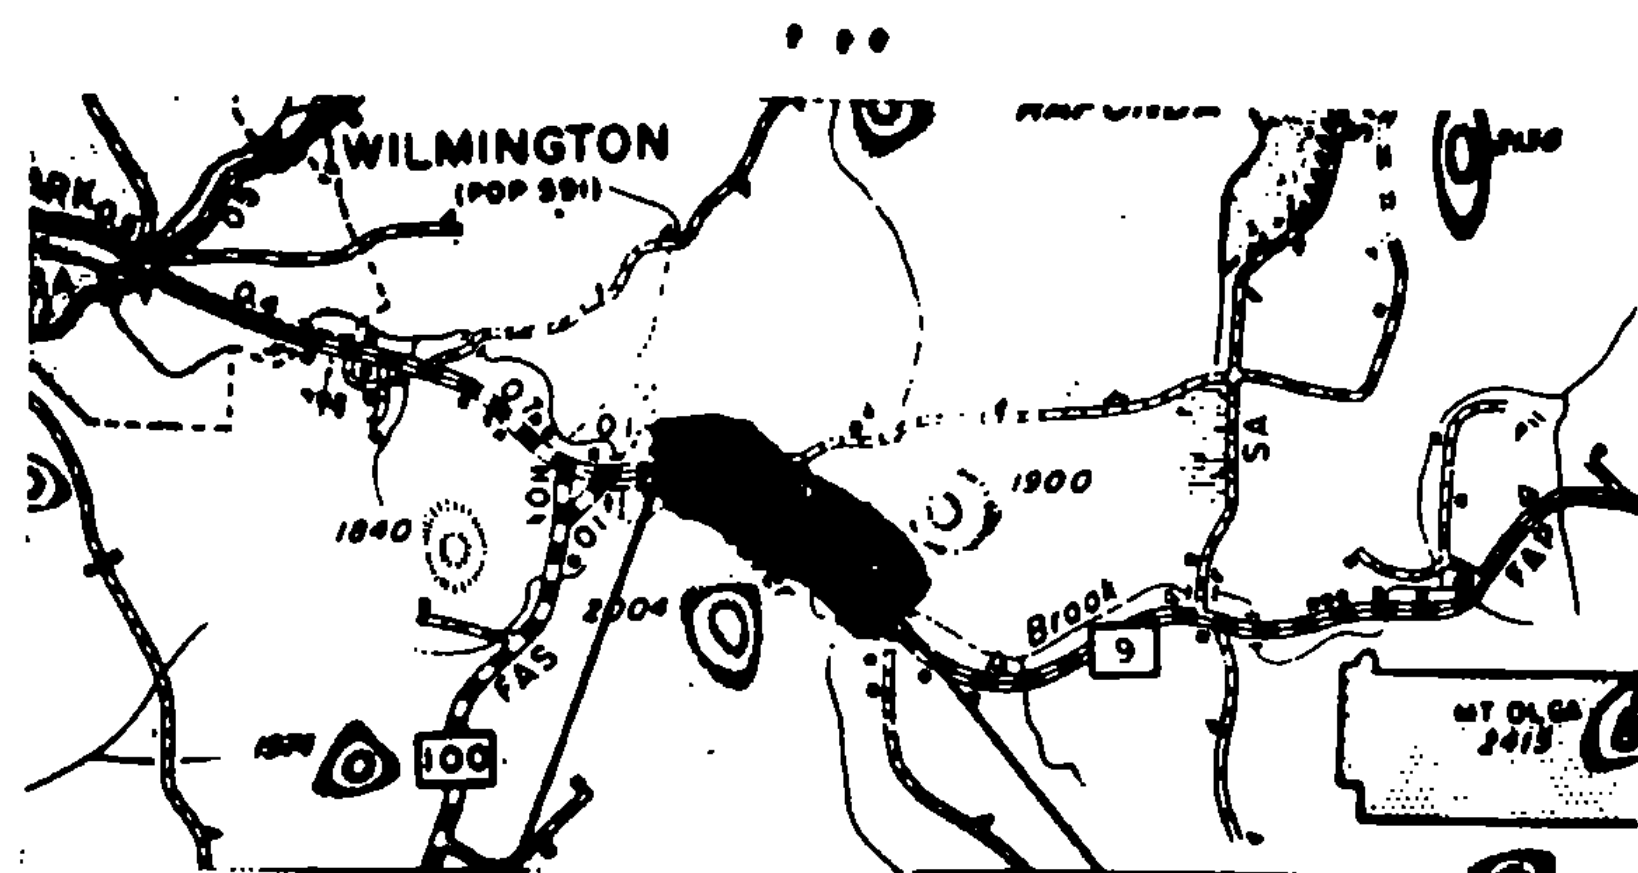

BEGIN PROJECT HMA
WILMINGTON MM 4.500

END PROJECT HMA
WILMINGTON MM 5.157
STOP AT BRIDGE # 36

0 1 2
SCALE IN MILES

TRAFFIC DATA

1986 AADT = 3150

V = 50 MPH

LENGTH OF PROJECT = 0.657 MI
= 3469.00 FT

ON VT. RT. 9, 4.500 MILES EASTERLY OF THE
WILMINGTON - SEARSBURG TOWN LINE, EXTENDING
EASTERLY 0.657 MILES TO WILMINGTON MM 5.157

PROJECT INCLUDES OVERLAYING EXISTING BITUMINOUS CONCRETE
PAVEMENT (SHOULDERS INCLUDED) WITH 1 1/4" BITUMINOUS CONCRETE
PAVEMENT.

PROJECT WILMINGTON

NO. HMA 2849
SHT. 45 OF 64 SHTS
SHT. 3 OF 7 SHTS