

TYPICAL SECTIONS & DESIGN DATA

WILMINGTON 4.500 ~ 5.157

ITEM 406.25 BITUMINOUS CONCRETE PAVEMENT


LEVELING COURSE TYPE IV (518 TONS/MILE)

1/4" WEARING COURSE TYPE III ($\pm 1/4"$)

AS DIRECTED BY THE ENGINEER

NOTE: ROADWAY IS CURRENTLY STRIPED

12' & 1".

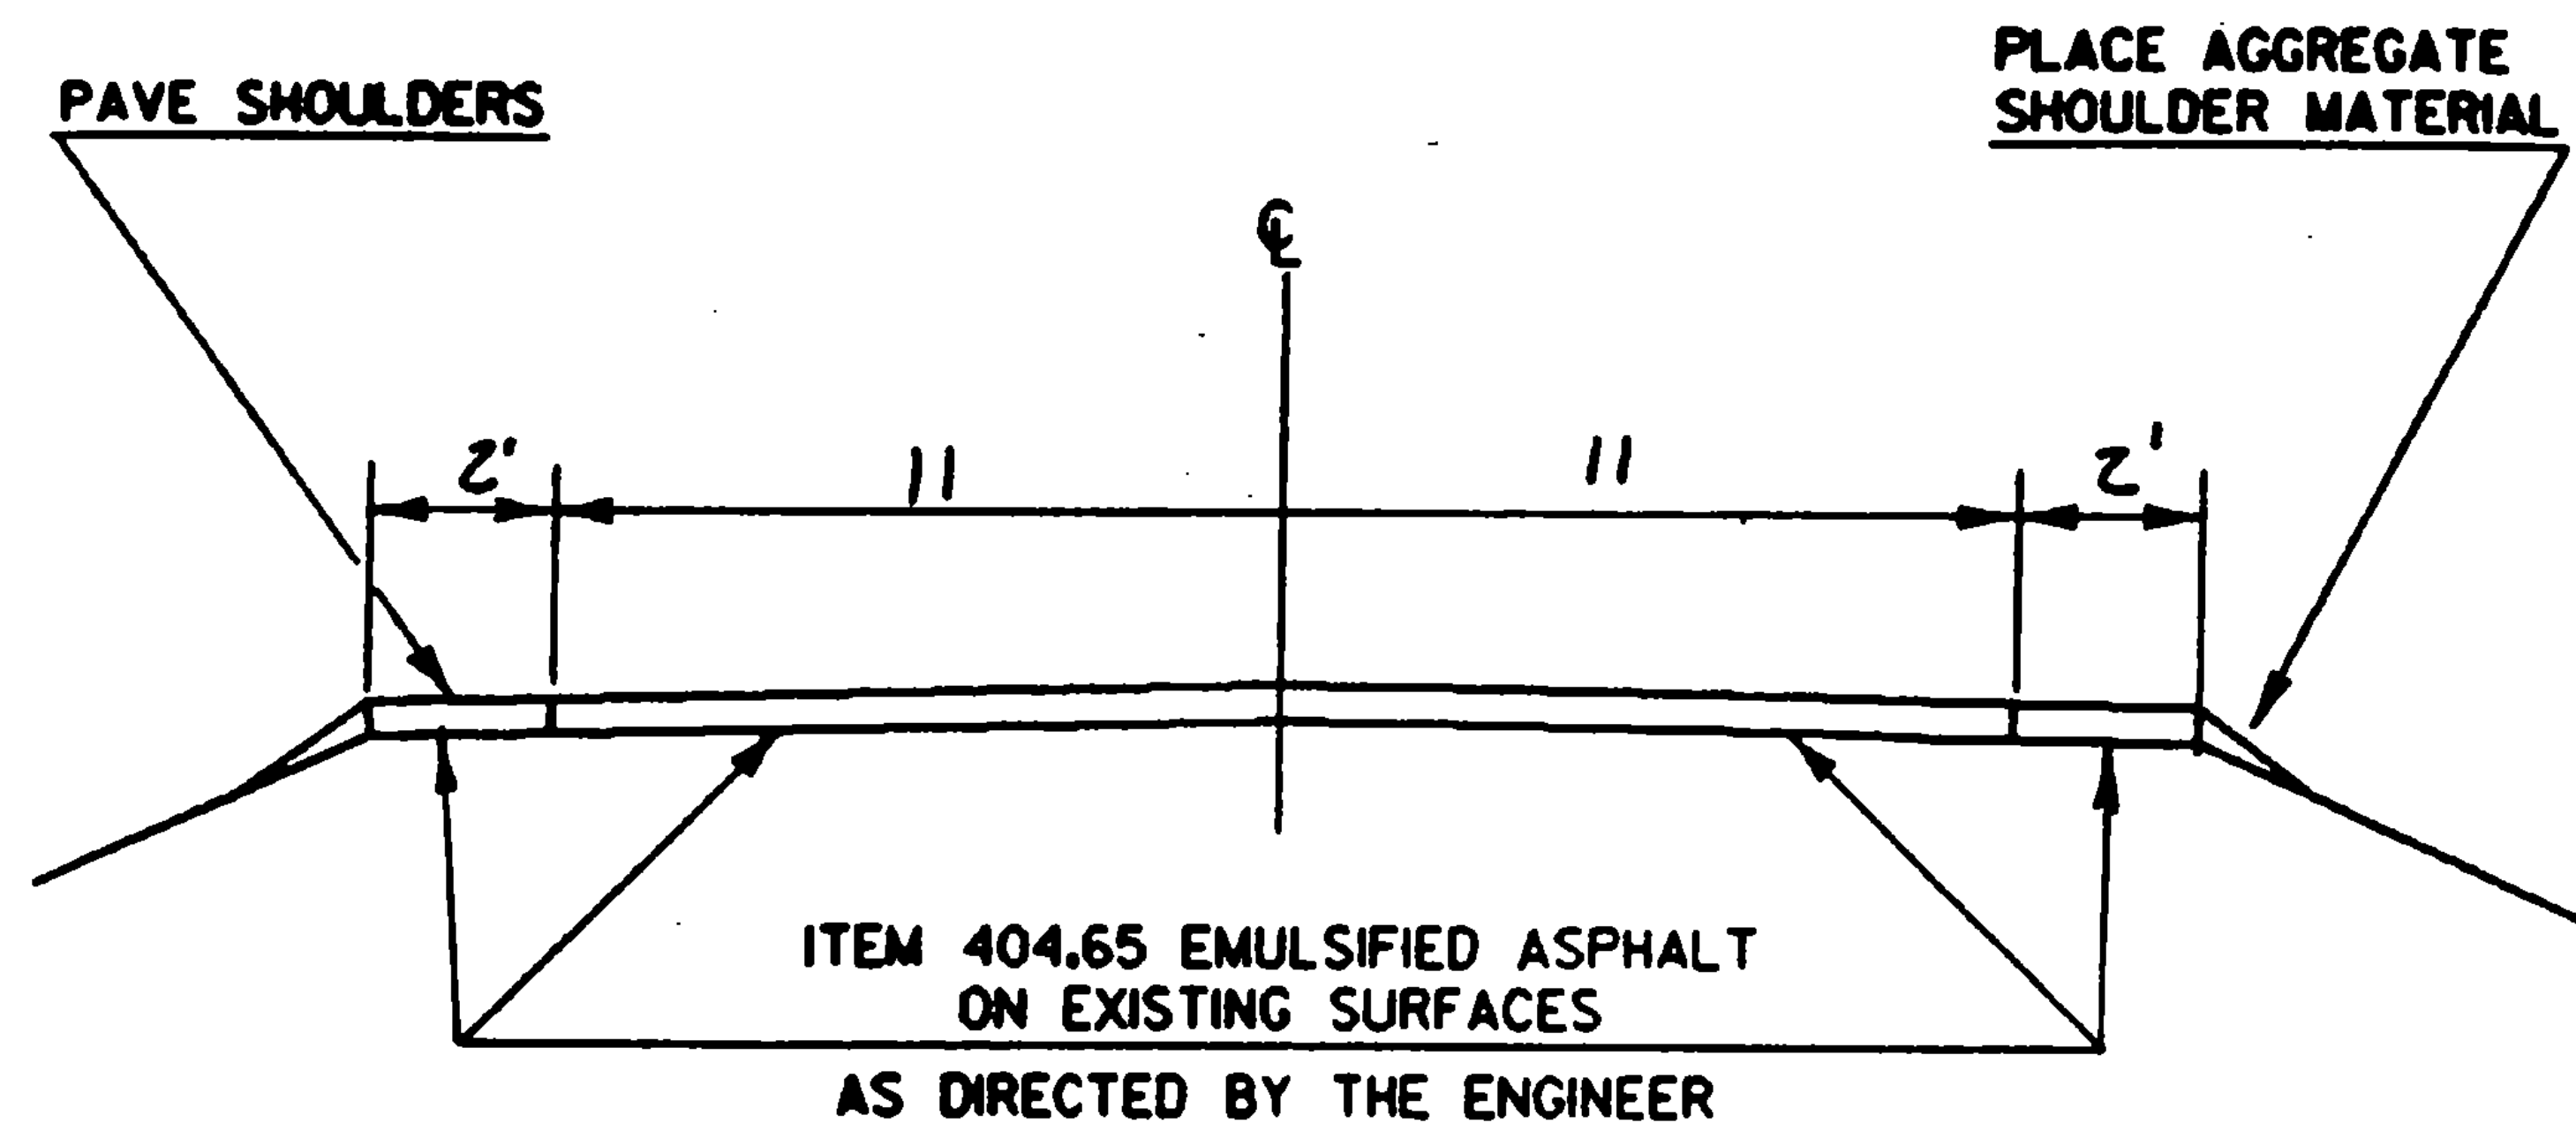

PROJECT WILMINGTON

No. HMA 2849

SHEET 4 OF 7 SHEETS

SHEET 46 OF 64 SHEETS