



TYPICAL SECTIONS & DESIGN DATA

WATERFORD-ST. JOHNSBURY
 HARDWICK-WALDEN
 MORRISTOWN

HMA 2842
 HMA 2820
 HMA 2817

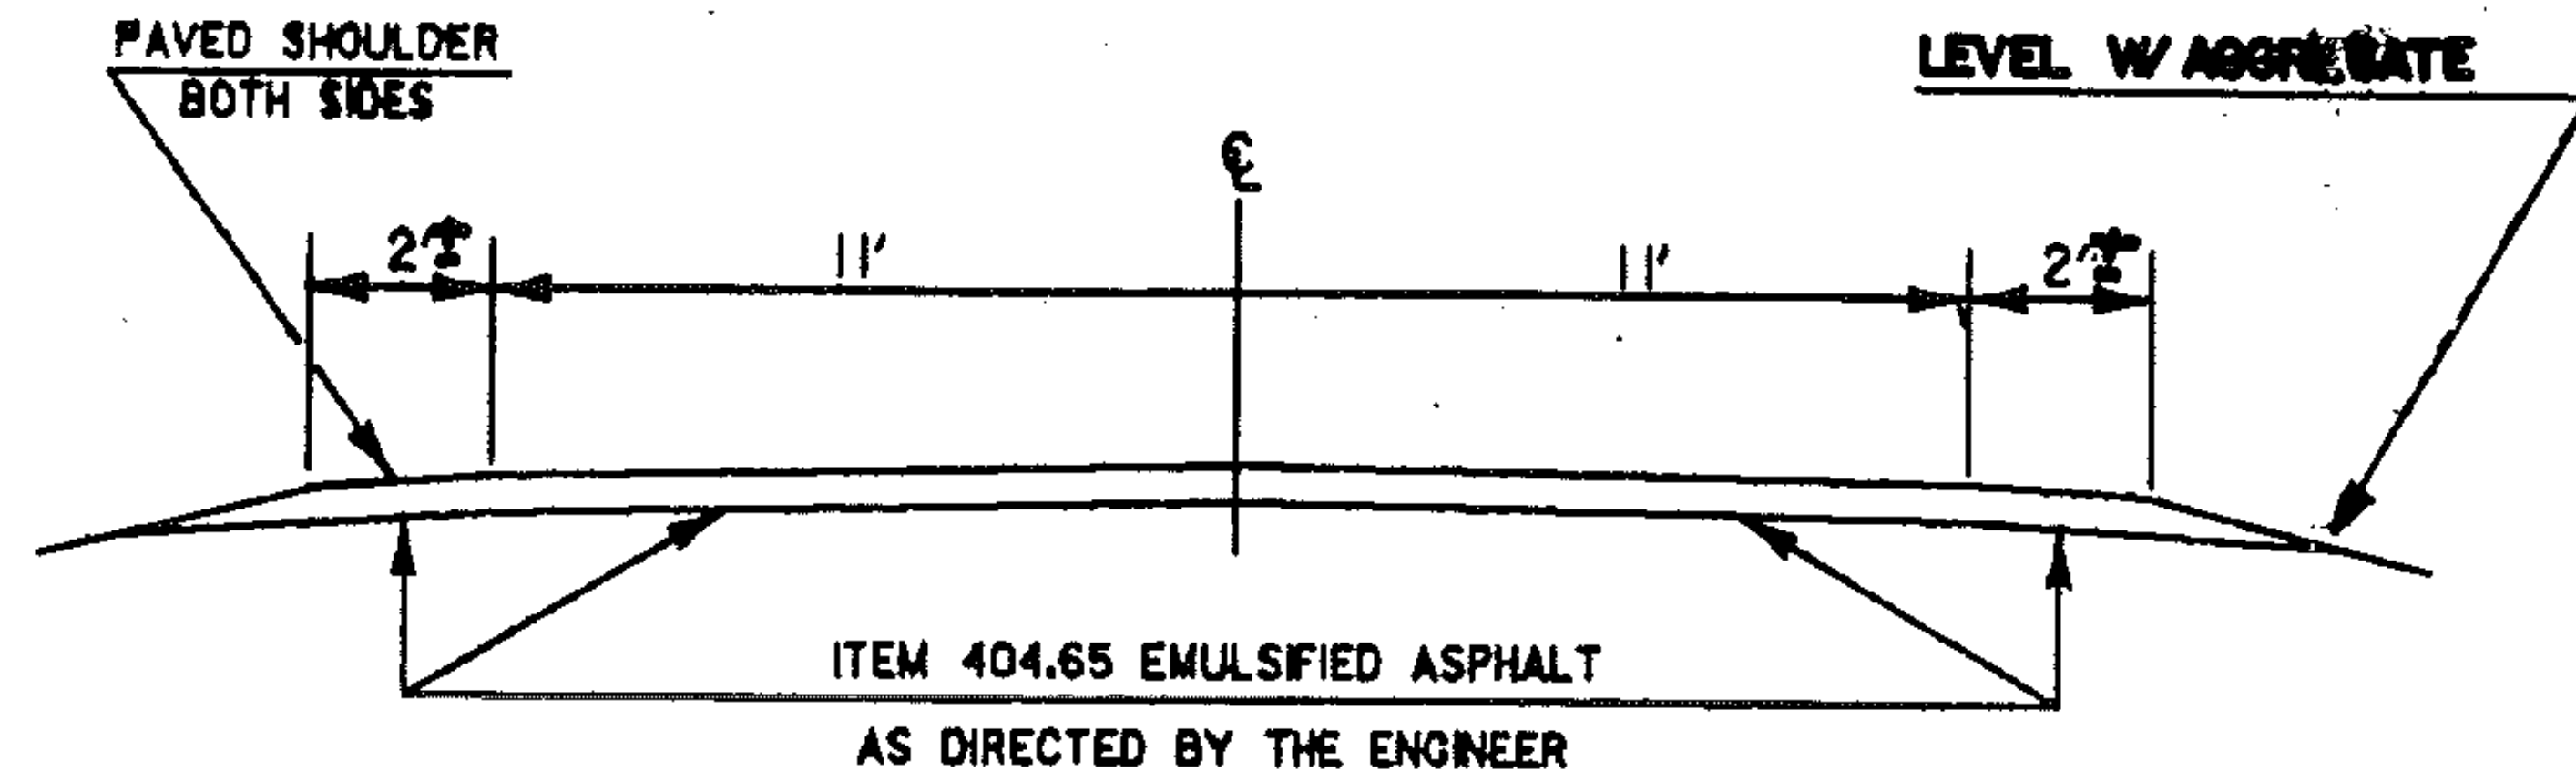

MONTPELIER HMA 2821

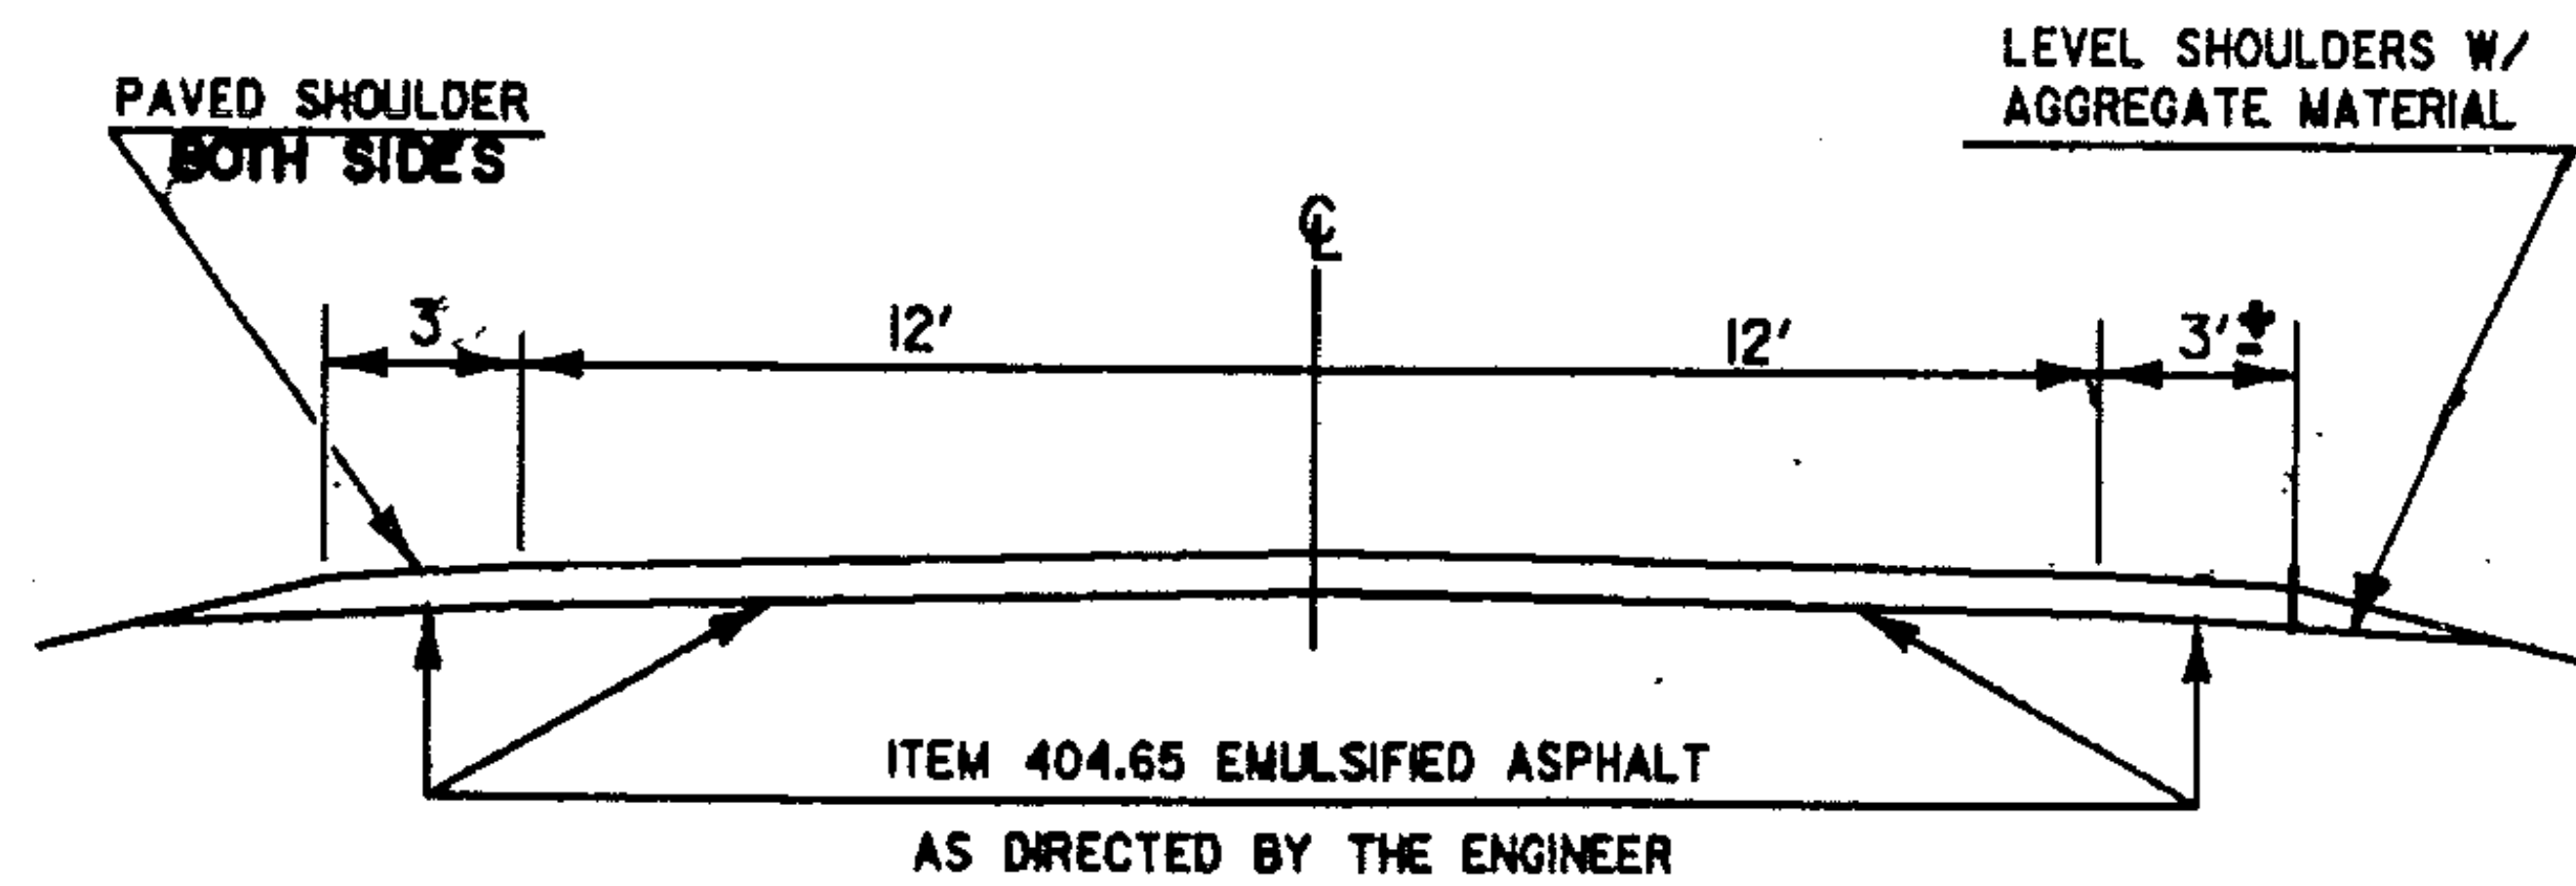

WATERFORD-STJOHNSBURY HMA 2842
 HARDWICK-WALDEN HMA 2820
 MORRISTOWN HMA 2817
 MONTPELIER HMA 2821

PROJECT

SHEET 2A OF 81 SHEETS