



# PAVING LIMITS FOR DRIVES & TOWN ROADS

## PAVING LIMITS FOR TOWN ROADS

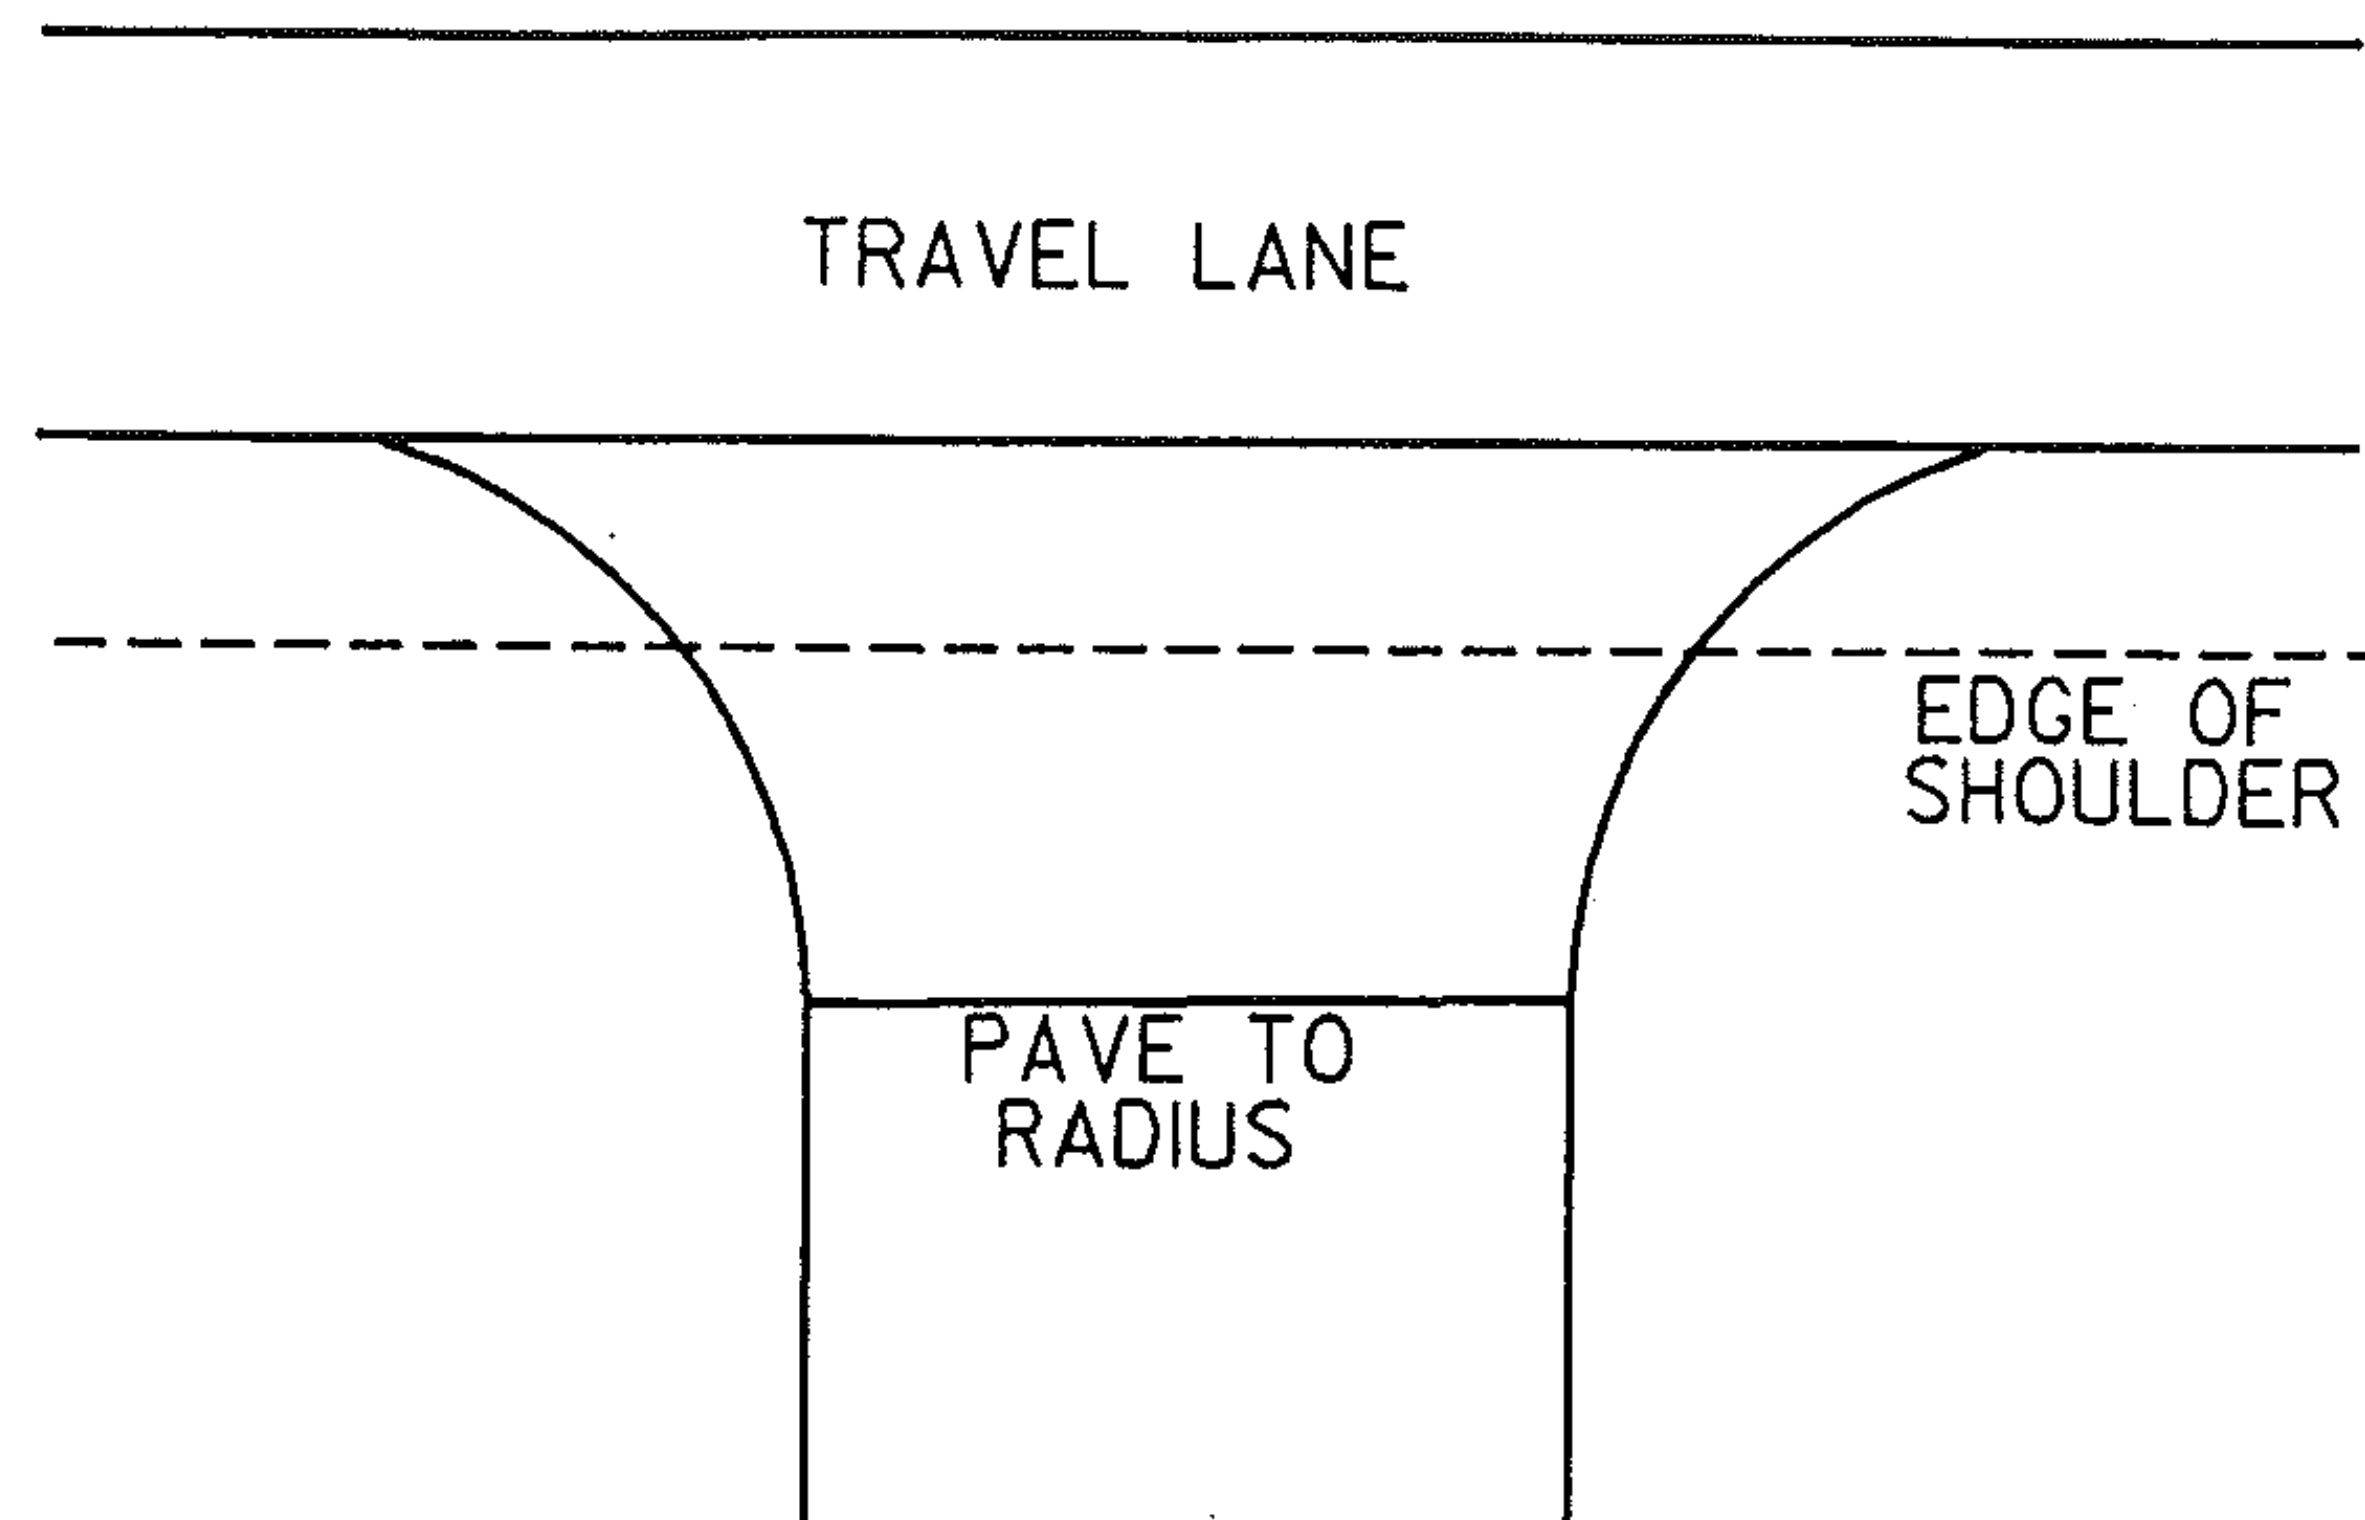

## PAVING LIMITS FOR DRIVES

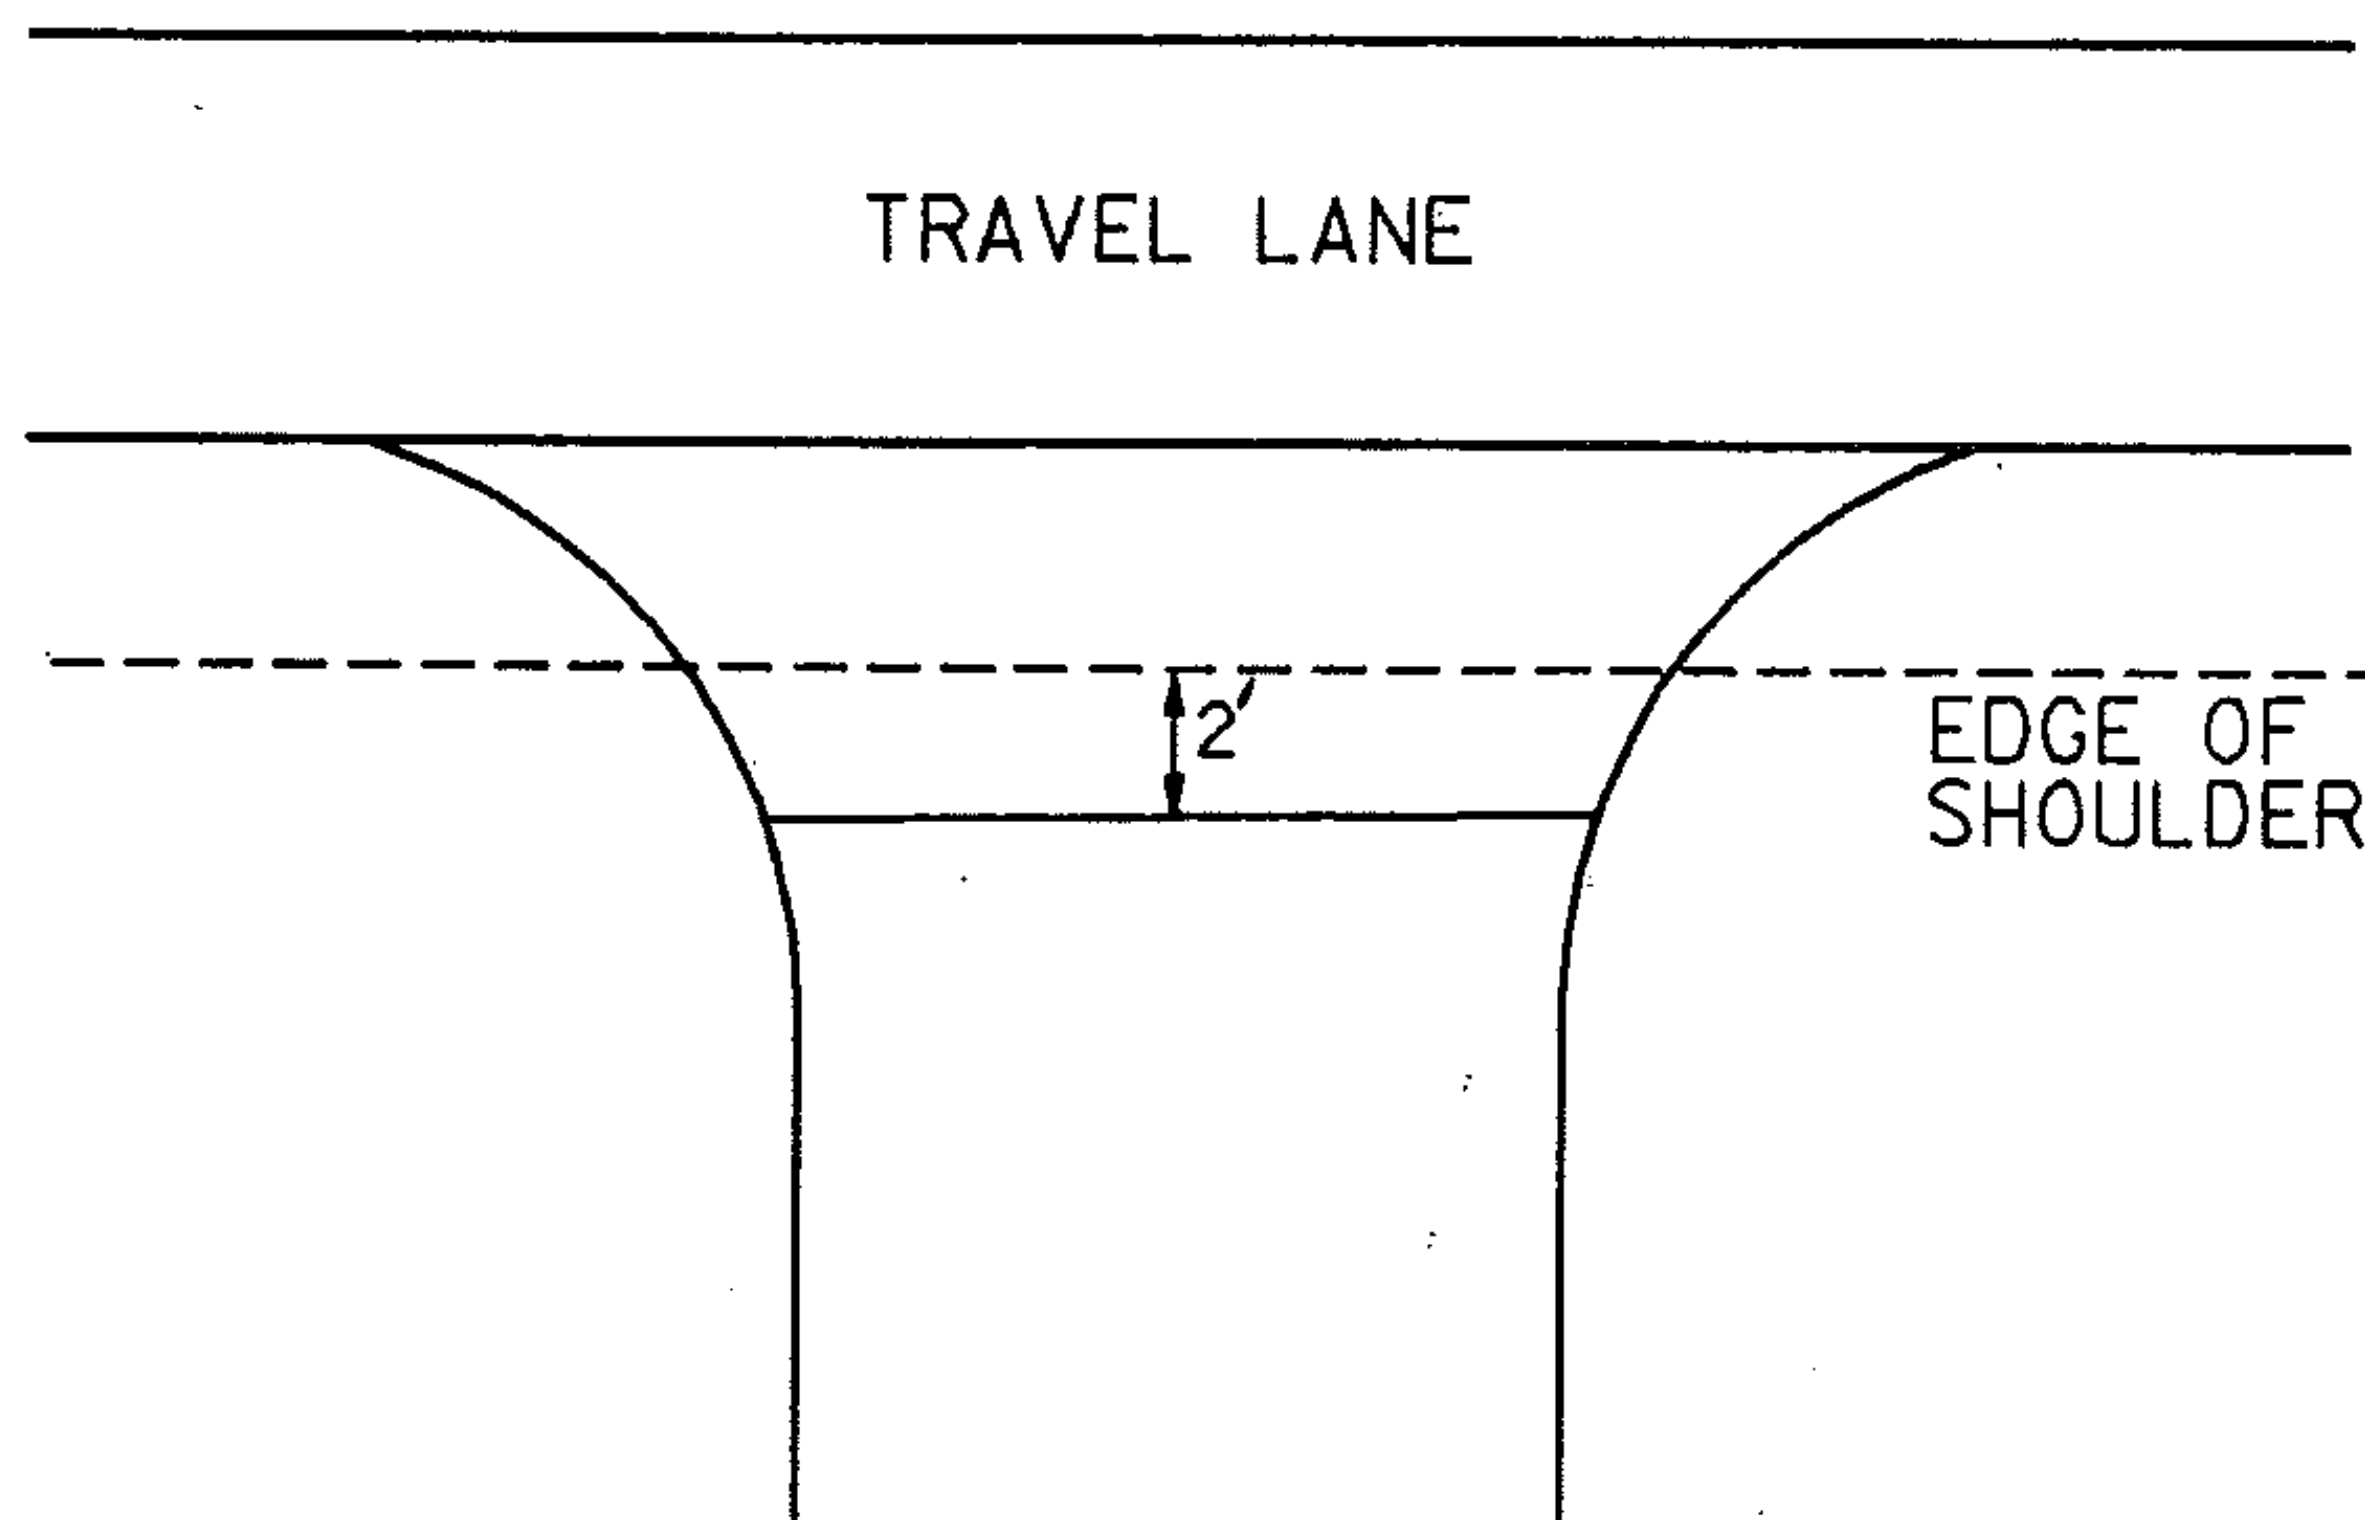

PROJECT Waterford - St. Johnsbury

NO. HMA 2842

SHEET 11 OF 81 SHEETS